


Order Plans

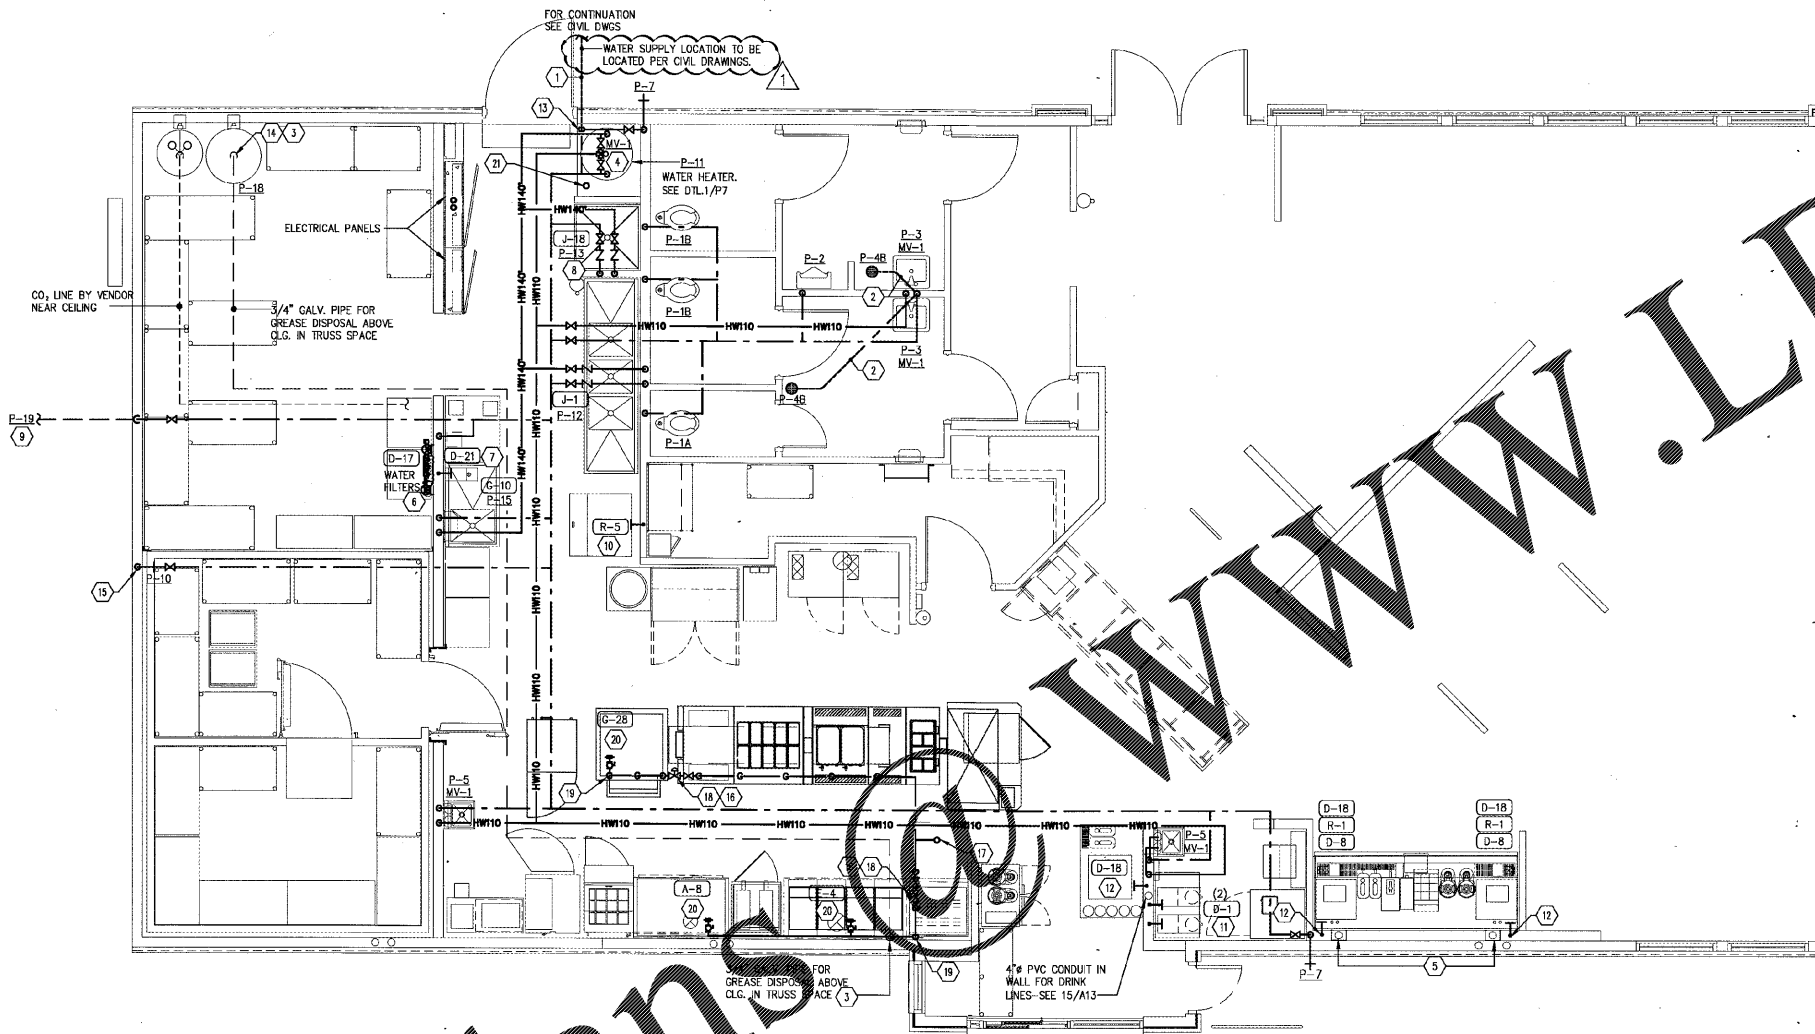

CONSTRUCTION NOTES

- 1 PROVIDE AND INSTALL NEW WATER SERVICE. INQUIRE WITH LOCAL AUTHORITIES TO DETERMINE IF BACKFLOW PREVENTER IS REQUIRED. WHETHER INDOOR METER LOCATION AND AVAILABLE WATER PRESSURE. IF AVAILABLE PRESSURE IS LESS THAN 80 PSIG AT THE BUILDING, CONTACT HARDEE'S CONSTRUCTION REPRESENTATIVE. PROVIDE REMOTE READER. FIELD COORDINATE WITH WATER COMPANY AND SITE CONTRACTOR. COORDINATE LOCATION WITH SITE CONTRACTOR.
- 2 1/2" CW BELOW SLAB FROM TRAP PRIMER TO FLOOR DRAIN.
- 3 INSTALL GREASE TANK (P-18) ACCORDING TO MANUFACTURER'S RECOMMENDATIONS. COORDINATE GREASE TANK INSTALLATION WITH MANUFACTURER. TANK AND ALL RELATED ACCESSORIES PROVIDED AND INSTALLED BY THE PLUMBING CONTRACTOR.
- 4 WATER TEMPERING VALVE (MV-1) SET @ 110°F.
- 5 ROUTE SYRUP BUNDLE DOWN THRU S.S. CHASE IN WALL. SEE 15/A13 FOR MORE DETAILS.
- 6 P.C. TO INSTALL SHUT-OFF VALVE ABOVE CEILING TO MAIN WATER FILTERS FURNISHED W/ BALL VALVE AND LOW PREVENTER - FILTERED WATER CONNECTION BY VENDOR. DRIP SUSP. CLG. SEE DETAIL 19/P7.
- 7 P.C. TO INSTALL IN WALL "DROP" FROM WATER FILTER FOR HOT WATER. SEE DETAIL 19/P7. FILTERED WATER CONNECTION BY VENDOR.
- 8 SEE DETAIL 3/A8 FOR PRE-FAB MOP SINK.
- 9 INSTALL YARD HYDRANT (YH-1) PROVIDED BY OWNER, INSTALLED BY P.C. AT DUMPSTER ENCLOSURE. COORDINATE WITH G.C. AND CIVIL FOR EXACT LOCATION. REFER TO SP-3 FOR INSTALLATION.
- 10 P.C. TO INSTALL IN WALL "DROP" TO BACK ROOM ICE MACHINE FOR FILTERED WATER. SEE DETAIL 19/P7. FILTERED WATER CONNECTION BY VENDOR.
- 11 P.C. TO INSTALL IN WALL "DROPS" TO COFFEE BREWER AND TEA BREWERS FOR FILTERED WATER. SEE DETAIL 19/P7. FILTERED WATER CONNECTION BY VENDOR.
- 12 P.C. TO INSTALL IN WALL "DROP" TO MANIFOLD FOR FILTERED WATER. SEE DETAIL 19/P7. FILTERED WATER CONNECTION BY VENDOR.
- 13 MAIN DOMESTIC WATER SERVICE ENTRY LOCATION WITH MAIN SHUT-OFF VALVE IN AN ACCESSIBLE LOCATION.
- 14 OUTLET AND VACUUM LINE FOR GREASE TANK. MOUNT AT 4' A.F.G. INSTALL PER MANUFACTURER'S RECOMMENDATIONS.
- 15 EXTEND WATER LINE UP FOR A ROOF MOUNTED YARD HYDRANT. HYDRANT TO BE FREEZELESS. CONTRACTOR TO DESIGN SUPPORT AND SUBMIT WITH SHOP DRAWINGS. FIELD COORDINATE WITH GENERAL CONTRACTOR. ROOFING BY GENERAL CONTRACTOR. RUN DRAINAGE LINE TO DISCHARGE INTO MOP SINK.
- 16 INSTALL ANSUL SUPPLIED GAS SHUT OFF VALVE. VALVE PROVIDED WITH HOOD ANSUL SYSTEM PACKAGE. FIELD COORDINATE. MOUNT BELOW CEILING.
- 17 GAS PIPING ROOF PENETRATION FOR COOKING EQUIPMENT BELOW. SEE SHEET P4 FOR CONTINUATION AND SHEET P6 FOR SIZING.
- 18 ELECTRIC GAS VALVE FURNISHED BY HOOD MANUFACTURER AND INSTALLED BY PLUMBING CONTRACTOR. ELECTRIC CONNECTIONS BY ELECTRICAL CONTRACTOR.
- 19 GAS LINE TO BE DROPPED FROM CEILING DOWN TO COOKING EQUIPMENT.
- 20 PROVIDE AND INSTALL GAS CONNECTIONS TO EQUIPMENT PER MANUFACTURER'S RECOMMENDATIONS. PROVIDE 6" DIRT LEG, UNION, GAS COCK BEFORE QUICK DISCONNECT FOR ALL GAS FIRED EQUIPMENT.
- 21 GAS PIPING ROOF PENETRATION FOR WATER HEATER BELOW. SEE SHEET P4 FOR CONTINUATION AND SHEET P6 FOR SIZING.

NRD Project # 16399

NRD
 ARCHITECTS & ENGINEERS
 3005 CARRINGTON MILL BLVD. SUITE 105
 MORRISVILLE, NORTH CAROLINA 27660
 PH: 919 544 7251 FAX: 919 544 9399
 A Division of LMHT Associates

REGISTERED PROFESSIONAL ENGINEER
 STATE OF NORTH CAROLINA
 LICENSE NO. 40273
 HARDEE'S ASSOCIATES, P.A.
 145 CHURCH STREET
 BATESBURG-LEESVILLE, SOUTH CAROLINA 29004

Hardee's
 HARDEE'S TAKE PROTOTYPE
 145 CHURCH STREET
 BATESBURG-LEESVILLE, SOUTH CAROLINA 29004

NO.	REVISIONS	DATE
1	COORDINATION	5/27/2017

PLUMBING	CHECKED BY: JCL	CHECKED BY: SJS	APPROVED BY: NRT
WATER SUPPLY			
PLAN			

CKE SITE ID.:
 DATE: 2-28-17

SHEET NUMBER:
P3