


CHAMPIONS GATE BOULEVARD

Order Plans
RONALD REAGAN PARKWAY (COUNTY ROAD 54)

ARCHITECTURAL SITE PLAN 1/16" = 1'-0"

INV. ELEV. = 122.00

MATCH LINE

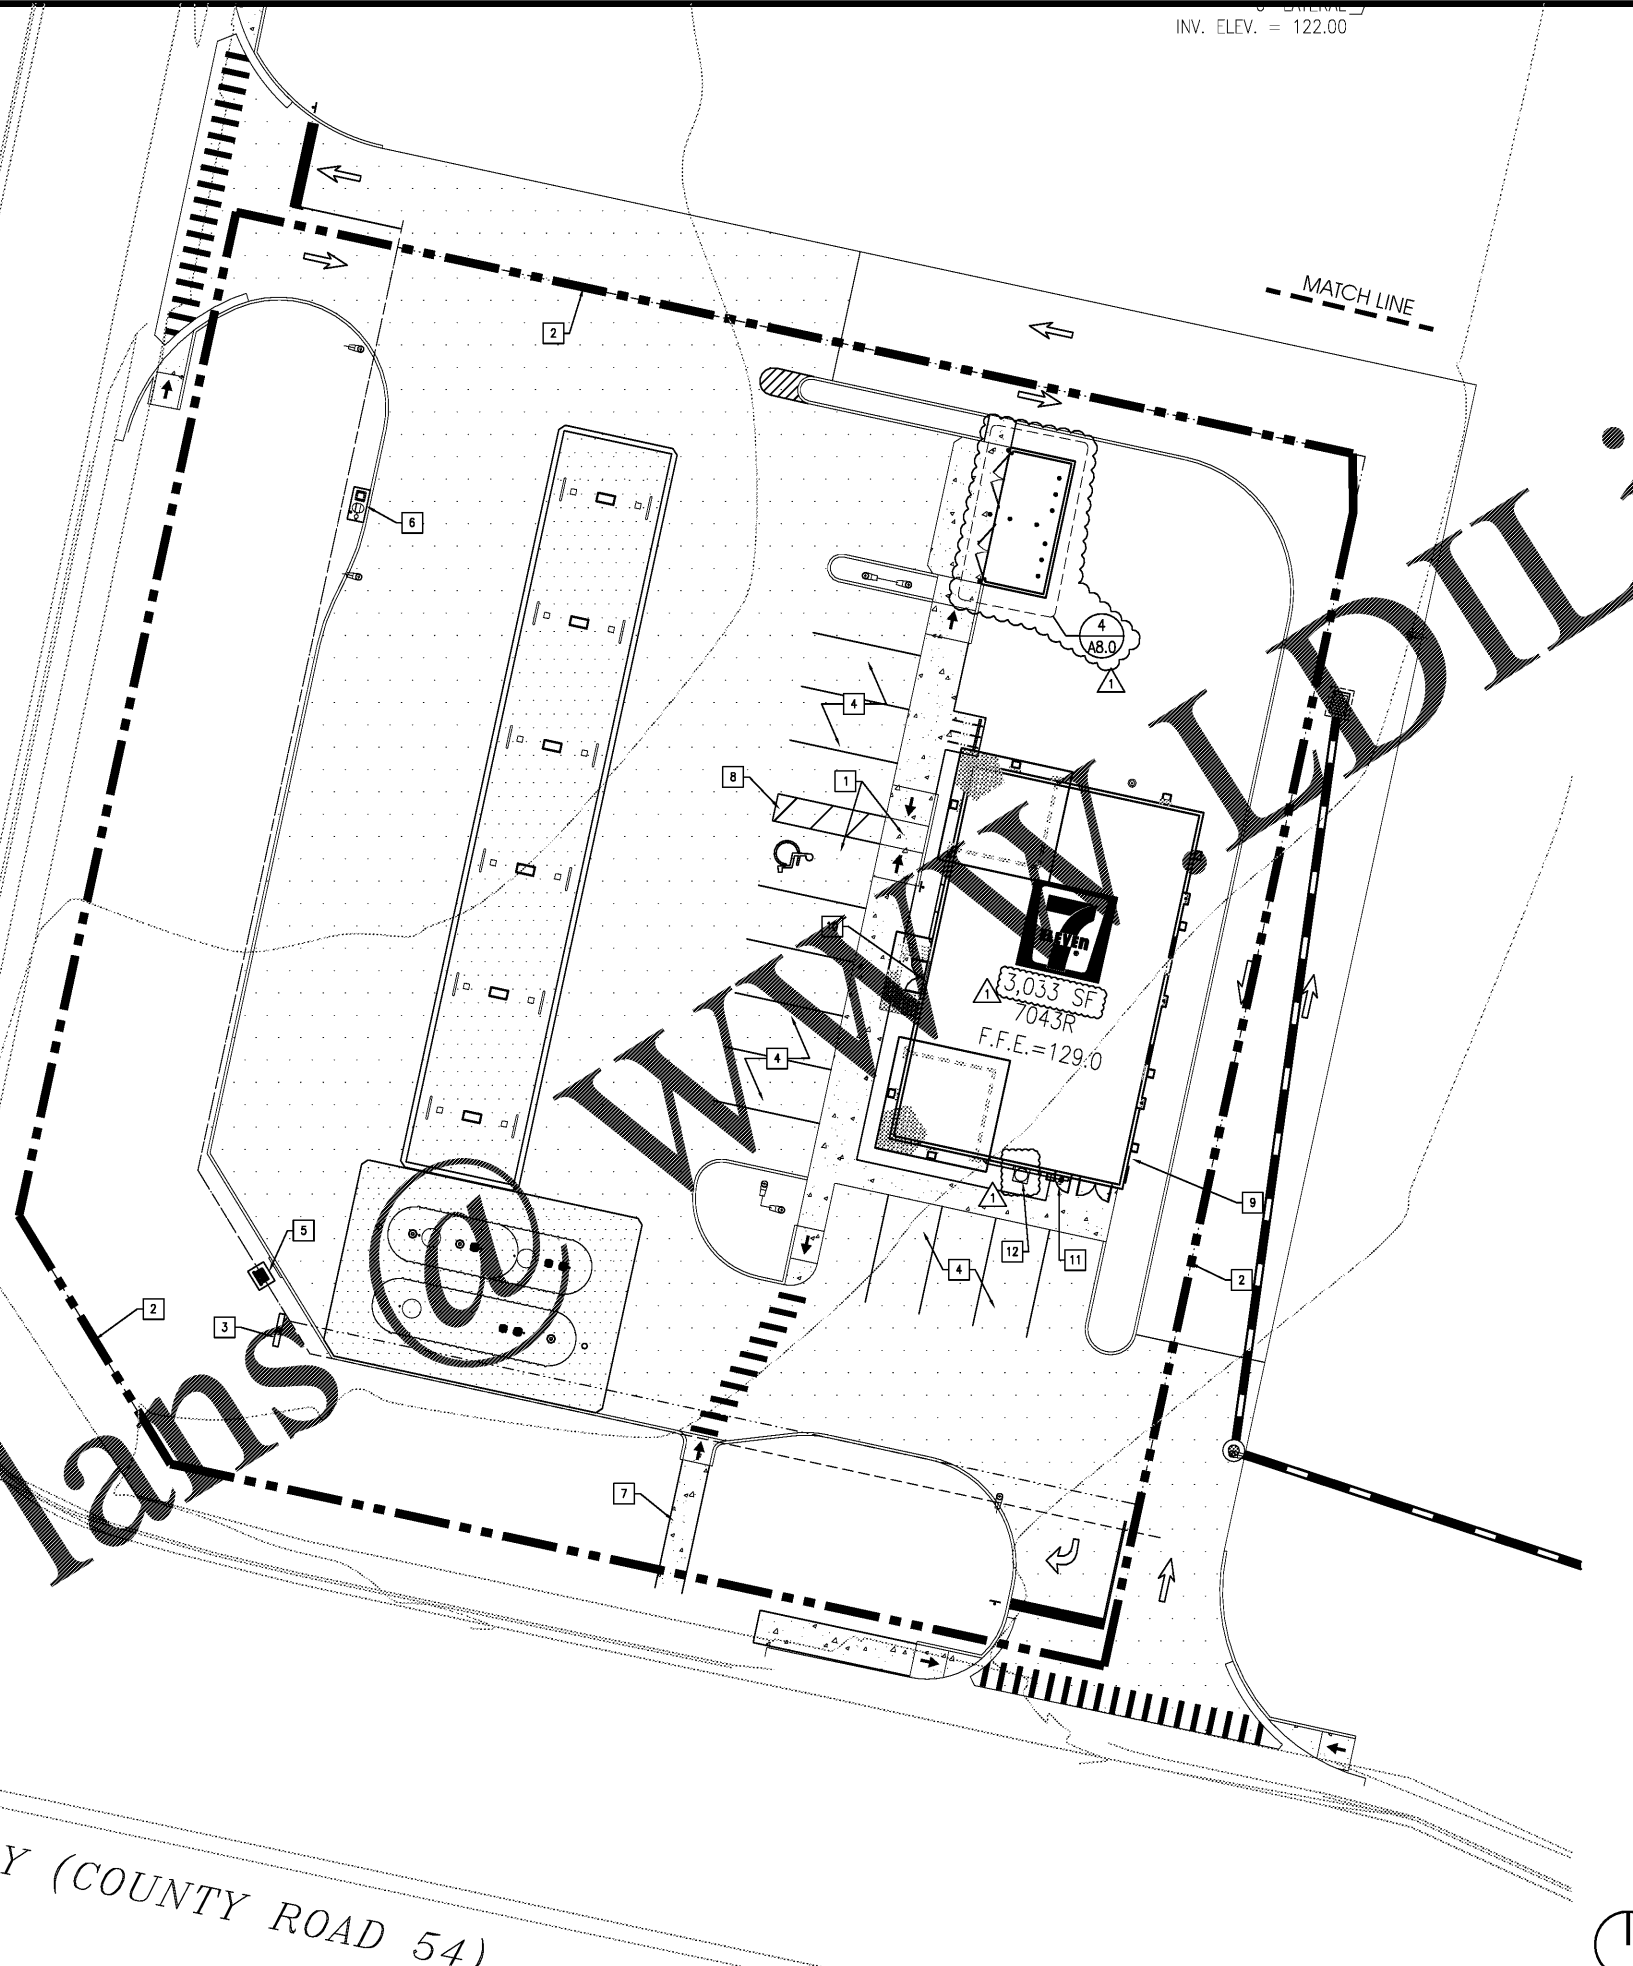

GENERAL NOTES

A. COLUMN WRAP CAN VARY. REFERENCE CITY APPROVED ELEVATIONS AND FUEL DRAWINGS FOR MATERIALS. ADJUST DETAILS AS REQUIRED.

KEY NOTES

1. HANDICAP STALL AND RAMP; REF CIVIL SHEETS.
2. PROPERTY LINE; REF CIVIL SHEETS.
3. MONUMENT SIGNAGE, UNDER SEPARATE PERMIT.
4. PARKING, REF CIVIL SHEETS
5. FUEL VENTS; REF CIVIL SHEETS FOR LOCATION.
6. AIR/VAC; REF CIVIL SHEETS FOR LOCATION.
7. ACCESSIBLE PEDESTRIAN PUBLIC RIGHT OF WAY SITE ACCESS; REF CIVIL SHEETS.
8. ACCESSIBLE PATH OF TRAVEL FOR DISABLED ACCESSIBLE PARKING STALL AND PUBLIC WAY TO PUBLIC ENTRANCE.
9. ELECTRICAL PANELS; REF ELECTRICAL SHEETS
10. MAIN ENTRY DOOR.
11. EXIT DOOR.
12. CO2 TANK/CAGE INSTALLED/ANCHOR PER MANUFACTURER SPECS BY GC. REF A3.0. PROVIDE SHUT OFF WHERE CO2 SUPPLY LINES PENETRATE THE BUILDING. LABEL PROVIDED BY NUOCO2.

INTERPLAN
 ARCHITECTURE
 ENGINEERING
 INTERIOR DESIGN
 PROJECT MANAGEMENT
 AA 003420
 CA 8660
 604 COURTLAND STREET
 SUITE 100
 ORLANDO, FLORIDA 32804
 PH 407.645.5008
 FX 407.629.9124

SEAL:

NO.	DATE	REVISIONS
1	05/21/17	PEER REVIEW COMMENTS



BID SET
JANUARY 8, 2018

7-ELEVEN
STORE #32810

5544 RONALD REAGAN PARKWAY
DAVENPORT, FL
33896

PROJECT NO: 2016.0305
DATE: MAY 31, 2017

A0.3
ARCHITECTURAL SITE PLAN

CHECKED: RW DRAWN: JUM

COPYRIGHT © 2016 INTERPLAN, LLC. REVISIONS, CHANGES OR ASSIGNMENTS ARE PROHIBITED.