


SEAL:

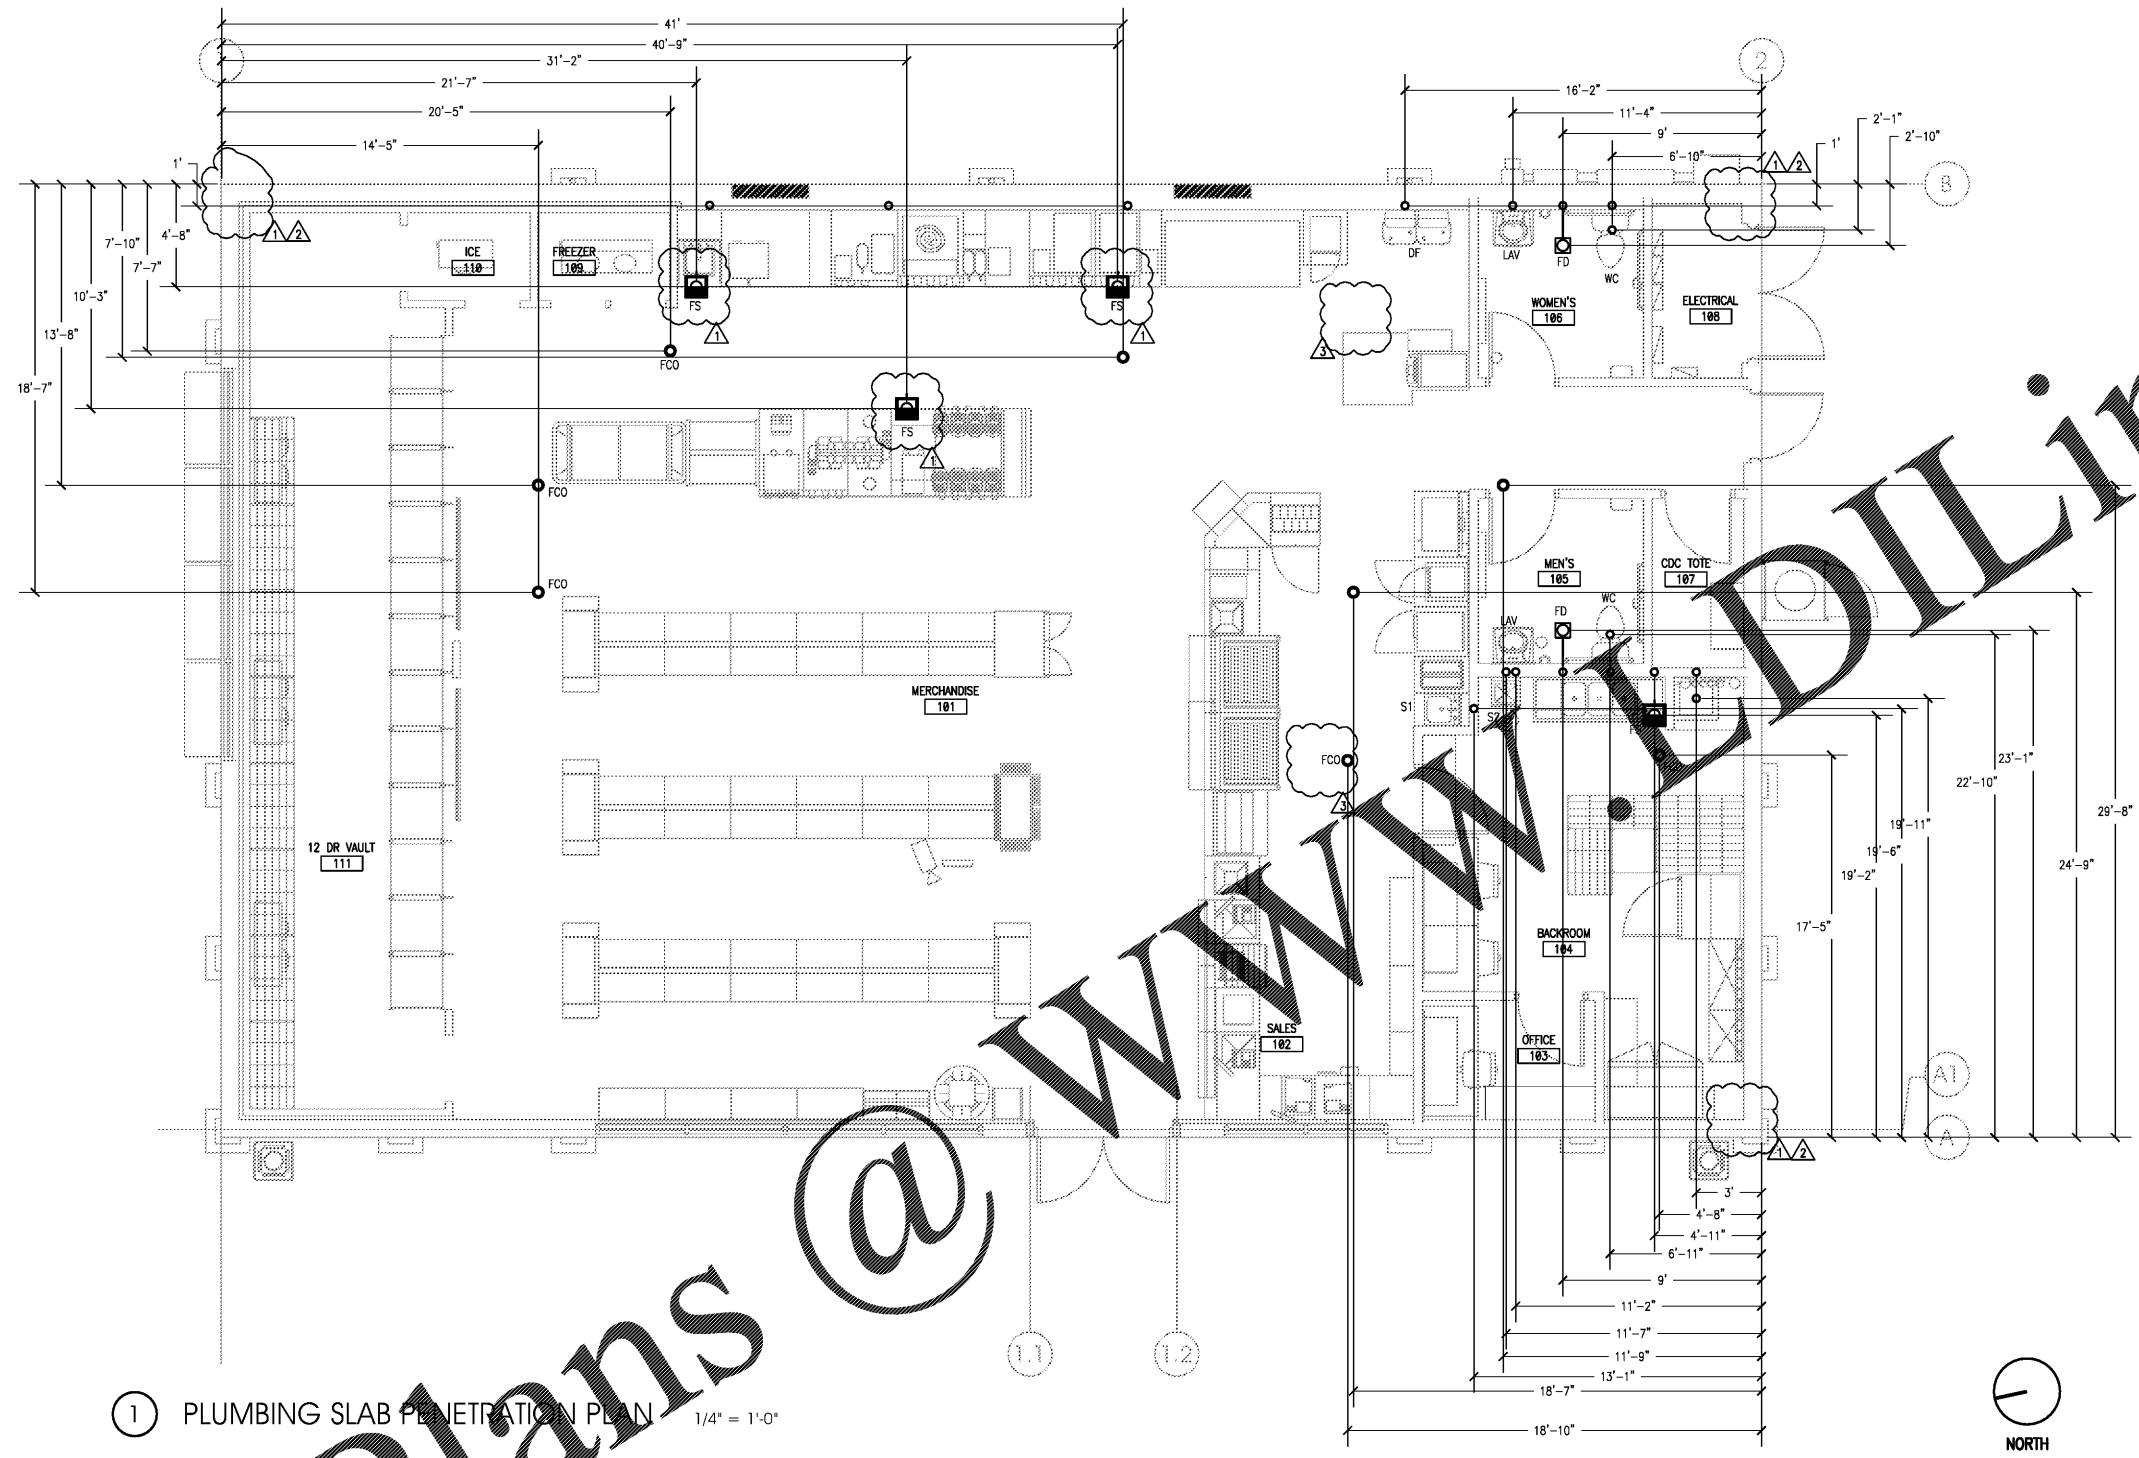

① PLUMBING SLAB PENETRATION PLAN 1/4" = 1'-0"

NO.	DATE	REVISIONS
4	11.09.17	UTIL COORD CHANGES
3	08.24.17	BUILDING DEP. COMMENTS
2	07.07.17	PEER REVIEW COMMENTS
1	06.21.17	PEER REVIEW COMMENTS

NO. DATE REMARKS

REVISIONS



BID SET
JANUARY 8, 2018

7-ELEVEN
STORE #32810

5544 RONALD REAGAN PARKWAY
DAVENPORT, FL
33896

PROJECT NO: 2016.0305
DATE: MAY 31, 2017

P1.2
PLUMBING SLAB
PENETRATION PLAN

CHECKED: PD DRAWN: MM

Order Plans @ WWW.DLine.com

COPYRIGHT © 2016 INTERPLAN, LLC. REVISIONS, CHANGES OR ASSIGNMENTS ARE PROHIBITED.