



RECEIVED
 11 03 2017
 173 E. UNIVERSITY
 SPRINGFIELD, MISSOURI

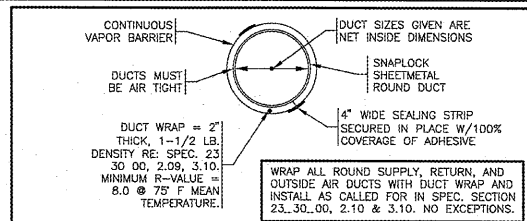

ROUND DUCT WRAP INSULATION

N.T.S.


M1

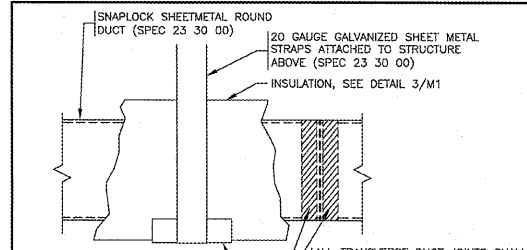

ROUND DUCT INSULATION HANGER SHIELD

N.T.S.

M1

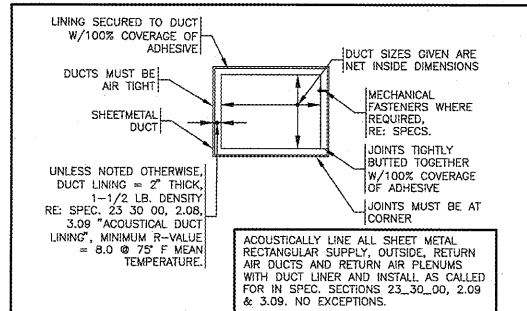

RECTANGULAR DUCT LINER INSULATION

N.T.S.

M1

HVAC OUTDOOR AIR REQUIREMENTS

MECHANICAL CODE REFERENCE:
 FOR REQUIRED OUTDOOR VENTILATION AIR IN RETAIL - "SALES/STORAGE ROOM"

1. SHOWROOM =	3068 SQUARE FEET
2. HARD PARTS =	4155 SQUARE FEET

SHOWROOM (SALES)

3068 (SQUARE FEET) ÷ 1000 (SQUARE FEET) =	3.068
3.068 x 15 (PERSONS/1000 SQUARE FEET) =	47 PERSONS
(CFM/ PERSON x PERSONS) + (CFM/SQUARE FEET x SQUARE FEET) =	CFM
(7.5 x 47) + (.12 x 3068) =	720.66 CFM OF OUTSIDE AIR REQUIRED
720.66 ÷ .8 (EFFECTIVENESS) =	901 CFM

HARD PARTS (STORAGE ROOM)

3791 x .12 (CFM/SQUARE FEET) =	454.92 CFM OF OUTSIDE AIR REQUIRED
454.92 ÷ .8 (EFFECTIVENESS) =	568.65 CFM
901 CFM + 568 CFM =	1470 TOTAL CFM

TOTAL OUTSIDE AIR MINIMUM REQUIRED BY CODE: 1470 CFM
 OUTSIDE AIR SPECIFIED ON PLAN SHEET M1: 1500 CFM

HVAC SYSTEMS TESTING & BALANCING

THE HVAC SYSTEM SHALL BE TESTED AND BALANCED (T&B) BY THE CONTRACTOR PER SPEC SECTION: 23_05_93 AND IN ACCORDANCE WITH THE PROCEDURES OF AABC OR NEBB. CONTRACTOR SHALL SUBMIT WRITTEN T&B REPORTS TO THE OWNER. SINCE THIS O'REILLY STORE IS LESS THAN 50,000 SQ. FT. THEN SYSTEM COMMISSIONING IS NOT REQUIRED PER ASHRAE 90.1.

HVAC - KEYNOTES

1. THERMOSTATS. (TYPICAL WIRING FOR EACH THERMOSTAT) SEE VS1 SHEET
2. 12"x12" DUCT W/ ELBOW FROM "R2" TO JUST ABOVE THE CEILING PLATFORM.
3. WALL CAP 500 CFM EXHAUST. ARCHITECTURAL ELEVATIONS SHOW DIMENSIONED LOCATION.

HVAC ROOF BRACING CONFLICTS

CONTRACTOR TO FIELD VERIFY ROOF'S HORIZONTAL ROD BRACING LOCATIONS. IF NECESSARY, SHIFT RTU'S AND DUCTS AS REQUIRED TO AVOID CONFLICT WITH BRACING.

OUTSIDE AIR SETUP:

CONTRACTOR TO SET DAMPERS AS FOLLOWS:
 ECONOMIZER MODE MAXIMUM CFM PER UNIT 2.6 TON RTU = 3,000
 MINIMUM OUTSIDE AIR CFM PER RTU (TYPICAL) = 500 DURING OCCUPIED HOURS ONLY.

HVAC GENERAL NOTES

1. DRAWING IS DIAGRAMMATIC AND IS NOT TO BE SCALED. REFER TO ARCHITECTURAL PLANS OR FIELD MEASUREMENTS FOR DIMENSIONS.
2. ALL WORK IS TO BE PERFORMED IN ACCORDANCE WITH THE APPLICABLE CODE(S) NOTED ON THE COVER SHEET.
3. THE CONTRACTOR SHALL FIELD VERIFY ALL EXISTING CONSTRUCTION PRIOR TO SUBMITTING HIS BID. NO EXTRAS WILL BE PAID DUE TO UNANTICIPATED EXISTING CONDITIONS.
4. ALL ROOF AND WALL PENETRATIONS REQUIRED SHALL BE COORDINATED WITH THE GENERAL CONTRACTOR. PROVIDE ALL SLEEVES, FLASHING, CURBS, REINFORCING ANGLES, SUPPORTING FRAMES, ETC., WHICH ARE REQUIRED UNLESS THEY ARE SPECIFICALLY CALLED OUT TO BE FURNISHED BY OTHERS.
5. A SUBMITTAL OF ALL MATERIALS AND EQUIPMENT PROPOSED TO BE USED ON THE JOB SHALL BE PREPARED AS SOON AS POSSIBLE AFTER AWARD OF THE CONTRACT. THE SUBMITTAL WILL BE REVIEWED BY THE OWNER FOR EQUAL QUALITY AND PERFORMANCE TO THE ITEMS SPECIFIED. ALL CONTROL DEVICES SHALL BE INCLUDED IN THE SUBMITTAL.
6. THE PROPER PERFORMANCE OF THE CONTROL SYSTEM IS THE RESPONSIBILITY OF THE CONTRACTOR.
7. THE CONTRACTOR SHALL COOPERATE AND COORDINATE HIS WORK WITH THE WORK OF OTHER SUBCONTRACTORS OF THE PROJECT. COORDINATION DOES NOT MEAN "I WAS HERE FIRST".
8. THE CONTRACTOR SHALL BE RESPONSIBLE FOR INSTALLING A COMPLETE AND FUNCTIONAL SYSTEM IN ACCORDANCE WITH THE INTENT OF THE PLANS, WHETHER OR NOT EVERY ELEMENT THEREOF IS SPECIFICALLY CALLED OUT.
9. DUCT DIMENSIONS ON PLANS ARE TO BE FINISHED INSIDE DIMENSIONS.
10. DUCT MATERIALS SHALL BE AS FOLLOWS:
 ROUND SUPPLY AIR DUCT (SPEC 23 30 00)
 RECTANGULAR SUPPLY AND RETURN AIR DUCT WORK - (SPEC 23 30 00) INSTALL TURNING VANES IN ALL ELBOWS. DO NOT SUBSTITUTE RADIIUSED ELBOWS. BUNGLETS TO DIFFUSERS - (SPEC 23 30 00) (SEE DIFFUSER INSTALLATION DETAIL).
 EXHAUST DUCT - (SPEC 23 30 00)
 TRANSITIONS - SHALL CONFORM TO SMACNA STANDARDS.
11. INSULATE HVAC CONDENSATE DRAIN PIPING WITH 1/2" ARMAFLEX.
12. ALL WORK IS TO BE GUARANTEED FOR ONE YEAR UPON OCCUPANCY.
13. NO EQUIPMENT OR FIXTURE SUBSTITUTIONS (THAT ARE NOT CURRENTLY LISTED) WITHOUT PRIOR WRITTEN APPROVAL OF THE OWNER.
14. UPON COMPLETION BALANCE SYSTEMS TO AIR FLOWS SHOWN. REPORT THE BALANCING MEASUREMENTS ON THE "AS BUILT" DRAWINGS. REPORT THE AMOUNT OF DUST OR DEBRIS WHICH MAY COLLECT IN THE SYSTEM AS POSSIBLE.
15. MOUNT CONDENSATE AND REFRIGERANT LINES AS HIGH AS POSSIBLE.
16. CONTROL WIRING BY HVAC CONTRACTOR, FINAL CONNECTIONS BY HVAC CONTRACTOR.
17. ALL CAULKING ON BUILDING PENETRATIONS SHALL BE A ONE-COMPONENT NON-SAG URETHANE ELASTOMERIC SEALANT. ANY CONTRACTOR WHO USED SILICONE OR ANY OTHER CAULKING WILL BE REQUIRED TO REMOVE AND REPLACE WITH A SPECIFIED SEALANT (SPEC: 07 92 00).
18. THE HVAC SYSTEM SHALL BE CONSTRUCTED IN ACCORDANCE WITH NFPA 101:7-2 and NFPA 90A "STANDARD FOR THE INSTALLATION OF AIR CONDITIONING AND VENTILATION SYSTEMS".
19. ALL HVAC SYSTEM FLUES & VENTS SHALL BE CONSTRUCTED IN ACCORDANCE WITH NFPA 54 (LATEST EDITION).
20. PROVIDE AIR FILTRATION MEDIA FOR OUTSIDE AND RETURN AIR PRIOR TO OCCUPANCY THAT PROVIDES AT LEAST A MINIMUM EFFICIENCY REPORTING VALUE (MERV) OF 8.
21. COVERING OF DUCT OPENINGS AND PROTECTION OF MECHANICAL EQUIPMENT DURING CONSTRUCTION AT THE TIME OF ROUGH INSTALLATION, OR DURING STORAGE ON THE CONSTRUCTION SITE AND UNTIL FINAL SETUP OF THE HEATING AND COOLING EQUIPMENT, ALL SEALS AND OTHER RELATED AIR DISTRIBUTION COMPONENTS SHALL BE COVERED WITH TAPE, PLASTIC SHEETMETAL OR OTHER METHODS ACCEPTABLE TO THE ENFORCING AGENCY TO REDUCE AMOUNT OF DUST OR DEBRIS WHICH MAY COLLECT IN THE SYSTEM.
22. ALL HVAC CONDENSATE LINES SHALL RUN AT A MINIMUM SLOPE OF 1/8" PER FOOT.

JON E. ROCHARDT, P.E.
 License No. 04137
 3833 E. Hawthorne Road, Suite 1000
 Springfield, Missouri 65804
 Phone: 417-862-2265
 Fax: 417-862-2265




CRAIG A. SCHNEIDER, AIA
 ARCHITECT
 1736 East Sunshine, Suite 417
 Springfield, Missouri 65804
 Fax: 417-862-2265
 e-mail: architect@entricschneider.com

PROJECT:
 NEW O'REILLY AUTO PARTS STORE
 SLIDING HILL PLACE
 ASHLAND, VA #2 - ASHLAND MAGISTERIAL DISTRICT
HVAC PLAN

O'Reilly AUTO PARTS
 CORPORATE OFFICES
 233 SOUTH PATTERSON
 SPRINGFIELD, MISSOURI 65802
 (417) 862-2674 TELEPHONE

COMM #	3993
DATE:	2-24-17
REVISION	8-16-17
DATE:	11-3-17

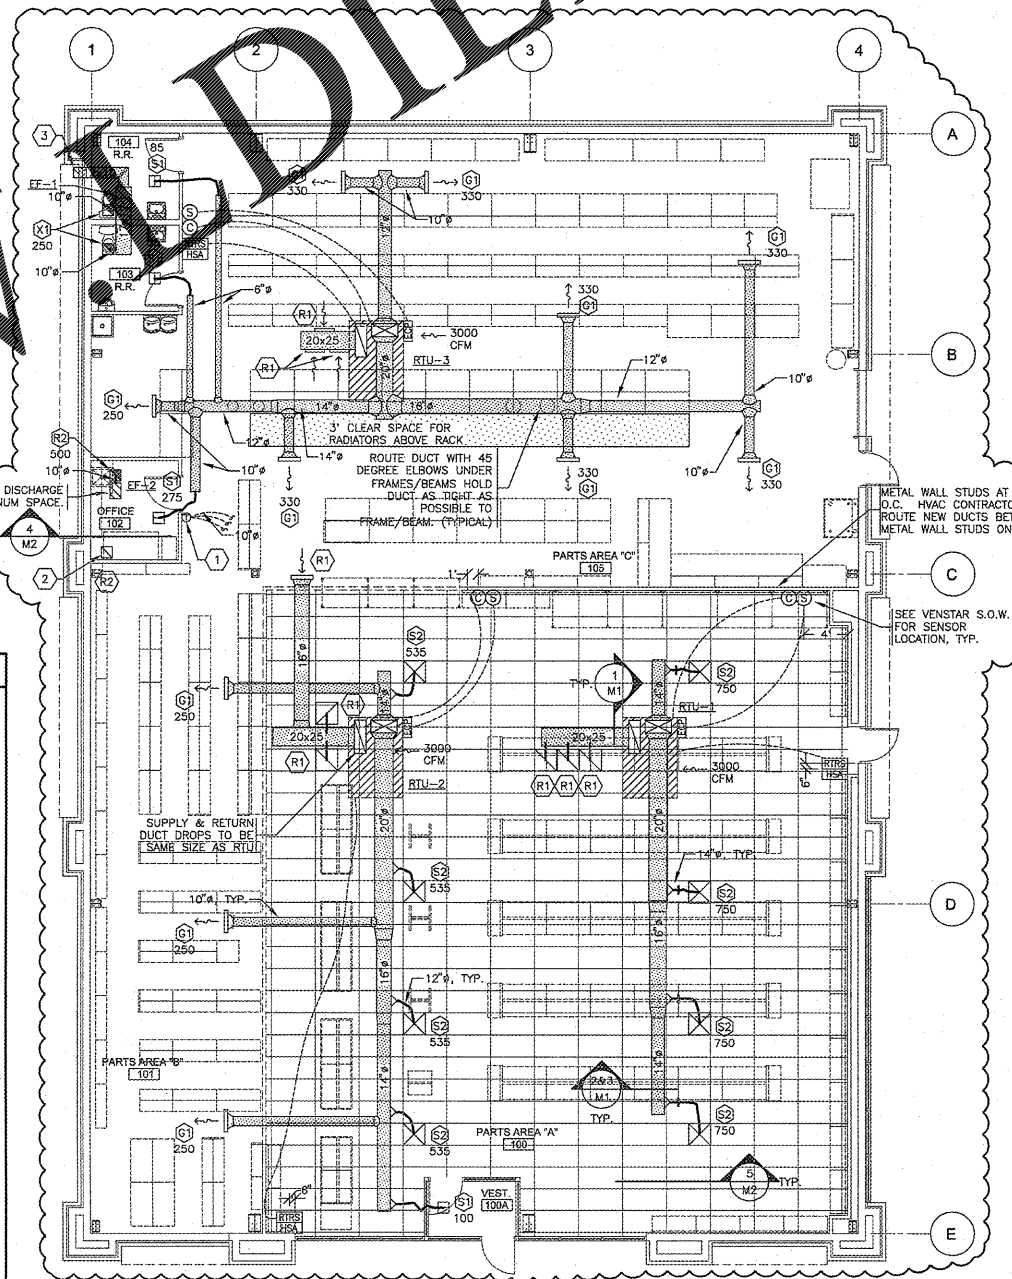


HVAC LEGEND

[Symbol]	SUPPLY DIFFUSER (4 WAY)
[Symbol]	SUPPLY DIFFUSER (1 WAY)
[Symbol]	RETURN AIR GRILLE
[Symbol]	EXHAUST REGISTER
[Symbol]	RECTANGULAR OR ROUND DUCT
[Symbol]	ROUND DUCT
[Symbol]	FLEXIBLE DUCT (MAX. LENGTH = 8'-0" NOTE...LOCATION OF FLEX DUCT SHALL BE AS INDICATED ON PLAN VIEW DRAWING.)
[Symbol]	CONDENSATE PIPING
[Symbol]	REFRIGERANT PIPING
[Symbol]	AIR FLOW INDICATOR
[Symbol]	SADDLE TAP FITTING (WITH DAMPER)
[Symbol]	THERMOSTAT
[Symbol]	CATEGORY 5 COMMUNICATION CABLE
[Symbol]	TURNING VANES
[Symbol]	VENSTAR EQUIPMENT CONTROL PAC
[Symbol]	VENSTAR REMOTE SENSOR (FACTORY SUPPLIED WITH ROOFTOP UNIT). CONTRACTOR SHALL FIELD SPlice CABLE & EXTEND CABLE TO LOCATIONS SHOWN.
[Symbol]	CO2 SENSOR FOR DEMAND CONTROL VENTILATION (FACTORY SUPPLIED WITH ROOFTOP UNIT). FIELD INSTALLED & WIRED BY CONTRACTOR.)
[Symbol]	MOTORIZED DAMPER
[Symbol]	S.O.W.
[Symbol]	VENSTAR "SCOPE OF WORK" DOCUMENT SEE VS3 SHEET.
[Symbol]	REMOTE TEST STATION FOR DUCT SMOKE DETECTOR (MOUNT @ 5'-0" A.F.F.)
[Symbol]	REMOTE ALARM/STROBE FOR DUCT SMOKE DETECTOR (MOUNT @ 7'-6" A.F.F.)

HVAC PLAN

SCALE: 1/8" = 1'-0"

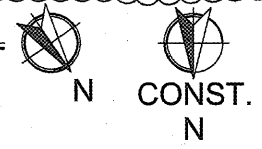

NOTE:
 BOTTOM OF ALL HVAC EQUIPMENT & DUCTS SHALL BE @ A MINIMUM OF 12"-5" A.F.F. EXCEPT WHERE OTHERWISE NOTED.

14:\CRE\0898\01\0898M1_7 Nov 2017 - 3:45 pm

Order Plans @