

ANTHONY CASSATA
ARCHITECT

2805 W. WINDFIELD
SUITE 240
OK BROOK, IL 60523
TEL: (312) 791-1245
FAX: (312) 791-1243

dd's
DISCOUNTS

OWNER:

ROSS STORES
5130 HACIENDA DRIVE
DUBLIN, CA 94568

PROJECT:
dd's
DISCOUNTS
STORE #5352
(GREENVILLE, SC)

WHITE
HORSE PLAZA
6119 WHITE HORSE ROAD
GREENVILLE, SC 29611

DRAWING TITLE: ENLARGED PLANS AND DETAILS

REV. NO.	DATE	DESCRIPTION
01	02/07/18	FOR ROSS REVIEW
02	03/17/18	ROSS MARK-UPS


STATE OF SOUTH CAROLINA
ANTHONY CASSATA
OK Brook, IL 60523
REGISTERED ARCHITECT

EXPIRES: 6/30/2018

COPYRIGHT: ALL DRAWN AND WRITTEN INFO. APPEARING HEREIN SHALL NOT BE DUPLICATED, DISCLOSED OR OTHERWISE REPRODUCED WITHOUT WRITTEN CONSENT.

PFDA JOB: #16027
SCALE: AS NOTED
DRAWN BY: CHECKED BY:

SHEET NUMBER
A4.2

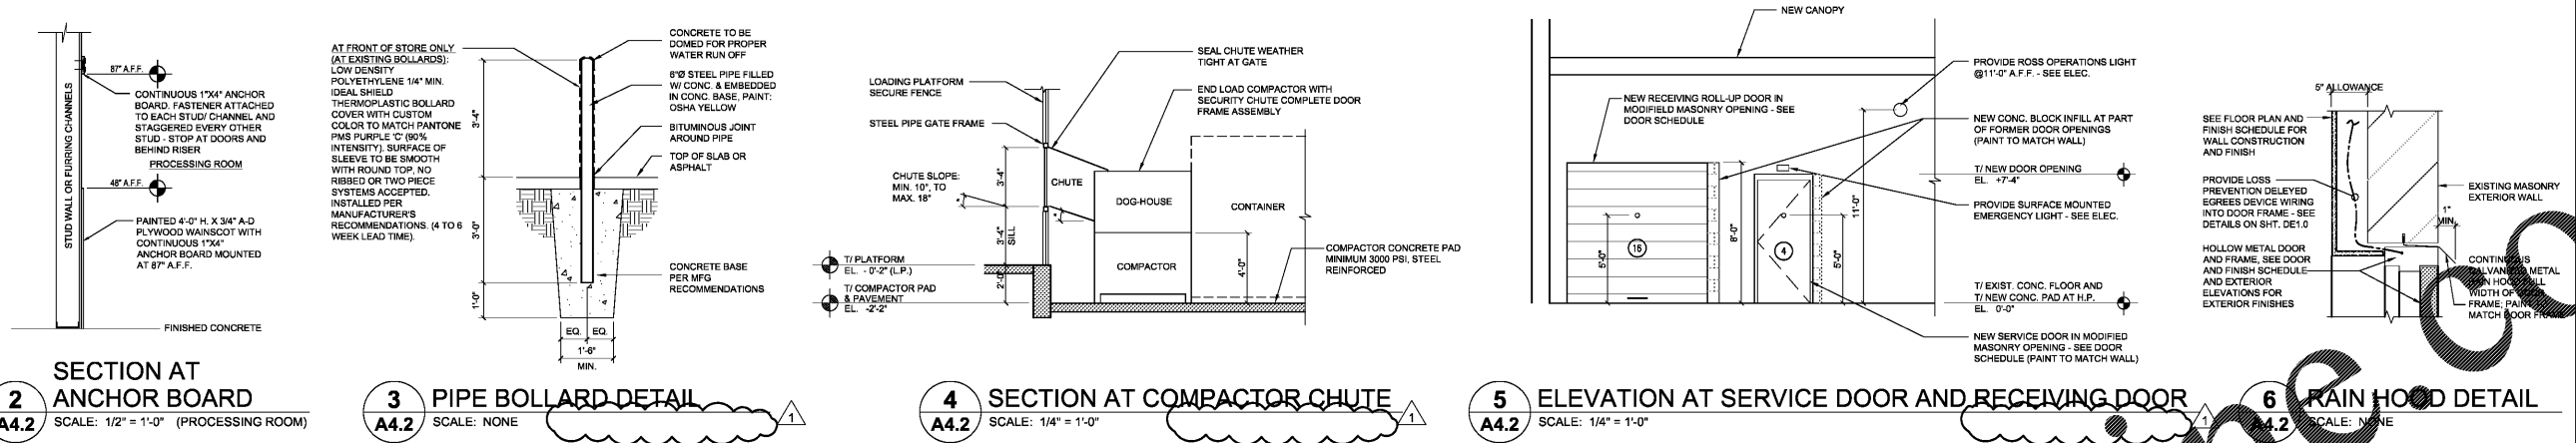

PROCESSING ROOM NOTES

- TRASH COMPACTOR "RAMMET" TC-220T STANDARD, COLOR 07-0004 BEIGE U.O.N. TRASH CONTAINER "RAMMET" 64-400C, COLOR 07-0004 BEIGE U.O.N. BY MARATHON EQUIPMENT CO. PURCHASED DIRECTLY FROM MARATHON'S ROSS ACCOUNT MANAGER (SEE SHT A4.0 FOR CONTACT INFORMATION). NO EXCEPTIONS, INSTALLED BY G.C. AND FULLY OPERATIONAL PRIOR TO TURNOVER. NO EXCEPTION.
- REQUIRED TRASH COMPACTOR ELECTRICAL SERVICE AND FUSED DISCONNECT SWITCH ARE TO BE SIZED IN ACCORDANCE WITH MARATHON EQUIPMENT CO. SPECIFICATIONS (AS MUCH AS A 100 AMP SERVICE DISCONNECT MAY BE REQUIRED DEPENDING ON PHASE AND VOLTAGE) AND PROVIDED BY G.C. CONNECT COMPACTOR TO BUILDING POWER IN ACCORDANCE WITH MARATHON AND CODE REQUIREMENTS (SPECIFIED COMPACTOR IS TO BE SUPPLIED WITH A 10HP MOTOR AND PRESSURE GAUGE).
- IF THE COMPACTOR IS LOCATED AT A DISTANCE FROM THE ELECTRICAL ROOM THEN INSURE THAT WIRING IS ADEQUATELY SIZED FOR THE VOLTAGE DROP.
- REQUIRED WELLMAN OIL HEATER TO BE INSTALLED BY MARATHON AT TRASH COMPACTOR ON ANY STORE WHERE THE TEMPERATURE DROPS BELOW 30° FAHRENHEIT AT THE SOLE DISCRETION OF THE ROSS CONSTRUCTION REPRESENTATIVE.
- CONFIRM PROCESSING ROOM SHELF LAYOUT WITH ROSS CONSTRUCTION REPRESENTATIVE. ACTUAL LAYOUT WILL BE SHOWN ON RA-1 ROSS AISLE PLAN PROVIDED BY THE ROSS CONSTRUCTION REPRESENTATIVE.
- THE LOCATION OF ALL DEVICES AND OBJECTS (RISERS, LEADERS, PIPING, CONDUITS, ETC.) IN THE PROCESSING ROOM MUST BE COORDINATED WITH AND APPROVED BY THE ROSS CONSTRUCTION REPRESENTATIVE SO AS NOT TO INTERFERE WITH FIXTURES AND PROCESSING ROOM OPERATIONS.
- PROVIDE 1-1/2" STEEL ANGLE CORNER GUARDS AT ALL EXPOSED OUTSIDE CORNERS OF PROCESSING ROOM TO 4'-0" A.F.F. OR TOP OF DOOR FRAME.

SYMBOL KEY

WORK PERFORMED BY LANDLORD UNDER SEPARATE PLANS AND PERMITS

NOTE:
G.C. TO PROVIDE CONFIRMATION OF FINISHED DIMENSIONED PLANS PRIOR TO INSTALLATION AND FINISHES.

NOTE:
REFER TO SHEET A4.0 FOR WALL LEGEND.


G.C. TO MAKE PRIMARY TERMINATION OF 25 PAIR TELEPHONE CABLES IN TENANT ELECTRICAL ROOM TERMINAL BLOCK, 9 SERVICE LINE.

- PHONE LINE 1: SHARED WITH BACKUP DATA AND EMERGENCY PHONE IN ELECTRICAL ROOM.
- PHONE LINE 2: SHARED WITH BACKUP FIRE ALARM.
- PHONE LINE 3: SHARED WITH PRIMARY BURGLAR ALARM.
- PHONE LINE 4: SHARED WITH PRIMARY BURGLAR ALARM.
- PHONE LINE 5: SHARED WITH PRIMARY BURGLAR ALARM.


ALL ELECTRICAL PANELS INCLUDING THE SECURITY PANEL, FCP, EMS PANEL AND TELEPHONE BATTERY MUST BE LOCATED IN THE ELECTRICAL ROOM.

LANDLORD TO PROVIDE 4" CONDUIT AND PULL STRING FOR TENANT'S PHONE SERVICE

LANDLORD TO INSTALL NEW 600A MDP PANEL ON UNISTRUTS UNTIL NEW PARTITION IS CONSTRUCTED

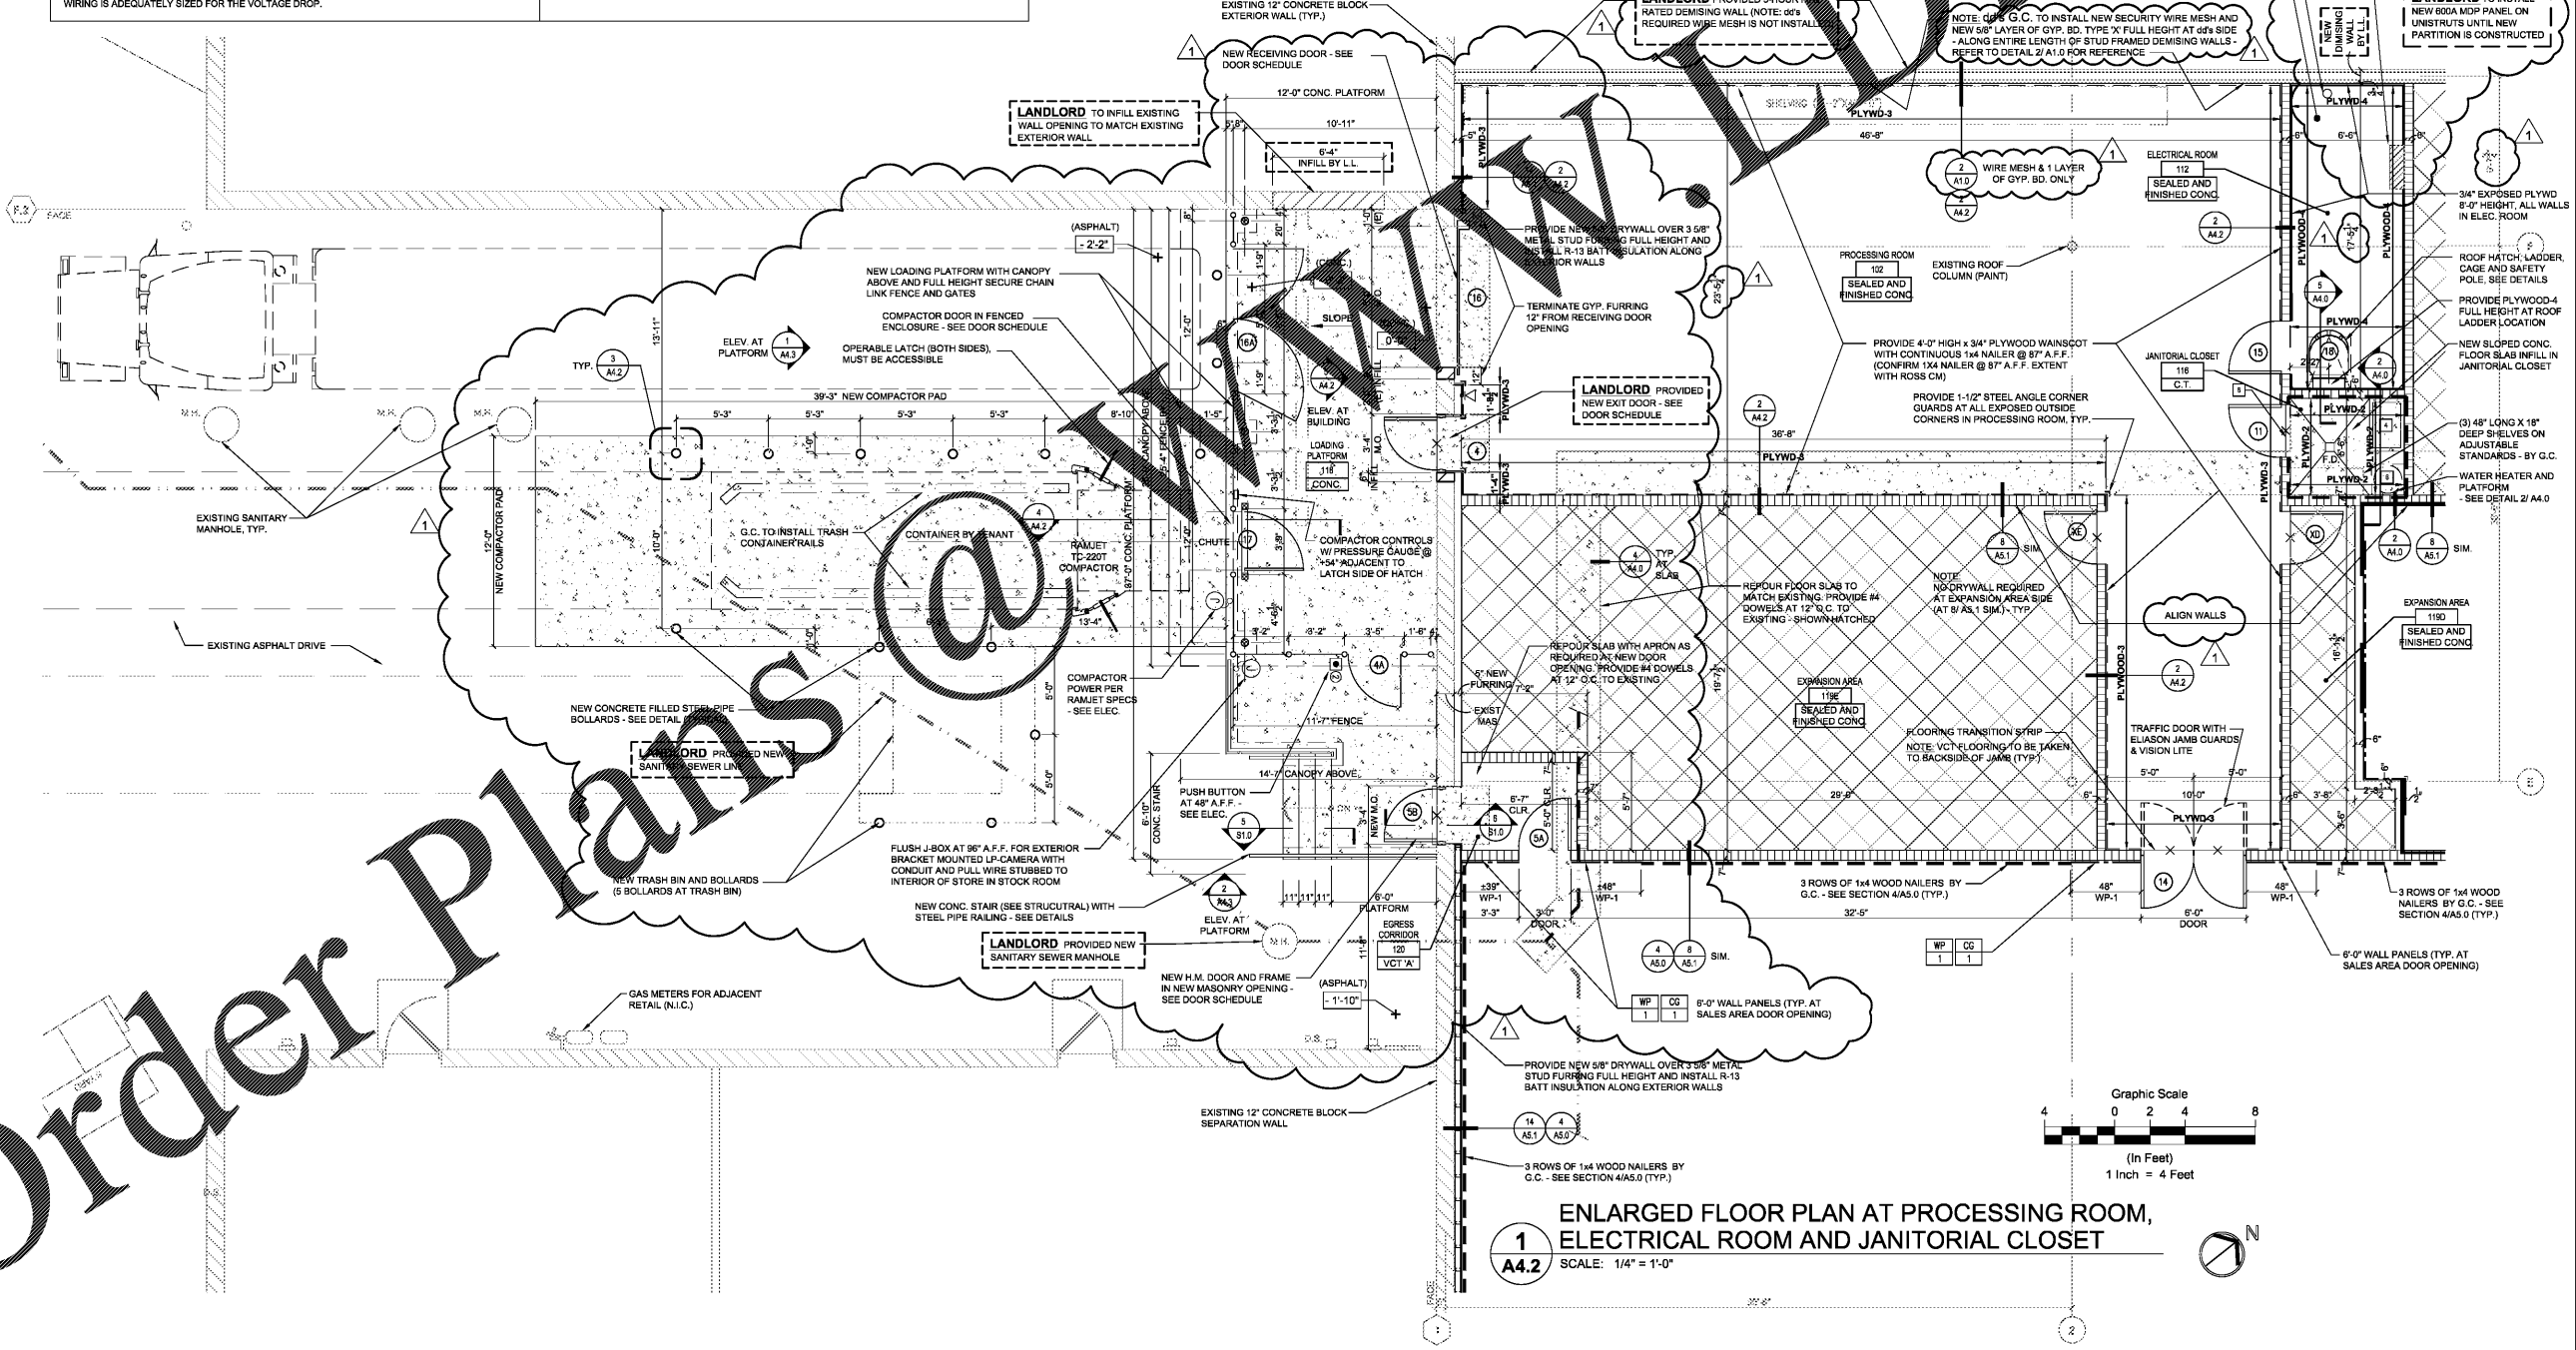

1
A4.2 SCALE: 1/4" = 1'-0"
ENLARGED FLOOR PLAN AT PROCESSING ROOM, ELECTRICAL ROOM AND JANITORIAL CLOSET

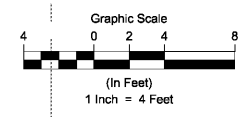

Order Plans @