


FIRST FLOOR FIRE PROTECTION PLAN  
SCALE: 1/8" = 1' - 0"

SECOND FLOOR FIRE PROTECTION PLAN  
SCALE: 1/8" = 1' - 0"

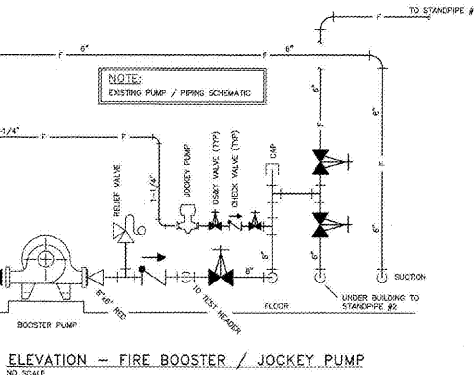

PLT DATE: 8 SEPTEMBER 1999

The State of South Carolina

MEDICAL UNIVERSITY OF SOUTH CAROLINA  
PHYSICAL PLANT DIVISION  
CHARLESTON, SOUTH CAROLINA

PROJECT TITLE:  
STORM EYE INSTITUTE  
SPRINKLER SYSTEM RENOVATION

H51-50068-PC

FP1

SEALS  
 COPYRIGHT BY ROSENBLUM COE ARCHITECTS, INC.  
 THIS DRAWING HAS BEEN PREPARED BY ROSENBLUM COE ARCHITECTS, INC. FOR THE PROJECT AND IS THE PROPERTY OF ROSENBLUM COE ARCHITECTS, INC. IT IS TO BE USED ONLY FOR THE PROJECT AND NOT BE REPRODUCED OR TRANSMITTED IN ANY FORM OR BY ANY MEANS, ELECTRONIC OR MECHANICAL, INCLUDING PHOTOCOPYING, RECORDING, OR BY ANY INFORMATION STORAGE AND RETRIEVAL SYSTEM, WITHOUT THE WRITTEN PERMISSION OF ROSENBLUM COE ARCHITECTS, INC.

NOTES  
 GENERAL NOTES  
 1. AS-BUILT FIRE PROTECTION SYSTEM DRAWINGS ARE PROVIDED FOR CONTRACTORS REFERENCE ONLY TO ASSIST WITH DESIGN. FLOW RATE CALCULATIONS AS REQUIRED BY NFPA-13 (2013) 8.12.20.2.

MUSC  
 MEDICAL UNIVERSITY  
 of SOUTH CAROLINA  
 PROJECT NUMBER: H51-50068  
 DHEC PROJECT NUMBER: 580145

CONSTRUCTION DOCUMENTS

STORM EYE INSTITUTE  
 OPTICAL SHOP  
 H51-50068  
 167 ASHLEY AVE  
 CHARLESTON, SC 29425

ROSENBLUM COE ARCHITECTS, INC.  
 1643 MEANS STREET  
 CHARLESTON, SC 29412  
 843.577.6073

FIRE PROTECTION FIRST FLOOR AS-BUILTS

SHEET NAME	
PROJECT NUMBER	17016
DRAWN BY	TSN
CHECKED BY	MER
DATE	05/09/2018
SCALE	

FP301