


FIRST FLOOR FIRE PROTECTION PLAN
SCALE: 1/8" = 1' - 0"

SECOND FLOOR FIRE PROTECTION PLAN
SCALE: 1/8" = 1' - 0"

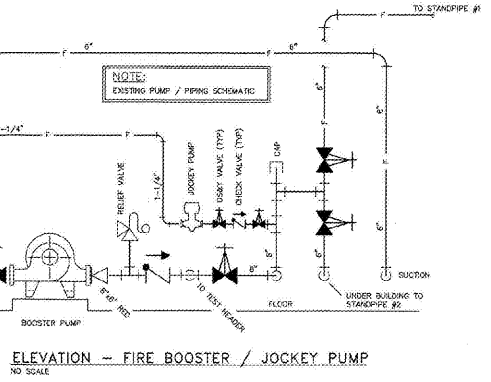

PLT DATE: 8 SEPTEMBER 1999

The State of South Carolina

Medical University of South Carolina
PHYSICAL PLANT DIVISION
CHARLESTON, SOUTH CAROLINA

PROJECT TITLE:
STORM EYE INSTITUTE
SPRINKLER SYSTEM RENOVATION

H51-8695-PG

FP1

SEALS
 COPYRIGHT BY ROSENBLUM COE ARCHITECTS, INC.
 THIS DRAWING HAS BEEN PREPARED BY ROSENBLUM COE ARCHITECTS, INC. FOR THE PROJECT AND IS THE PROPERTY OF ROSENBLUM COE ARCHITECTS, INC. IT IS TO BE USED ONLY FOR THE PROJECT AND NOT BE REPRODUCED OR TRANSMITTED IN ANY FORM OR BY ANY MEANS, ELECTRONIC OR MECHANICAL, INCLUDING PHOTOCOPYING, RECORDING, OR BY ANY INFORMATION STORAGE AND RETRIEVAL SYSTEM, WITHOUT THE WRITTEN PERMISSION OF ROSENBLUM COE ARCHITECTS, INC.

NOTES

GENERAL NOTES
 1. AS-BUILT FIRE PROTECTION SYSTEM DRAWINGS ARE PROVIDED FOR CONTRACTORS REFERENCE ONLY TO ASSIST WITH DESIGN. FLOW RATE CALCULATIONS AS REQUIRED BY NFPA-13 (2013) 8.12.20.2.

MUSC
 MEDICAL UNIVERSITY
 OF SOUTH CAROLINA
 PROJECT NUMBER: H51-50068
 DHEC PROJECT NUMBER: 580145

CONSTRUCTION DOCUMENTS

STORM EYE INSTITUTE
 OPTICAL SHOP
 H51-50068
 167 ASHLEY AVE
 CHARLESTON, SC 29425

ROSENBLUM COE ARCHITECTS, INC.
 1643 MEANS STREET
 CHARLESTON, SC 29412
 843.577.6073

FIRE PROTECTION FIRST FLOOR AS-BUILTS

SHEET NAME	
PROJECT NUMBER	17016
DRAWN BY	TSN
CHECKED BY	MER
DATE	05/09/2018
SCALE	

FP301

Order Plans @