


NOTICE TO GENERAL CONTRACTOR:
 THE SITE SURVEY BELOW IS FOR REFERENCE ONLY TO INDICATE EXISTING CONDITIONS AND CERTIFIED EXISTING FLOOR ELEVATION. THERE IS NO EXTERIOR SITE WORK UNDER THE SCOPE OF THIS REMODEL THAT WOULD ALTER THE SITE OUTSIDE THE TYPICAL BUILDING PARAMETERS. SIDE WALK WORK AT ENTRY DOORS SHALL BE "REMOVE AND REPLACE" TO MATCH EXISTING CONDITIONS. WD PARTNERS HAS NOT REVIEWED THE INFORMATION BELOW AND IS NOT RESPONSIBLE FOR THE INFORMATION, ERRORS, AND OMISSIONS FOR THE CIVIL ENGINEERING SCOPE OF WORK. THE GENERAL CONTRACTOR SHALL VERIFY WITH THE DEVELOPER AND LUCKY'S MARKET THE EXTENT AND SCOPE OF ANY/ALL SITE WORK ABOVE AND BEYOND THE SCOPE OF THIS PERMIT SET AND RECEIVE REVIEW AND FINAL APPROVAL FROM THE AUTHORITY HAVING JURISDICTION AND LANDLORD PRIOR TO PROCEEDING ADDITIONAL CONSTRUCTION.

wd
 107 DISCOVERY BLVD
 LIN, OH 43002
 614.474.7000 T
 WDPARTNERS.COM

DISCLAIMER:
 The construction documentation contained on this sheet was not prepared by WD Partners, Inc. and is included within this set FOR REFERENCE ONLY.

ALL ELEVATIONS ARE IN NAVD 88

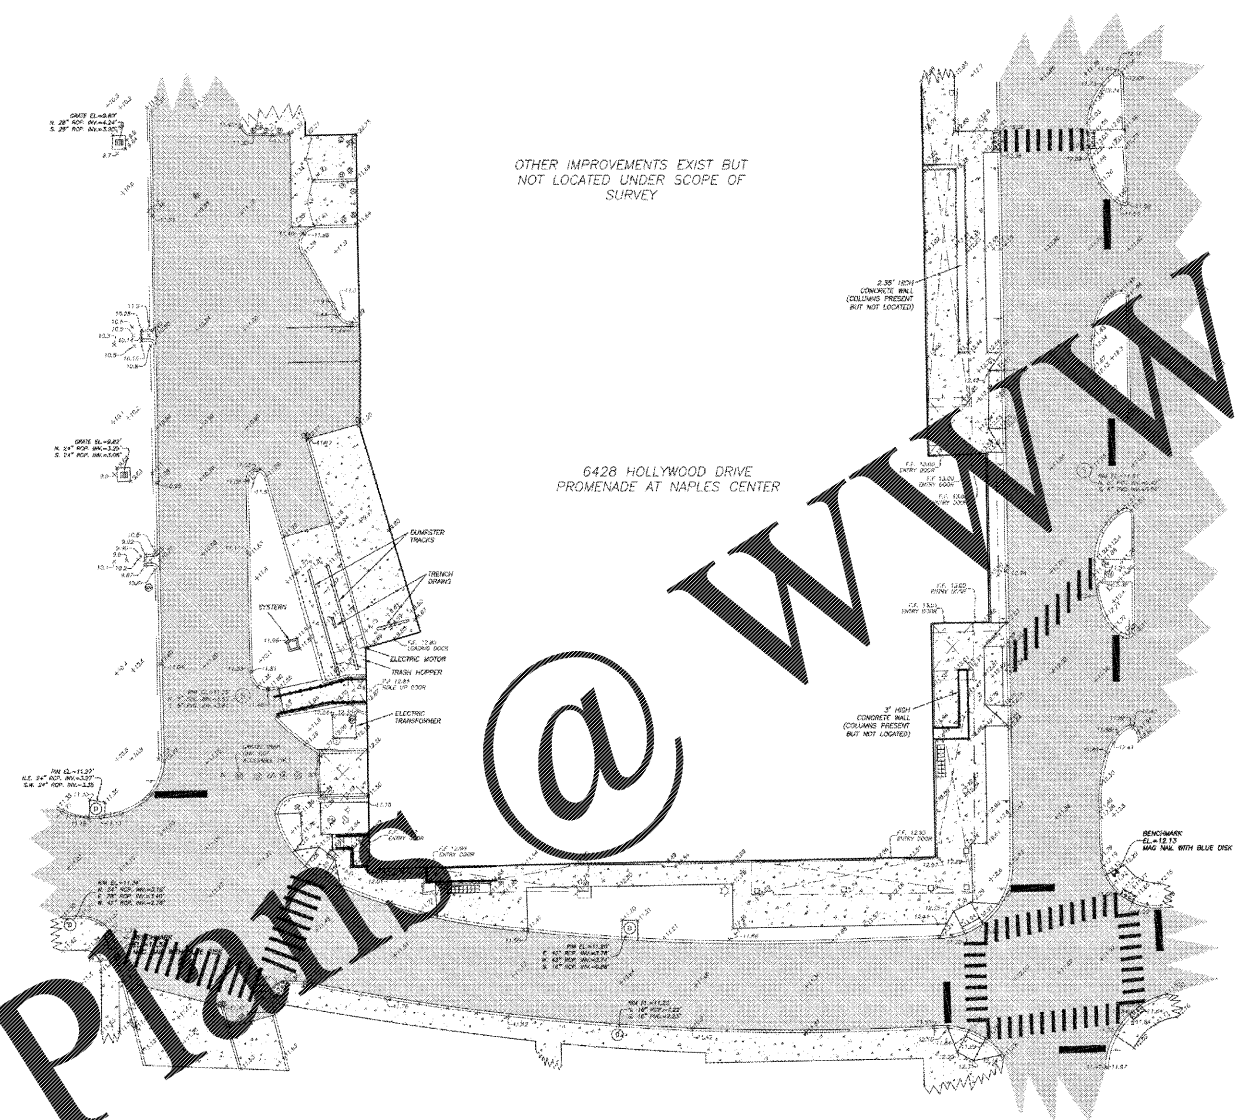

- Notes:**
1. Last day of field work is April 18, 2018 (date of survey).
 2. Improvements shown are in State Plane Coordinate System Florida East Zone 85, 2011 adjustment.
 3. The intended use of this survey is to serve as an as-built tool for design purposes.
 4. Unless otherwise indicated all easements shown have been located on plot.
 5. Only above ground visible and apparent improvements were shown.
 6. Foundations and overhangs are not shown unless visible on this survey.
 7. Irrigation equipment was not shown unless visible on this survey.
 8. No other persons or entities were shown on this survey unless they may rely on this survey.
 9. All dimensions are in feet and decimals thereof, unless otherwise noted.
 10. Subject to easements, encroachments and other matters of record.
 11. No other survey was performed within the scope of this survey and therefore no other utility lines are shown on this plot or shown hereon even though they may exist or be shown on other surveys.
 12. Property located in Flood Zone X according to the Federal Emergency Management Agency (FEMA) Flood Insurance Rate Map (FIRM) Number 22027C0244, Community Number 13300, (3/24/2010) is shown on this plot.
 13. All elevations are in the American Vertical Datum of 1988 (NAVD88).

- SYMBOL LEGEND**
- ⊕ SANITARY MAN HOLE
 - △ SANITARY CLEAN OUT
 - ⇝ BACKFLOW PREVENTER
 - ⊞ GAS VALVE
 - ⊞ IRRIGATION CONTROL VALVE
 - ⊞ POST INDICATOR VALVE
 - ⊞ ELECTRICAL HAND HOLE
 - ⊞ TELECOMMUNICATIONS BOX
 - ⊞ WATER VALVE
 - ⊞ WATER VAULT
 - ⊞ FIRE HYDRANT
 - ⊞ LIGHT POLE
 - ⊞ SIGN
 - ⊞ FIRE DEPARTMENT CONNECTION
 - ⇝ BACK FLOW PREVENTER
 - ⊞ GREASE TRAP
 - ⊞ DRAINAGE MAN HOLE
 - ⊞ 6" D.I.P. CUT THRU SIDEWALK
 - ⊞ BENCHMARK
 - ⊞ SOFT SURFACE SHOTS
 - ⊞ HARD SURFACE SHOTS

- SURFACE LEGEND**
- ASPHALT
 - CONCRETE
 - BRICK PAVEMENT
 - DETECTABLE WARNING SURFACE

For the Exclusive Use of
 WD Partners
 Digitally signed by John Parents
 Date: 2018.04.26 10:21:11 -0400



TOPOGRAPHIC SURVEY

A Portion of Tract A
 PINE AIR LAKES UNIT 5
 Collier County, Florida

CLIENT:	WD Partners	PROJECT NO.:	18-209
HORIZONTAL SCALE:	1"=20'	VERTICAL SCALE:	N/A
DATE:	3/24/18	DRAWING NO.:	4-185
CHECKED:	BOOK/PAGE	DATE:	1/29/18
GP:	1:29 26-31	CM:	P-533

LEGAL DESCRIPTION
 A parcel of land located in a portion of "Tract A", Pine Air Lakes Unit Five, according to the final plat, recorded in Plat Book 4A, Page 24 through 25, of the Public Records of Collier County, Florida.

FOR REFERENCE ONLY

REVISIONS

NO.	DATE	DESCRIPTION
1		
2		
3		
PERMIT ISSUE
 MAY 7, 2018
 BID ISSUE 05/07/18
 STORE NUMBER
 57
 WD PROJECT NUMBER
 LKYUF0011

G1.0 EXISTING SITE SURVEY

Order Plans @ WDWLDILINE.COM

01 EXISTING SITE SURVEY (FOR REFERENCE ONLY)
 SCALE: