


2
A-100
CURVED WALL DIMENSIONING PLAN
1/8"=1'-0"
(TYPICAL OF 3)

OVERALL DIMENSIONING FLOOR PLAN

3/32"=1'-0"

NOTE: ALL DIMENSIONS ARE TO FACE OF BRICK (U.N.O.)

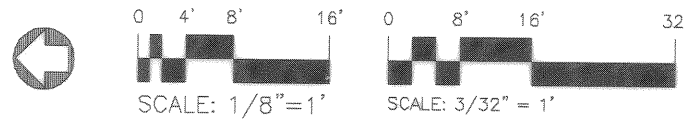

DRAWING REVISIONS		Prep By: <i>WJ</i>	Date: <i>5/16/04</i>	Apprv: <i>WJ</i>	Inc. Glick/Boehm & Associates, Inc. 2417 Meeting Street Charleston, S.C. 29405 (803) 577-6377
1	AS-BUILT DRWG. NO CORRECTIONS	DR: <i>BOEHM</i>	SR: <i>BOEHM</i>	CHK: <i>BOEHM</i>	DATE: <i>5/20/04</i>
				DR: <i>BOEHM</i>	DATE: <i>5/20/04</i>
				CHK: <i>BOEHM</i>	DATE: <i>5/20/04</i>
				APPV: <i>BOEHM</i>	DATE: <i>5/20/04</i>
				TECHNICAL BRANCH	DATE: <i>5/20/04</i>
				PE	DATE: <i>5/20/04</i>
CHARLESTON AIR FORCE BASE		CHARLESTON, SOUTH CAROLINA		DINING FACILITY	
Naval Facilities Engineering Command		Southern Division		OVERALL DIMENSIONING FLOOR PLAN	
Southern Division		Charleston, South Carolina		APPROVED: <i>R.D. Moore</i> PE DATE: <i>5/16/04</i>	
ED FOR COMMANDER, NAVFAC					
STATE OF SOUTH CAROLINA					
GLICK/BOEHM & ASSOCIATES, INC.					
REGISTERED ARCHITECT					
RECORD DRAWING DATE: <i>9/27/04</i>					
CODE I.D. NO.: 80091					
DRAWING SIZE: D					
SPEC. NO. 06-98-09.39					
CONSTR. CONTR. NO. N62467-98-C-09.39					
NAVFAC DRAWING NO. 5357878					
SHEET 53 OF 194					
A-100					