


2  
A-100  
CURVED WALL DIMENSIONING PLAN  
1/8"=1'-0"  
(TYPICAL OF 3)

1  
A-100  
OVERALL DIMENSIONING FLOOR PLAN  
3/32"=1'-0"

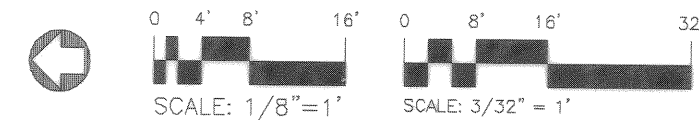

Order Plans @ WWW.LDILine.com

DRAWING REVISIONS		Glick/Boehm & Associates, Inc. 2417 Meeting Street Charleston, S.C. 29405 (803) 577-6377 DR BOEHM SR BOEHM CH ENGR DATE SUBMITTED BY (FIRM MEMBER-TITLE) TECHNICAL BRANCH PPE
Rev.	Date	
1	5/16/04	AS-BUILT DRWG. NO CORRECTIONS 404 PREP BY DATE APPROVED R.D. Moore PE DATE 5/16/04 ED FOR COMMANDER, NAVFAC
CHARLESTON AIR FORCE BASE		CHARLESTON, SOUTH CAROLINA
DINING FACILITY		OVERALL DIMENSIONING FLOOR PLAN
Naval Facilities Engineering Command		Southern Division
Southern Division		Charleston, South Carolina
STATE OF SOUTH CAROLINA Glick/Boehm & Associates, Inc. CHARLESTON NO. 8-80006 REGISTERED ARCHITECT		RECORD DRAWING DATE 9/27/04 CODE I.D. NO. 80091 DRAWING SIZE: D SPEC. NO. 06-98-0939 CONSTR. CONTR. NO. N62467-98-C-0939 NAVFAC DRAWING NO. 5357878 SHEET 53 OF 194
A-100		468-142