




1 EXISTING CHILLER IMPROVEMENT PLAN
A-106 SCALE: 1/8"=1'-0"

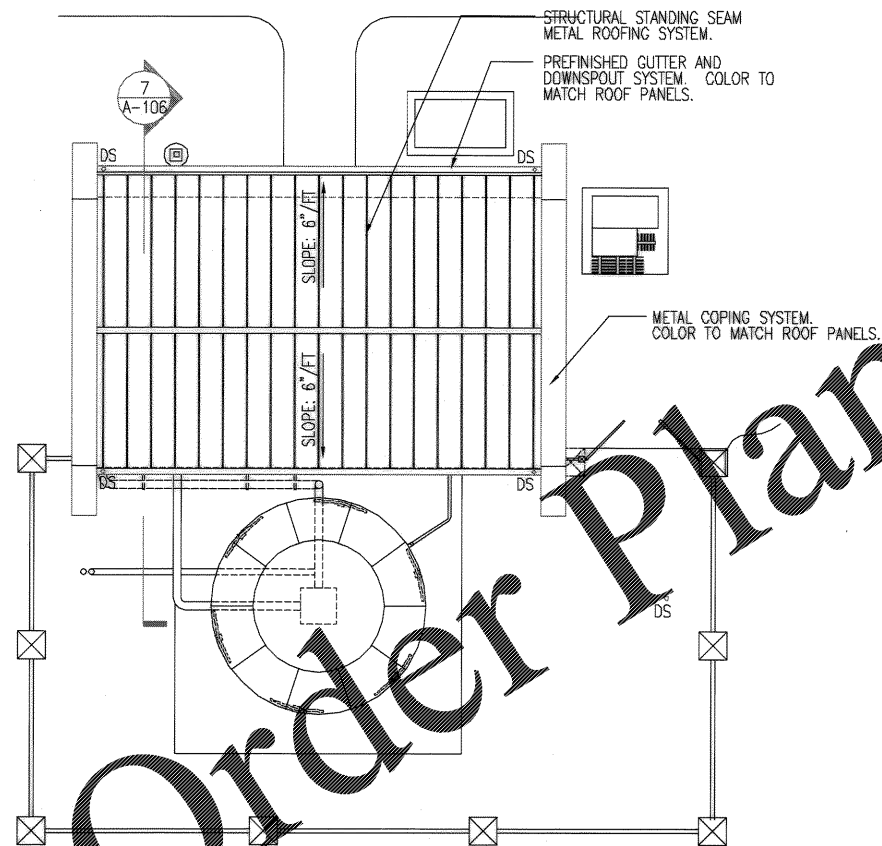


1 EXISTING CHILLER IMPROVEMENT ROOF PLAN
A-106 SCALE: 1/8"=1'-0"

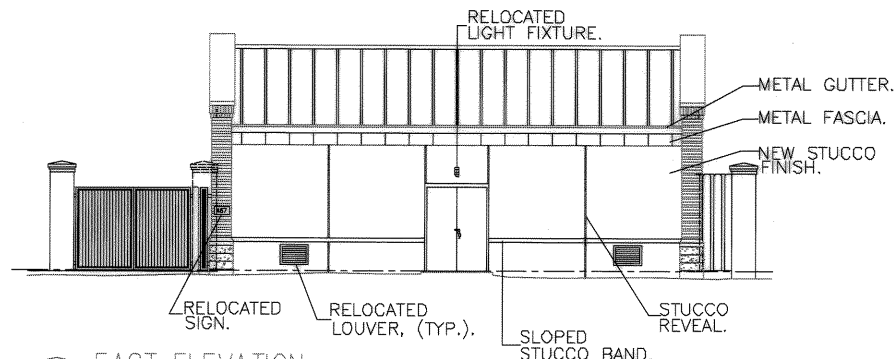


2 EAST ELEVATION
A-106 SCALE: 1/8"=1'-0"

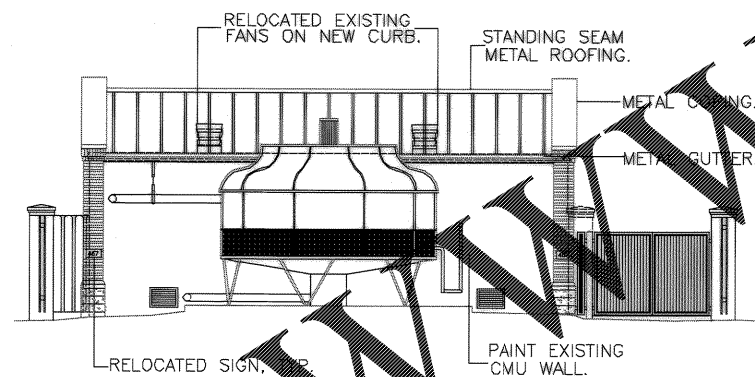


4 WEST ELEVATION
A-106 SCALE: 1/8"=1'-0"

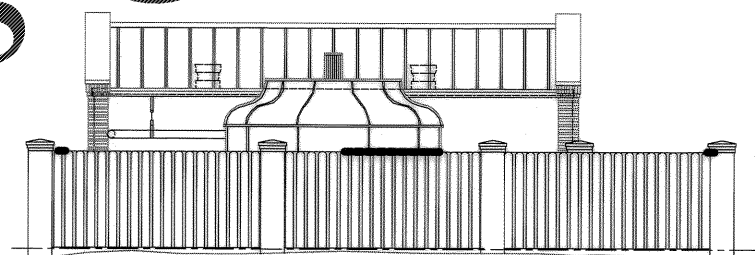


6 WEST ELEVATION
A-106 SCALE: 1/8"=1'-0"

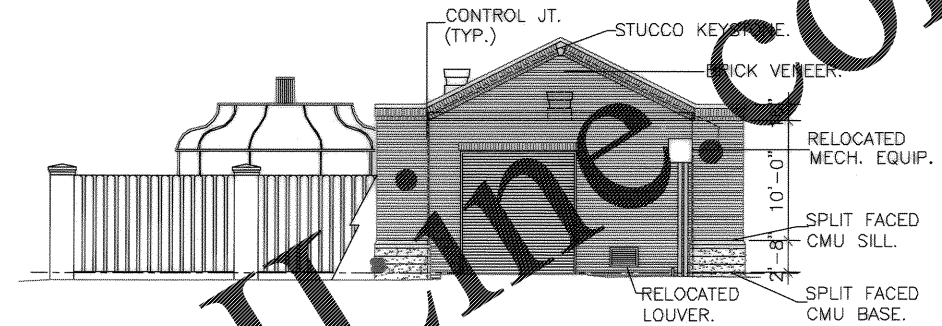

3 SOUTH ELEVATION
A-106 SCALE: 1/8"=1'-0"

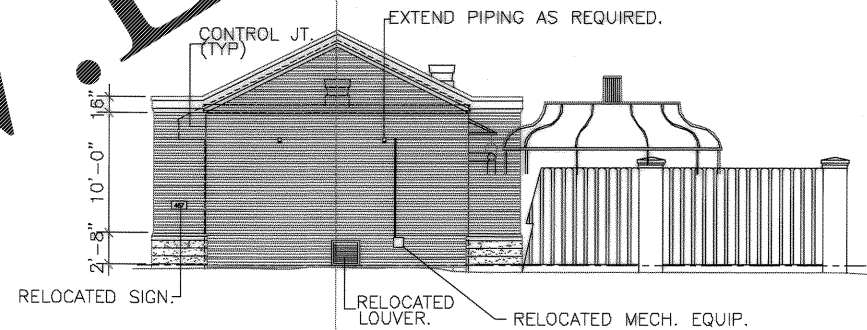

5 NORTH ELEVATION
A-106 SCALE: 1/8"=1'-0"

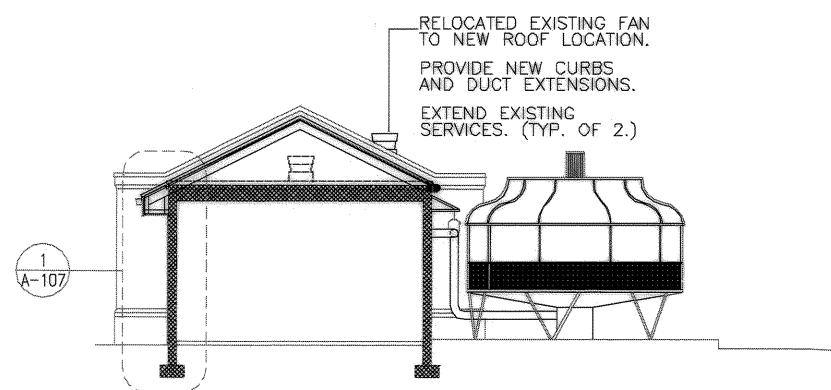

7 SECTION
A-106 SCALE: 1/8"=1'-0"

NOTE: 1. IMPROVEMENTS TO THE EXISTING CHILLER BUILDING IS PART OF THE BASE BID.
2. IF THE CHILLER PLANT REPLACEMENT OPTION IS CHOSEN, ALL WORK SHOWN ON THIS SHEET WILL BE OMITTED.



Glick/Boehm & Associates, Inc.
 247 Meeting Street
 Charleston, S.C. 29401
 (803) 577-6377
 Glick/Boehm
 ARCHITECT

DRAWING REVISIONS
 Description
 Rev. / AS-BUILT DRWG. NO CORRECTIONS
 Date
 Prepped By
 Date
 Approved By
 Date

CHARLESTON AIR FORCE BASE
 CHARLESTON, SOUTH CAROLINA
 DINING FACILITY
 EXISTING CHILLER BUILDING-IMPROVEMENTS
 APPROVED BY DATE 5/14/04
 ETD FOR COMMANDER, NAIFAC

Naval Facilities Engineering Command
 Southern Division
 Charleston, South Carolina

STATE OF SOUTH CAROLINA
 Glick/Boehm & Associates, Inc.
 CHARLESTON
 NO. B-80006
 REGISTERED ARCHITECT

RECORD DRAWING DATE
 9/27/04
 CODE I.D. NO. 80091
 DRAWING SIZE: D
 SPEC. NO. 06-98-0939
 CONSTR. CONTR. NO. N62467-98-C-0939
 NAVFAC DRAWING NO. 5357884
 SHEET 59 OF 194
 A-106