



1 WALL SECTION
A-108 3/4"=1'-0"

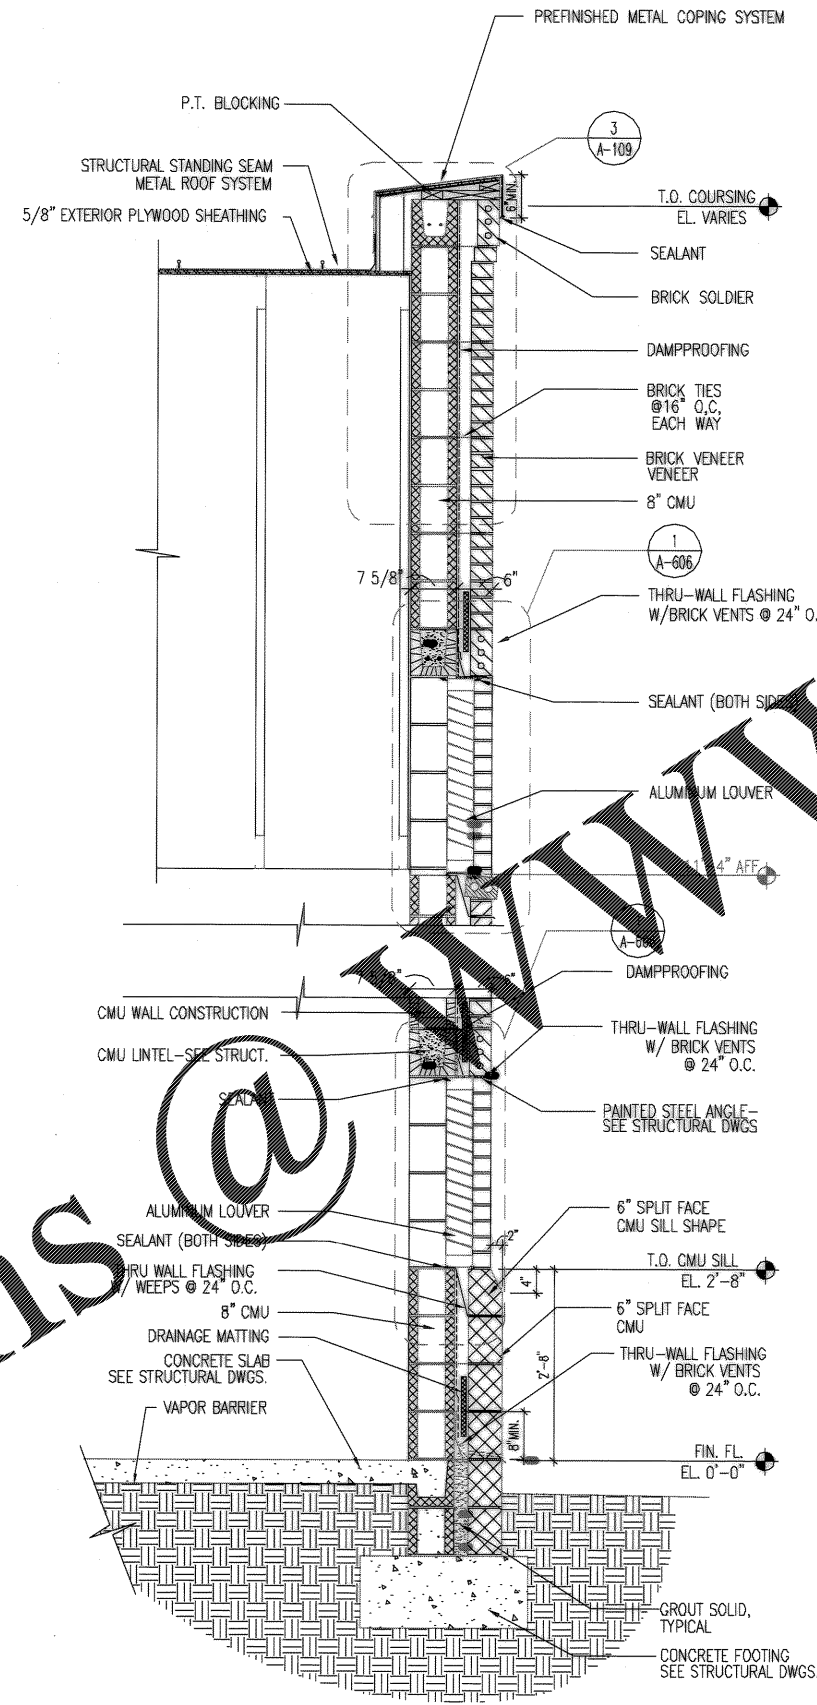

3 WALL SECTION
A-109 3/4"=1'-0"

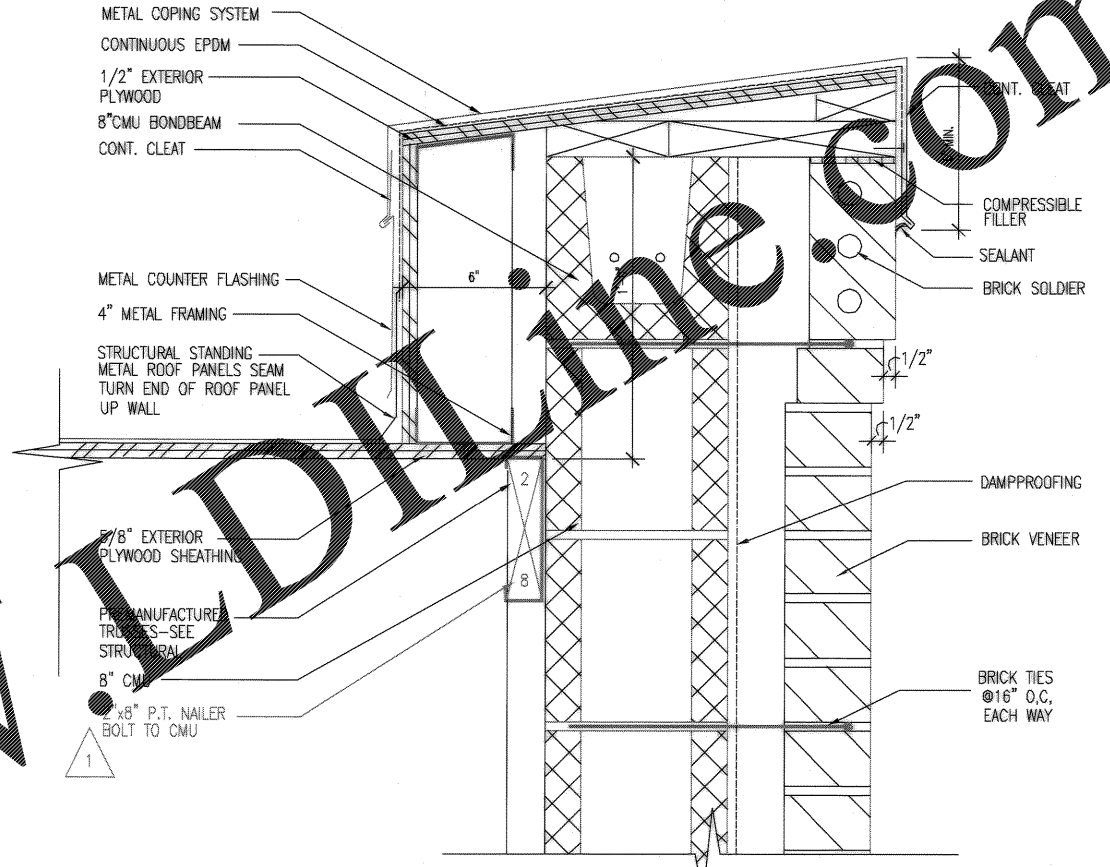

3 PARAPET DETAIL
A-109 SCALE: 3"=1'-0"

Order Plans @ WWW.WDLINE.COM

<p>Rev. 1 DRWG. CORRECTED TO AS-BUILT DATE 5/11/04 BY RUM</p>	<p>Prep By Date APV 5/11/04</p>	<p>APPROVED BY (FORM MEMBER-TITLE): RUM DRK GT ENR BOEHM</p>	<p>CHARLESTON AIR FORCE BASE CHARLESTON, SOUTH CAROLINA DINING FACILITY CHILLER PLANT REPLACEMENT OPTION</p>
<p>DRAWING REVISIONS</p>			<p>APPROVED BY (FORM MEMBER-TITLE): RUM DRK GT ENR BOEHM</p>
<p>CHARLESTON AIR FORCE BASE CHARLESTON, SOUTH CAROLINA DINING FACILITY CHILLER PLANT REPLACEMENT OPTION</p>			<p>APPROVED BY (FORM MEMBER-TITLE): RUM DRK GT ENR BOEHM</p>
<p>Naval Facilities Engineering Command Southern Division Charleston, South Carolina</p>			<p>STATE OF SOUTH CAROLINA GLICK/BOEHM & ASSOCIATES, INC. CHARLESTON NO. B-80006 REGISTERED ARCHITECT</p>
<p>RECORD DRAWING DATE 9/27/04</p>			<p>CODE I.D. NO. 80091</p>
<p>DRAWING SIZE: D</p>			<p>SPEC. NO. 06-98-0939</p>
<p>CONSTRN. CONTR. NO. N62467-98-C-0939</p>			<p>NAVAFAC DRAWING NO. 5357887</p>
<p>SHEET 62 OF 194</p>			<p>A-109</p>