

EXTERIOR FINISH SCHEDULE

STANDING SEAM METAL ROOF:	MANUFACTURER'S STANDARD DARK BRONZE
STUCCO:	COLOR TO MATCH FEDERAL STANDARD 595A - 37769 (LIGHT BEIGE).
BRICK:	RIGHTEX BRICK #223 - FLASHED RED WIRE CUT SOUTHERN BRICK #355 - FLASHED RED WIRE CUT PALMETTO BRICK - WIRE CUT FULL RANGE
SPLIT FACE CMU:	LIGHT BEIGE
METAL DOORS & FRAMES:	COLOR TO MATCH FEDERAL STANDARD 595B - 10062 (DARK BRONZE).
MISC. METALS, HANDRAILS, CONDUITS, ETC.	COLOR TO MATCH FEDERAL STANDARD 595B 10062 (DARK BRONZE).
ALUMINUM STOREFRONT & WINDOWS:	DARK BRONZE
SOFFITS:	WHITE
ROOFTOP EQUIPMENT:	PAINT TO MATCH ROOF COLOR
FACIAS, GUTTERS AND DOWNSPOUTS:	MANUFACTURER'S STANDARD DARK BRONZE
ALUMINUM TRELLIS	DARK BRONZE

Rev.	Date	Appr'd.	Prep. By	Description
1	5/14/04	DL	DL	AS-BUILT BRG. NO CORRECTIONS

CHARLESTON AIR FORCE BASE  
DINING FACILITY  
EXTERIOR ELEVATIONS


APPROVED: *R. J. [Signature]* DATE: 5/14/04

Naval Facilities Engineering Command  
Southern Division  
Charleston, South Carolina


STATE OF SOUTH CAROLINA  
CLICK/BOEHM & ASSOCIATES, INC.  
REGISTERED ARCHITECT

RECORD DRAWING DATE: 9/27/04  
CODE I.D. NO.: 80091  
DRAWING SIZE: D  
SPEC. NO. 08-98-0939  
CONSTR. CONTR. NO.: N62467-98-C-0939  
NAVFAC DRAWING NO.: 5357888  
SHEET 63 OF 194

A-201

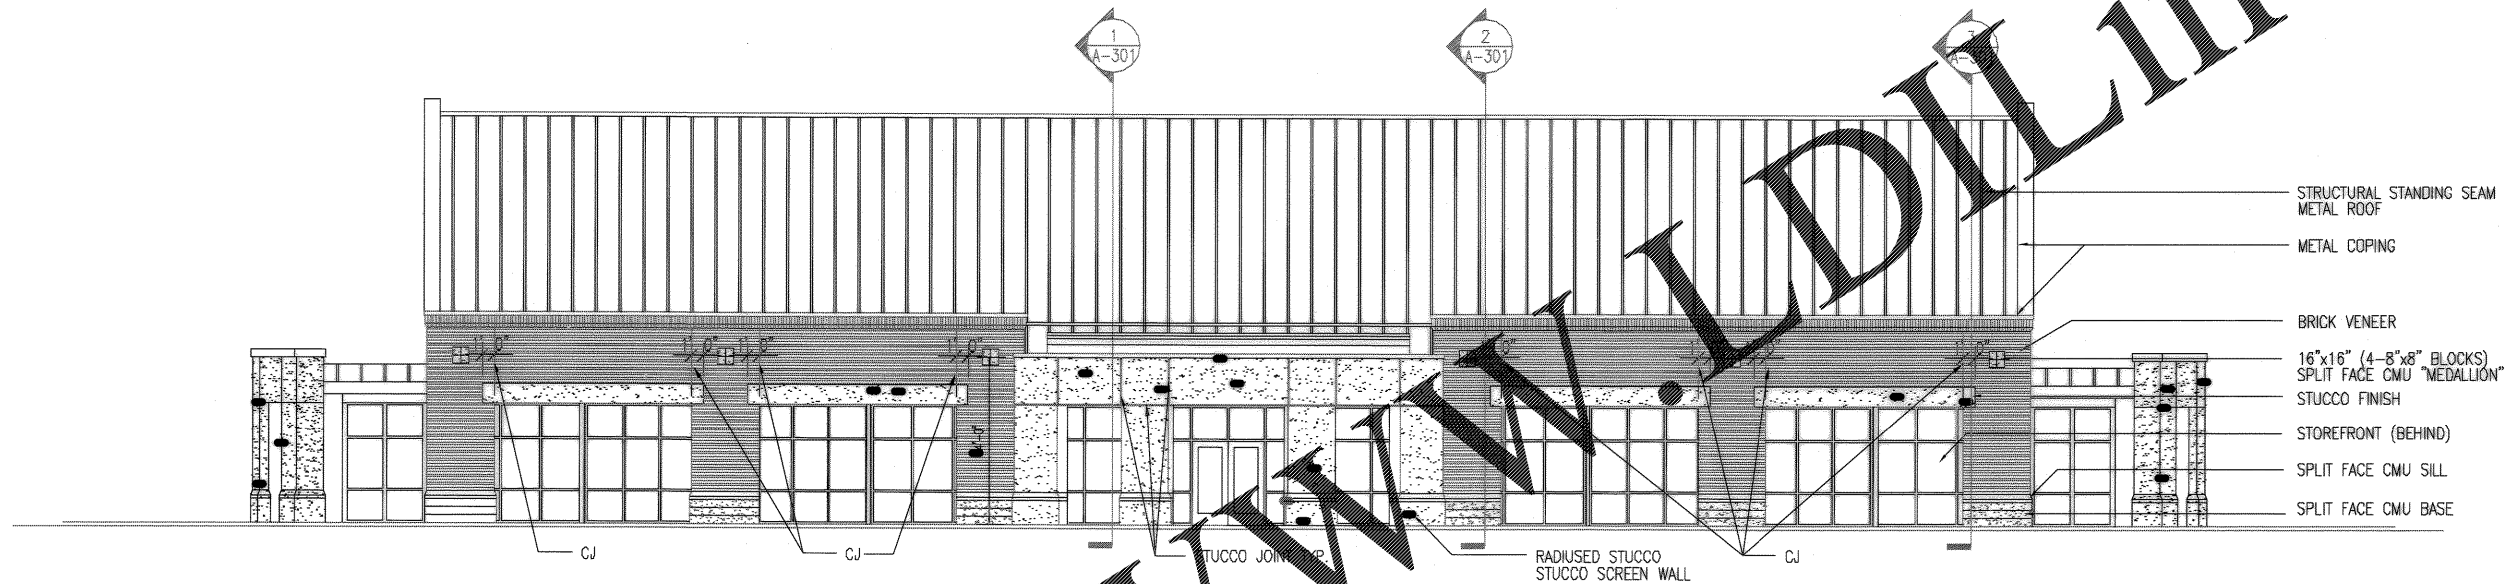


WEST ELEVATION  
1/8"=1'-0"  
\* A-102A-103A-104

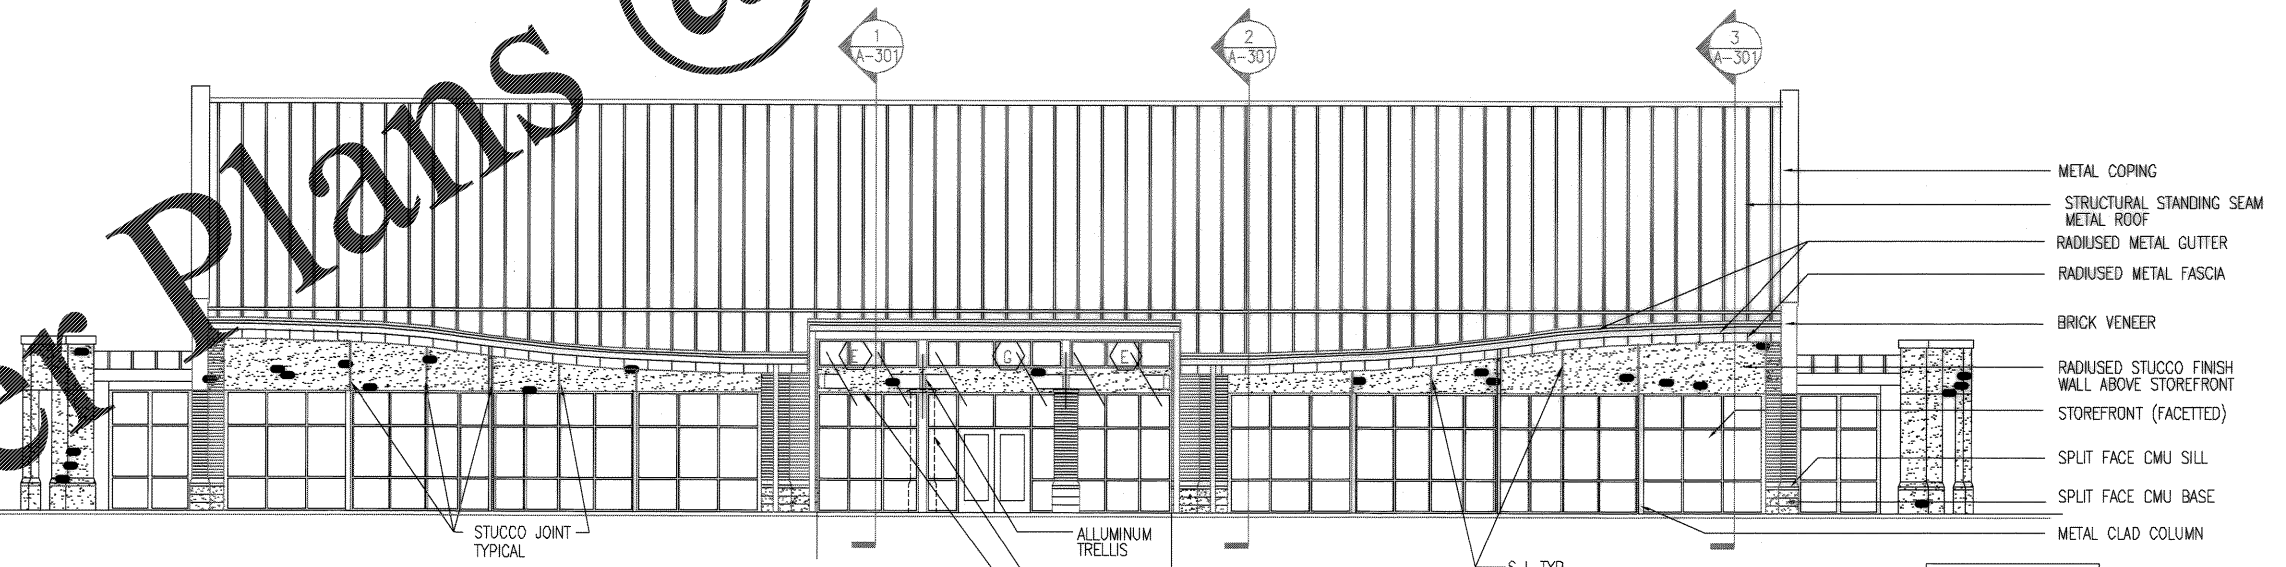

WEST ELEVATION WITHOUT SCREEN WALL  
1/8"=1'-0"  
\* A-102A-103A-104

NOTE:  
C.J.-CONTROL JOINT  
SEE 2B/A-501  
S.J.-STUCCO JOINT  
SEE 2A/A-501

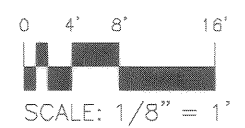

Order Plans @

WWW.DLine.com