


Order Plans @ www.IDOnline.com

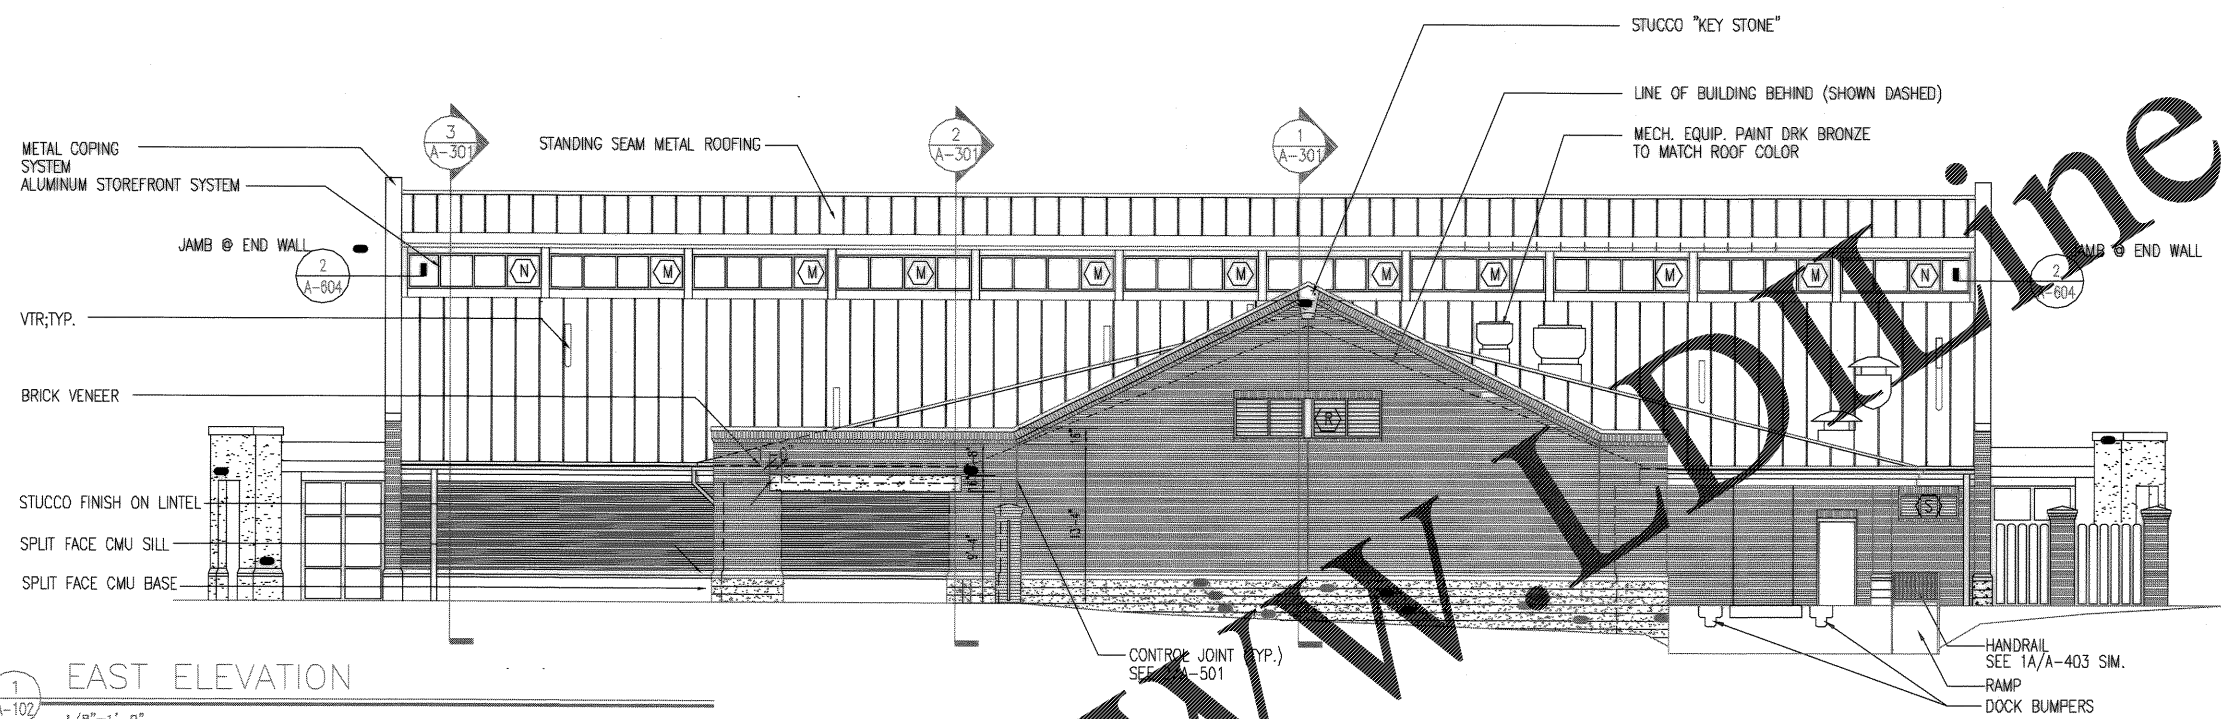

1 EAST ELEVATION
A-102 1/8" = 1'-0"

LEGEND
 (X) WINDOW MARK, SEE SCHEDULE ON SHEET A-601
 C.J. CONTROL JOINT SEE 2/A-501

DRAWING REVISIONS Description Rev. 1 AS-BUILT DRAWING NO CORRECTIONS	Date 5/14/04	Prep By JAH	Appr. By JAH	Project No. 577-6377	Designer BOEHM	Checker BOEHM	Date 5/14/04	Submitted By SULLIVAN	Title ARCHITECT	Scale ME. RES. 3-23-98
	CHARLESTON AIR FORCE BASE CHARLESTON, SOUTH CAROLINA DINING FACILITY EXTERIOR ELEVATIONS APPROVED: <i>R.M. P.</i> DATE: 5/14/04 ETD FOR COMMANDER, NAVFAC Southern Division Charleston, South Carolina Naval Facilities Engineering Command									
STATE OF SOUTH CAROLINA CLICK/BOEHM & ASSOCIATES, INC. CHARLESTON NO. B-80005 REGISTERED ARCHITECT										
RECORD DRAWING DATE CODE I.D. NO. 80091 DRAWING SIZE: D SPEC. NO. 05-98-0939 CONSTR. CONTR. NO. N62467-9B-C-0939 NAVFAC DRAWING NO. 5357890 SHEET 65 OF 194										
SCALE: 1/8" = 1' 0 4' 8' 16' A-203										