




1 WALL SECTION  
A-301 3/4"=1'-0"

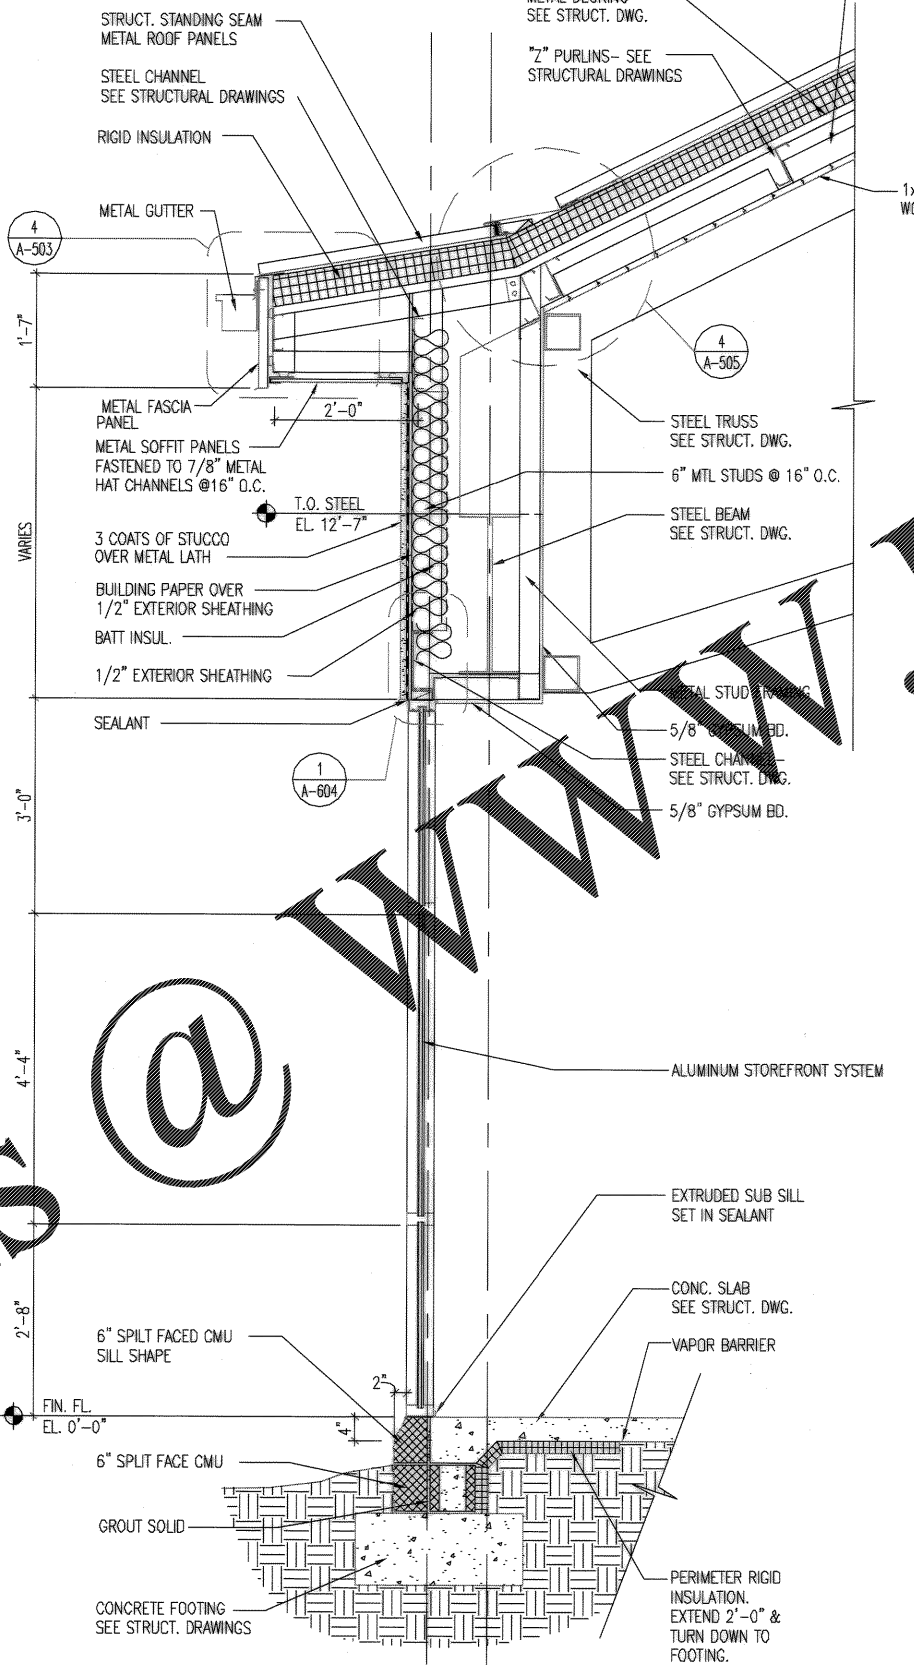

2 WALL SECTION  
A-301 3/4"=1'-0"

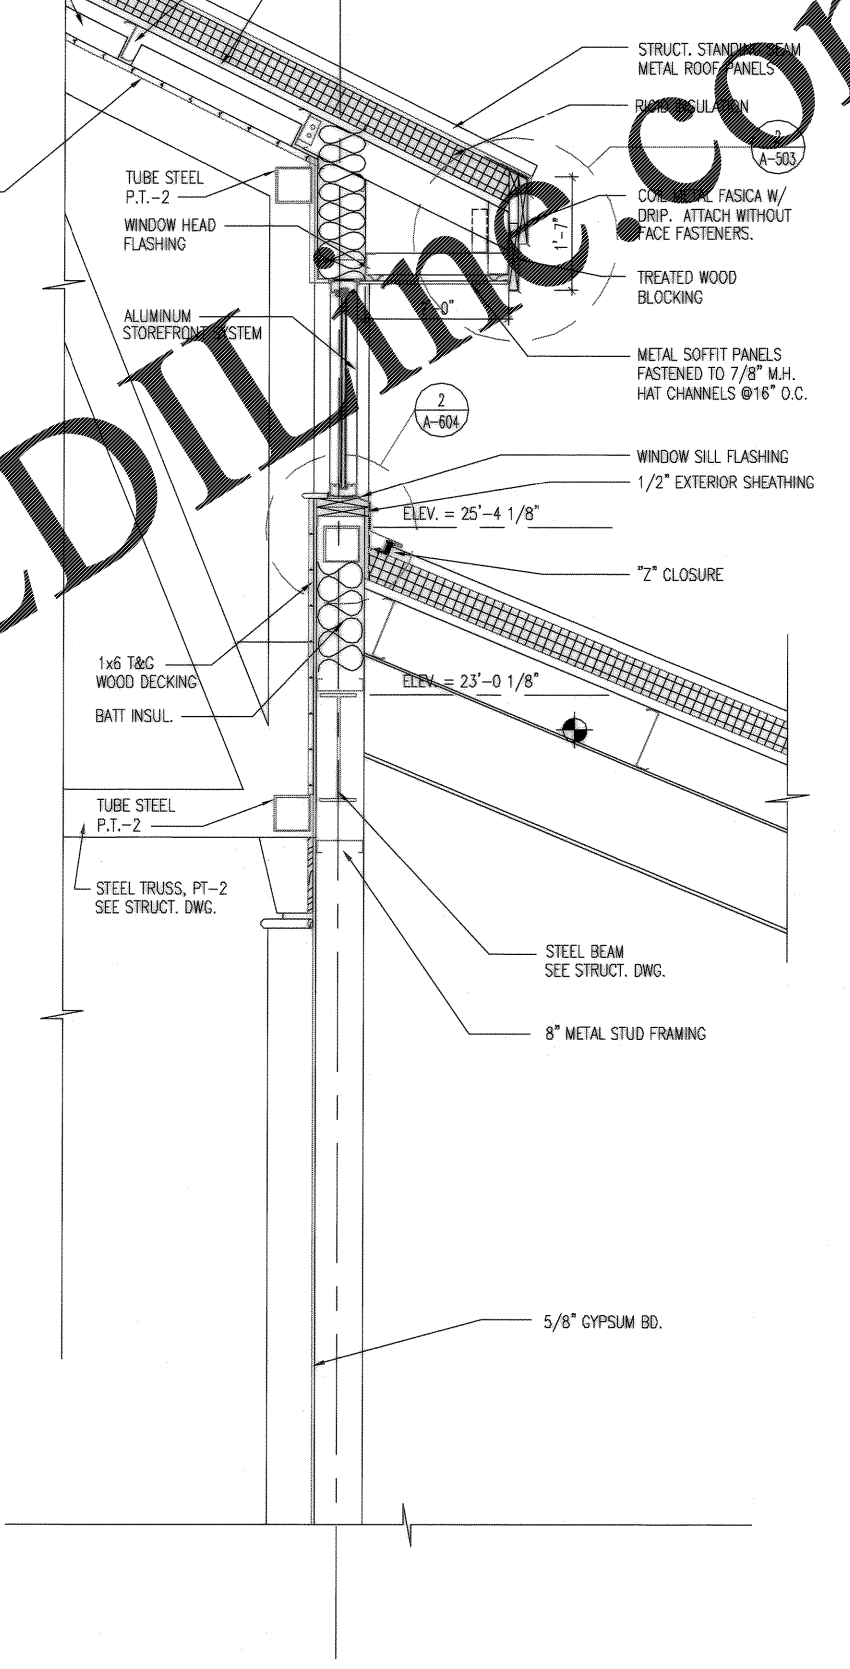

3 WALL SECTION  
A-301 3/4"=1'-0"

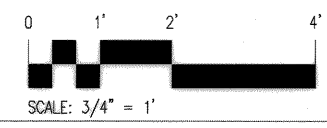

DRAWING REVISIONS  
 Description  
 Rev. 1 AS-BUILT DRWG. NO CORRECTIONS  
 Rev. 2  
 Rev. 3  
 Rev. 4  
 Rev. 5  
 Rev. 6  
 Rev. 7  
 Rev. 8  
 Rev. 9  
 Rev. 10

CHARLESTON AIR FORCE BASE  
 CHARLESTON, SOUTH CAROLINA  
 DINING FACILITY  
 WALL SECTIONS

APPROVED: *RD Davis* DATE: 5/1/04  
 PREP BY: *MM Miller*  
 CHECKED BY: *MM Miller*  
 DATE: 5/1/04  
 SUBMITTED BY: *MM Miller*  
 DATE: 5/1/04  
 APPROVED BY: *MM Miller*  
 DATE: 5/1/04

Naval Facilities Engineering Command  
 Southern Division  
 Charleston, South Carolina

STATE OF SOUTH CAROLINA  
 CLICK/BOEHM & ASSOCIATES, INC.  
 CHARLESTON  
 NO. B-80005  
 REGISTERED ARCHITECT

RECORD DRAWING DATE: 9/27/04  
 CODE I.D. NO.: 80091  
 DRAWING SIZE: D  
 SPEC. NO. 06-98-0939  
 CONSTR. CONTR. NO.: N62467-98-C-0939  
 NAVFAC DRAWING NO.: 5357893  
 SHEET 68 OF 194  
 A-303