
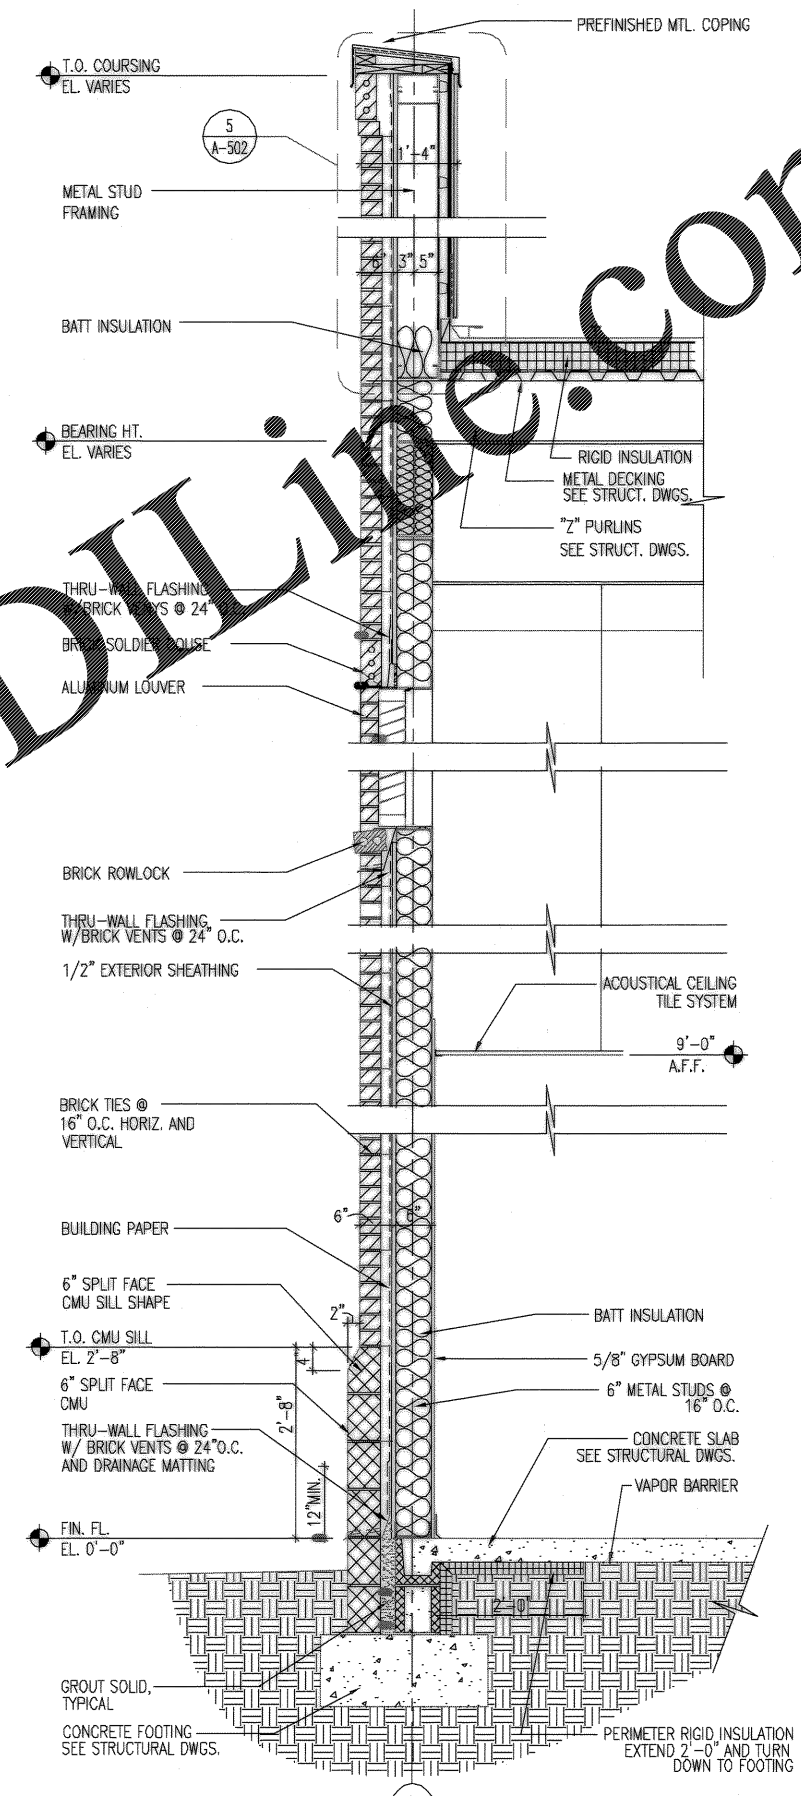
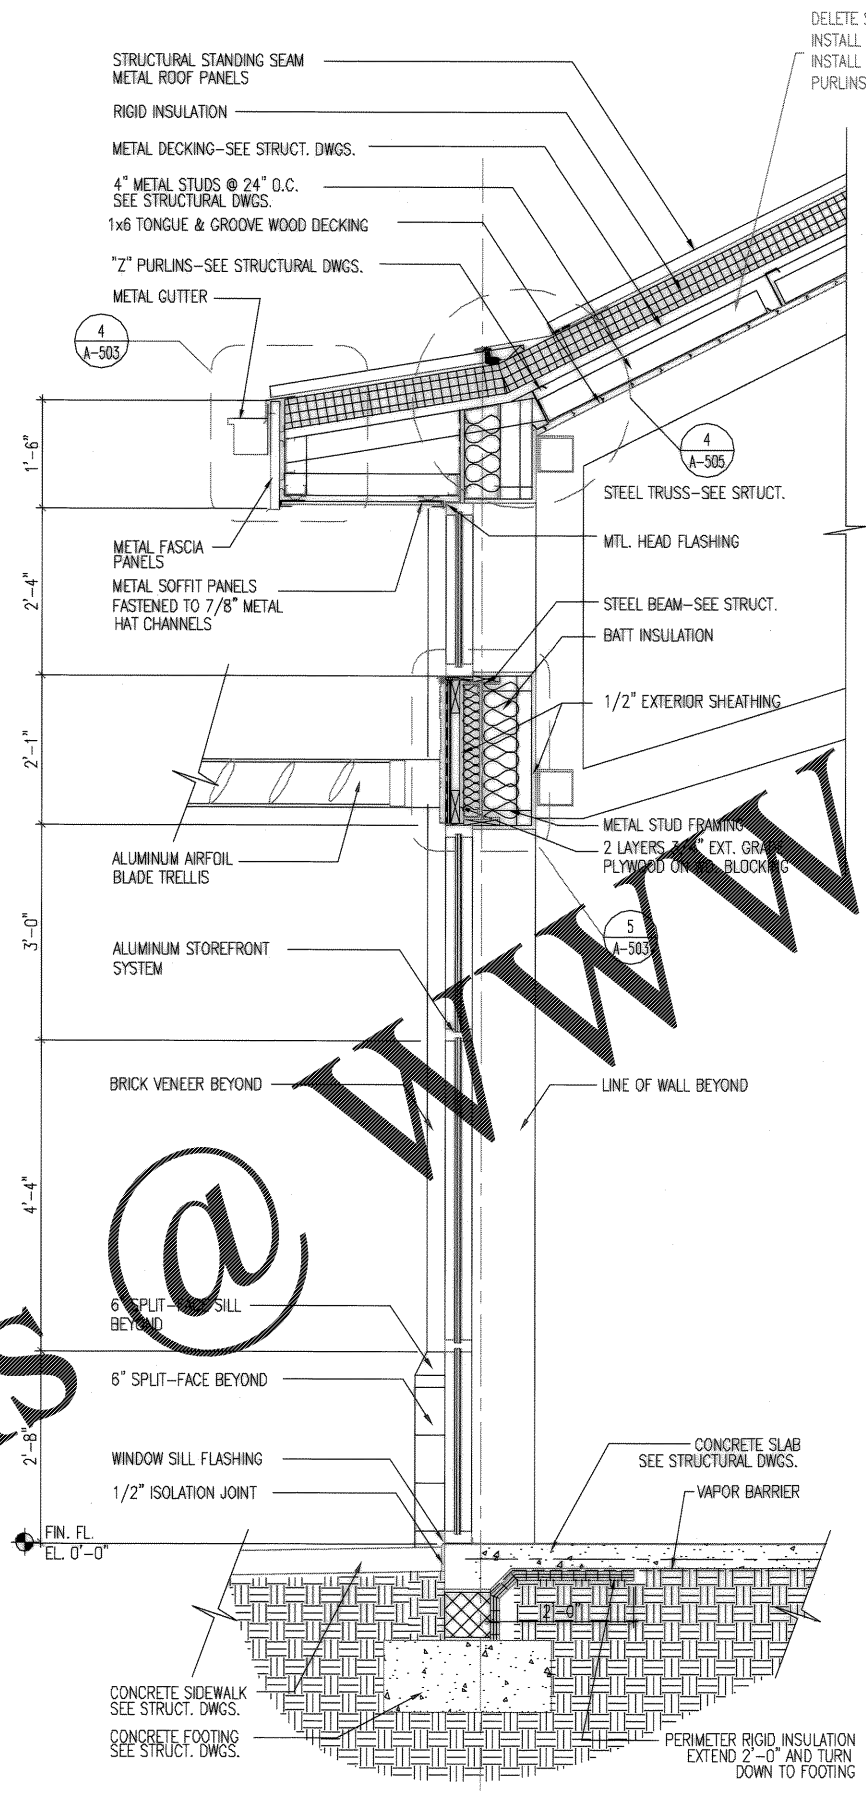
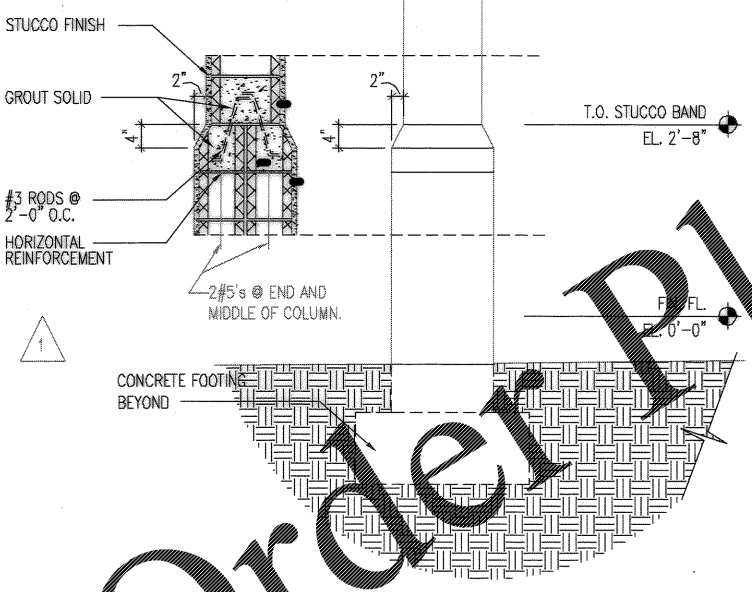



WWW.LDOnline.com

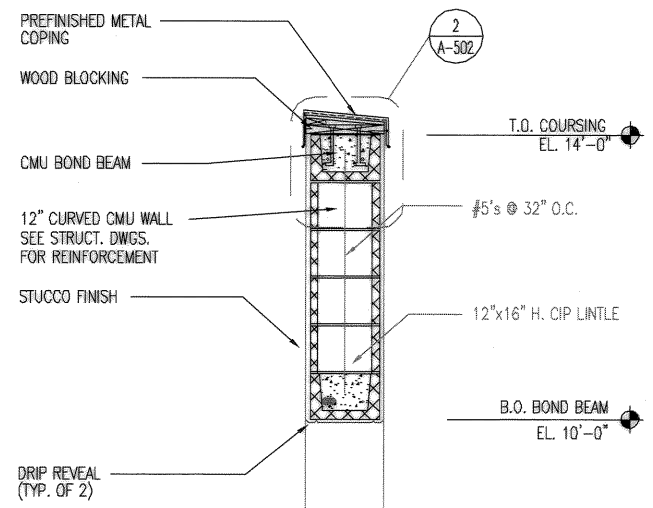

1 WALL SECTION
A-305 3/4" = 1'-0"

2 WALL SECTION
A-305 3/4" = 1'-0"

3 WALL SECTION
A-305 3/4" = 1'-0"

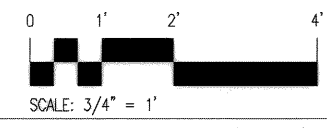

DRAWING REVISIONS Description Rev. 1 DATE 5/15/04 BY DRB/BOEIM CHECK BOEIM APPROVED BY SULLIVAN DATE 5/15/04 SUBMITTED BY (FIRM NUMBER-TITLE) (FIRM)		CHARLESTON AIR FORCE BASE CHARLESTON, SOUTH CAROLINA DINING FACILITY WALL SECTIONS APPROVED RD M... DATE 5/15/04 ETD FOR COMMANDR. NAVFAC
RECORD DRAWING DATE 9/27/04 CODE I.D. NO. 80091 DRAWING SIZE: D SPEC. NO. 06-98-0939 CONSTR. CONTR. NO. N62467-98-C-0939 NAVFAC DRAWING NO. 5357895 SHEET 70 OF 194		STATE OF SOUTH CAROLINA Glick/Boehm & Associates, Inc. REGISTERED ARCHITECT CHARLESTON NO. B-80005