



**GENERAL NOTES**

1. TRELLIS MANUFACTURER SHALL PROVIDE SPACERS, WASHERS, COATINGS, ETC. AS REQUIRED TO PREVENT CONTACT BETWEEN DISSIMILAR METALS.
2. ALL ALUMINUM SHALL HAVE A WHITE KYNAR FINISH. ALL OTHER METALS SHALL BE PAINTED WHITE TO MATCH ALUMINUM.

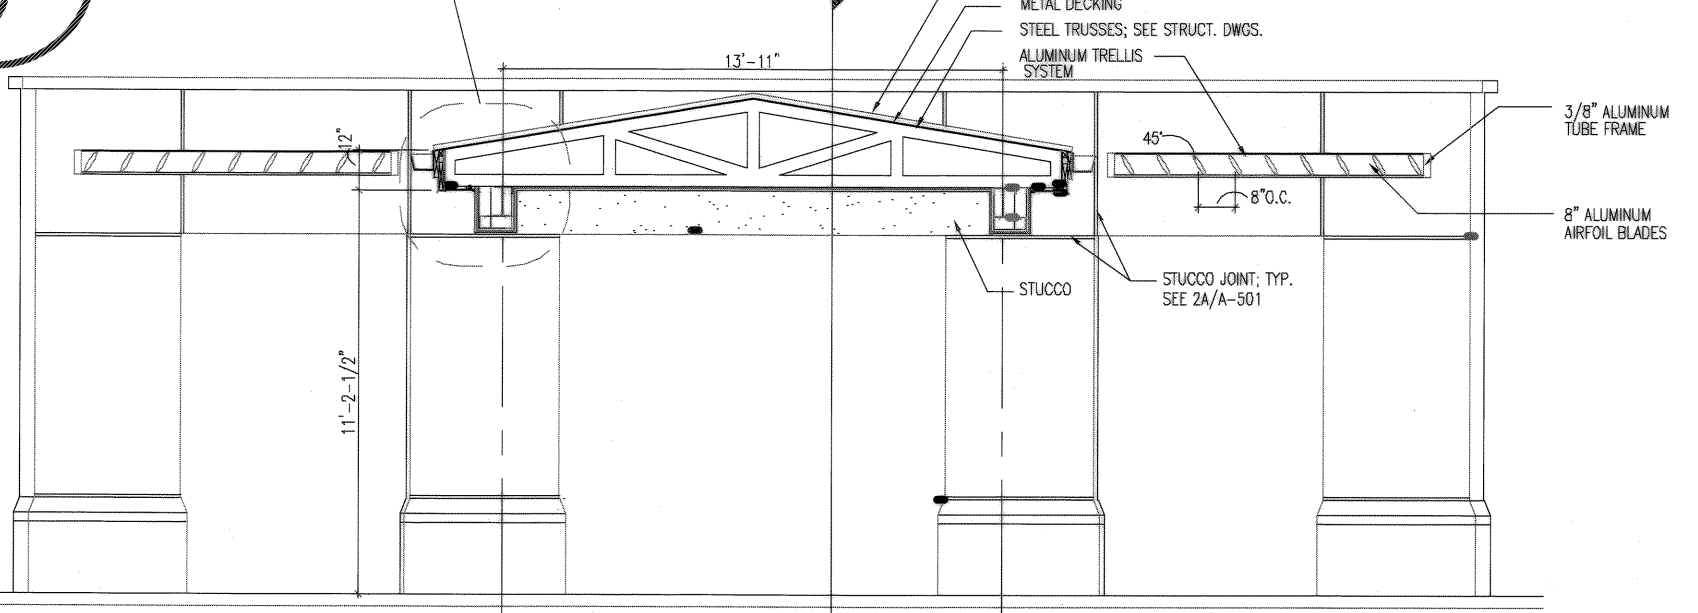

1 WALL SECTION  
3/4"=1'-0"

3 WALL SECTION  
3/8"=1'-0"

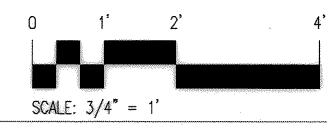

DRAWING REVISIONS		DATE	BY	CHK	APP
1	DRWG. CORRECTED TO AS-BUILT	5/11/04	KUH	BOEHM	BOEHM
DESCRIPTION		DATE	BY	CHK	APP
DRWG. CORRECTED TO AS-BUILT		5/11/04	KUH	BOEHM	BOEHM
APPROVED		DATE	BY	CHK	APP
ED FOR COMMANDER, NAVFAC		5/11/04	RE	BOEHM	BOEHM
CHARLESTON AIR FORCE BASE		SOUTH CAROLINA			
DINING FACILITY		WALL SECTIONS			
Naval Facilities Engineering Command		Southern Division			
Southern Division		Charleston, South Carolina			
STATE OF SOUTH CAROLINA		REGISTERED ARCHITECT			
CLICK/BOEHM & ASSOCIATES, INC.		CHARLESTON NO. B-80008			
RECORD DRAWING DATE	9/27/04				
CODE I.D. NO.	80091				
DRAWING SIZE	D				
SPEC. NO.	06-98-0939				
CONSTR. CENTR. NO.	N62467-9B-C-0939				
NAVFAC DRAWING NO.	5357897				
SHEET	72 OF 194				
A-307					