


1 STEEL LADDER DETAIL  
1"=1'-0"

2 STEEL LADDER DETAIL  
1"=1'-0"

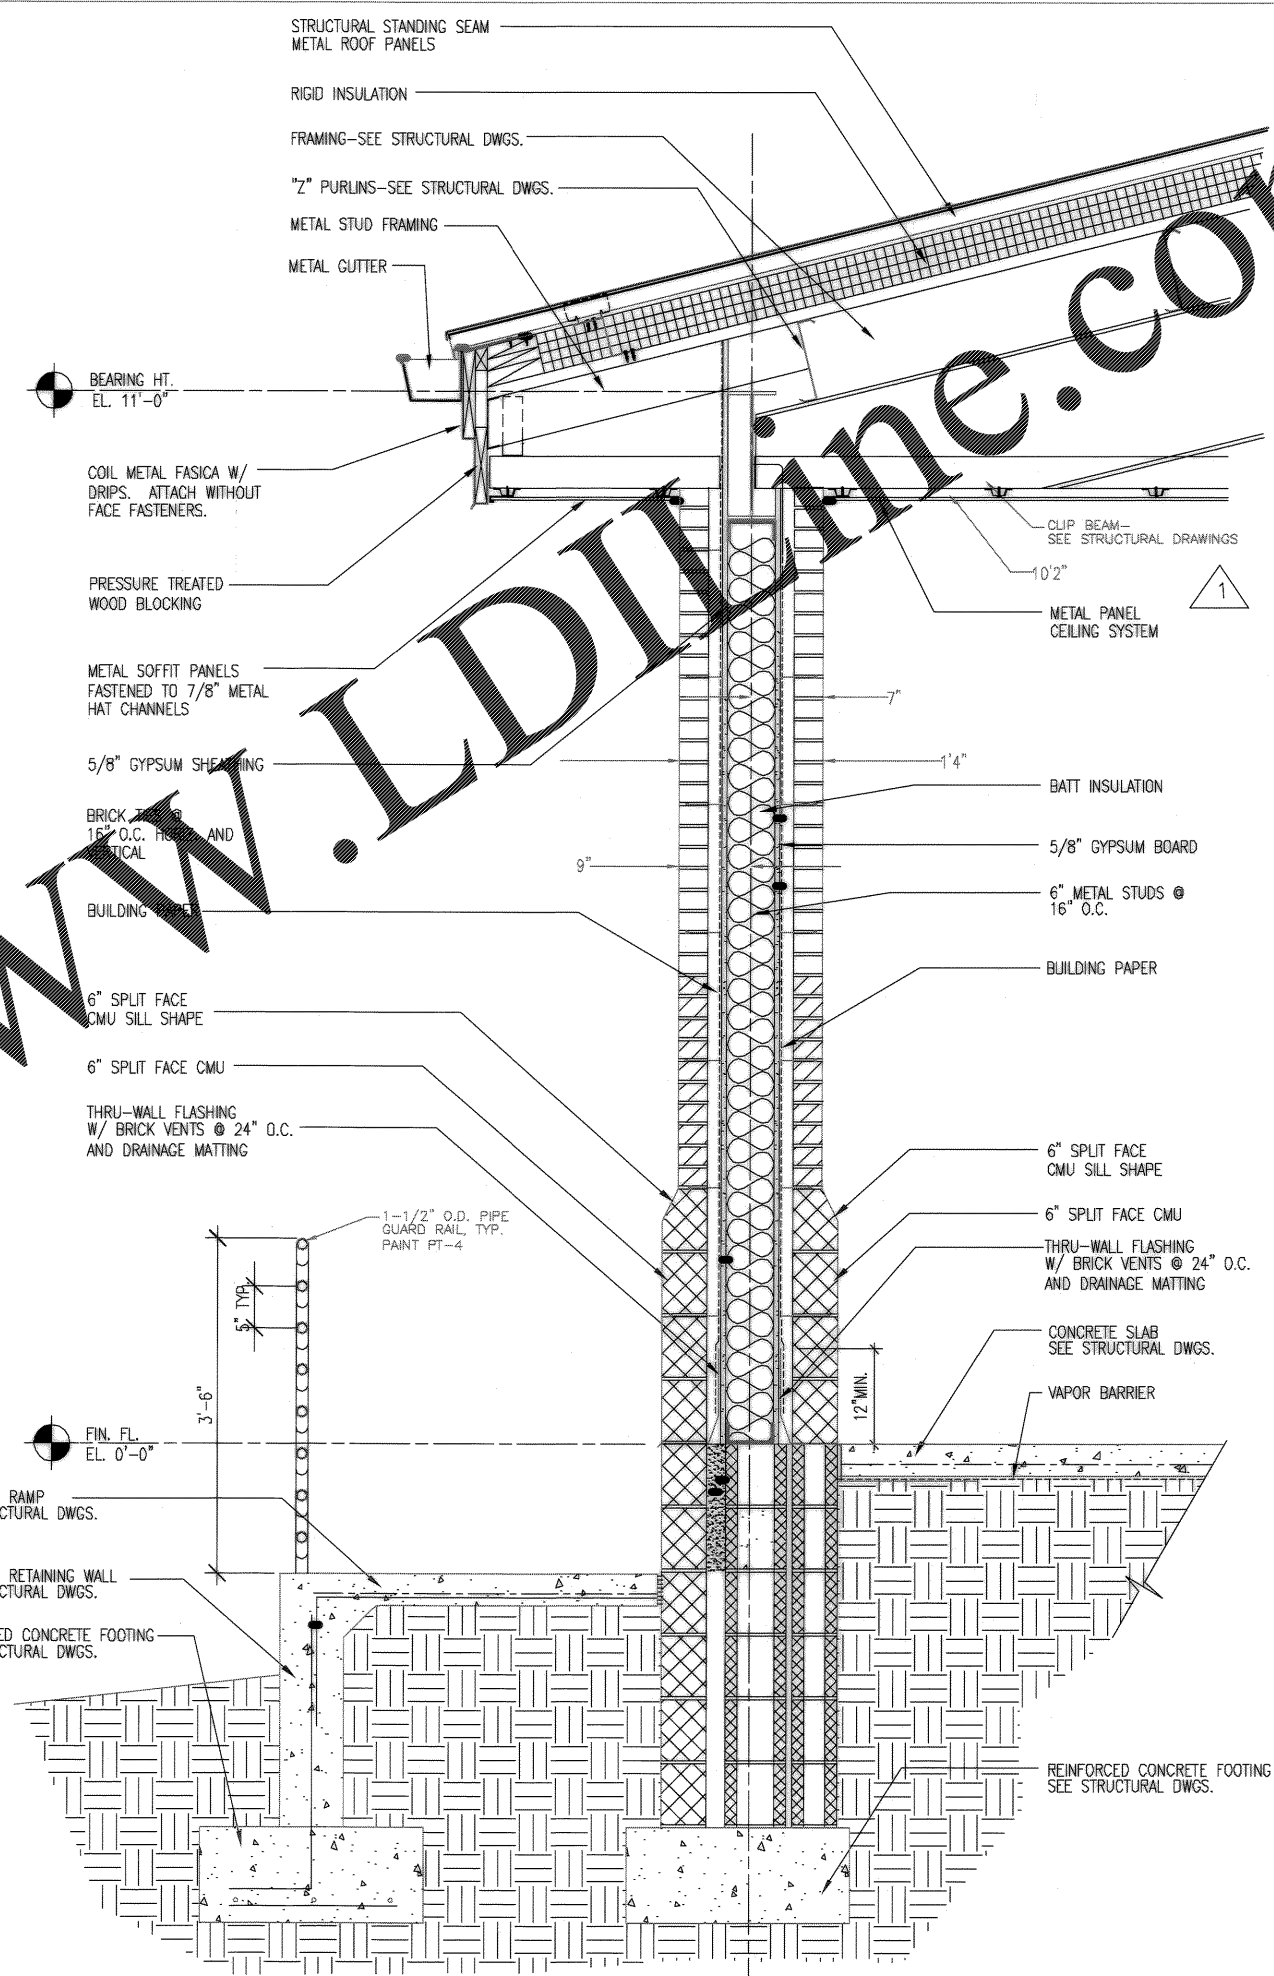

Order Plans @ WWW.LDIDLINE.COM

|                                                                                                                                                                                                                                                                         |                             |         |         |        |         |                             |
|-------------------------------------------------------------------------------------------------------------------------------------------------------------------------------------------------------------------------------------------------------------------------|-----------------------------|---------|---------|--------|---------|-----------------------------|
| DRAWING REVISIONS                                                                                                                                                                                                                                                       |                             | Prep By | Date    | Apprv. | DATE    | DESCRIPTION                 |
| 1                                                                                                                                                                                                                                                                       | DRWG. CORRECTED TO AS-BUILT | MM      | 5/10/04 | MM     | 5/10/04 | DRWG. CORRECTED TO AS-BUILT |
| Glick/Boehm & Associates, Inc.<br>247 Meeting Street<br>Charleston, S.C. 29401<br>(803) 577-6377<br>FAX (803) 577-6377<br>WWW.LDIDLINE.COM                                                                                                                              |                             |         |         |        |         |                             |
| DESIGNER: Glick/Boehm & Associates, Inc.<br>CHECKED: Glick/Boehm & Associates, Inc.<br>DRAWN: Glick/Boehm & Associates, Inc.<br>SUBMITTED BY (FIRM NUMBER-TITLE): Glick/Boehm & Associates, Inc.<br>DATE: 5/10/04<br>APPROVED: [Signature]<br>EFD FOR COMMANDER, NAVFAC |                             |         |         |        |         |                             |
| CHARLESTON AIR FORCE BASE<br>CHARLESTON, SOUTH CAROLINA<br>DINING FACILITY<br>WALL SECTION & MISC. DETAILS                                                                                                                                                              |                             |         |         |        |         |                             |
| Naval Facilities Engineering Command<br>Southern Division<br>Charleston, South Carolina                                                                                                                                                                                 |                             |         |         |        |         |                             |
| STATE OF SOUTH CAROLINA<br>Glick/Boehm & Associates, Inc.<br>CHARLESTON<br>NO. B-80006<br>REGISTERED ARCHITECT                                                                                                                                                          |                             |         |         |        |         |                             |
| RECORD DRAWING DATE: 9/27/04<br>CODE I.D. NO.: 80091<br>DRAWING SIZE: D<br>SPEC. NO. 06-98-0939<br>CONSTR. CONTR. NO. N62467-98-C-0939<br>NAVFAC DRAWING NO. 5357898<br>SHEET 73 OF 194                                                                                 |                             |         |         |        |         |                             |
| A-308<br>468-122                                                                                                                                                                                                                                                        |                             |         |         |        |         |                             |