




Order Plans @ WWW.LDLINE.COM

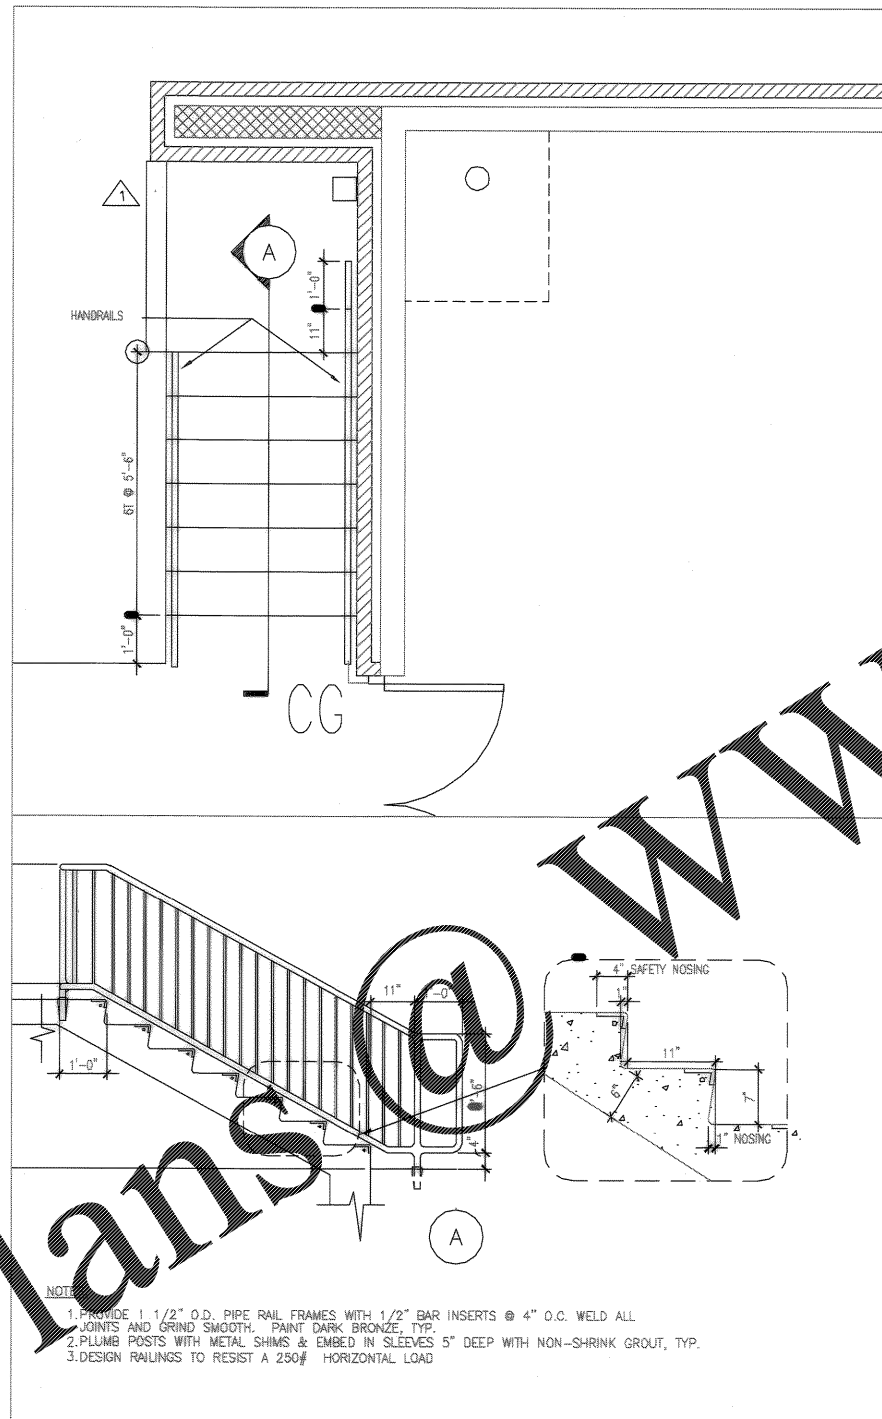

1 ENLARGED STAIR PLAN/SECTION

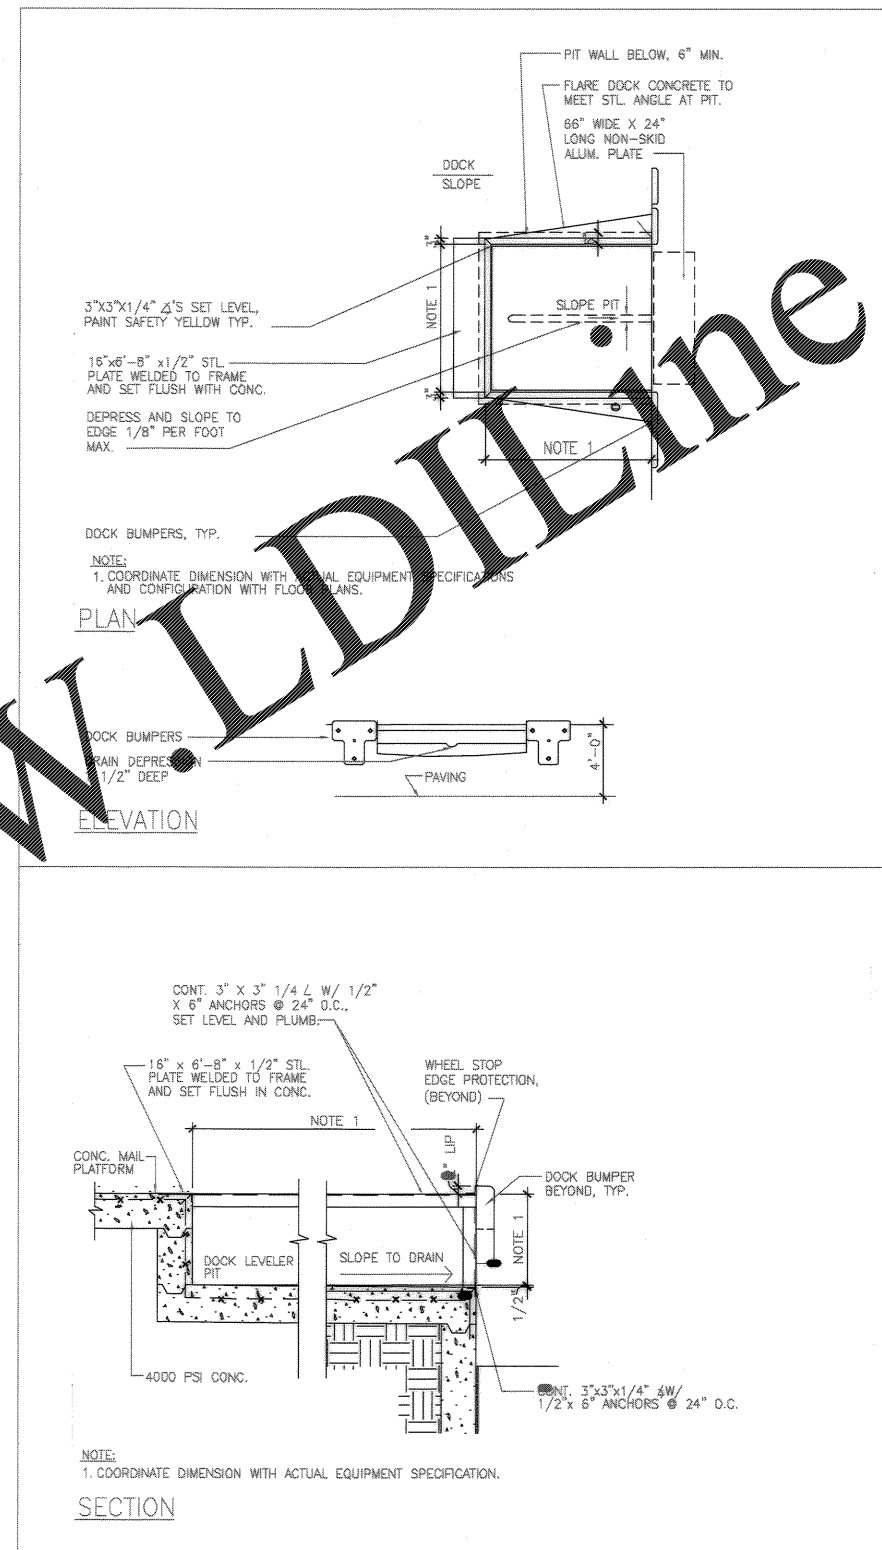

2 DOCK LEVELER PLAN, SECTION & ELEVATION

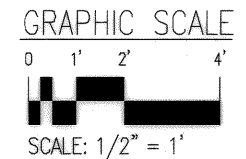

Glick/Boehm & Associates, Inc. 247 Meeting Street Charleston, S.C. 29401 (803) 577-6377 GIB BOEHRM ARCHITECT	
DRAWING REVISIONS Description: DRWG. CORRECTED TO AS-BUILT Rev. 1 Prep By: KAW Date: 5/15/04 Apprd: BOEHRM	CHARLESTON AIR FORCE BASE CHARLESTON, SOUTH CAROLINA DINING FACILITY ENLARGED PLANS APPROVED: R.D. Thomas, Jr. DATE: 5/15/04 EFD FOR COMMANDER, MAFAC
Naval Facilities Engineering Command Southern Division Charleston, South Carolina	STATE OF SOUTH CAROLINA Glick/Boehm & Associates, Inc. CHARLESTON NO. B-80006 REGISTERED ARCHITECT
RECORD DRAWING DATE: 9/27/04 CDDE I.D. NO.: 80091 DRAWING SIZE: D SPEC. NO. 06-98-0939 CONSTR. CONTR. NO.: NS2467-98-C-0939 NAVFAC DRAWING NO.: 5357901 SHEET 76 OF 194	A-403