




Order Plans @ www.LDLINE.com

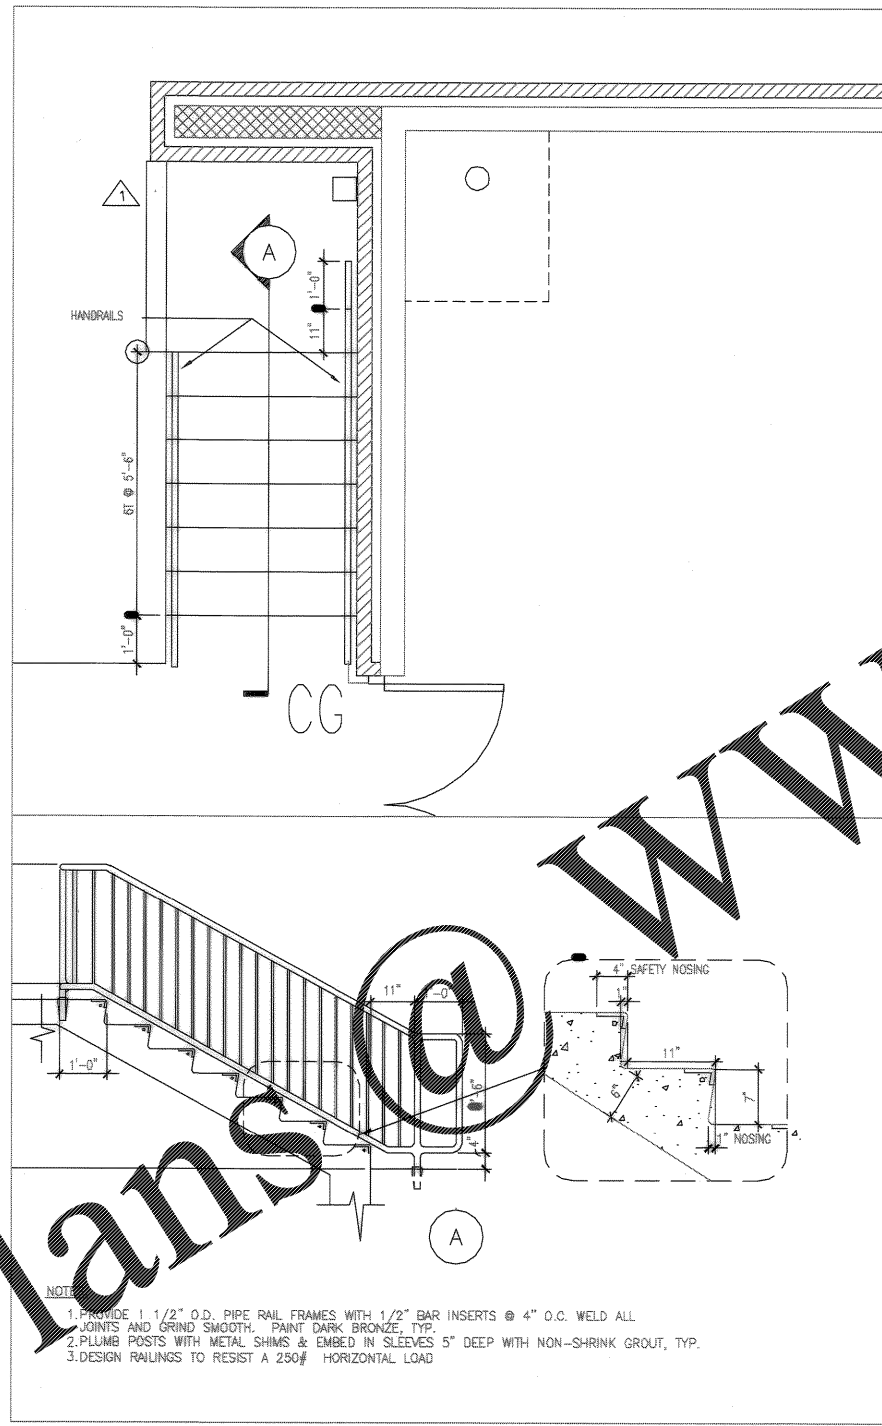

1 ENLARGED STAIR PLAN/SECTION

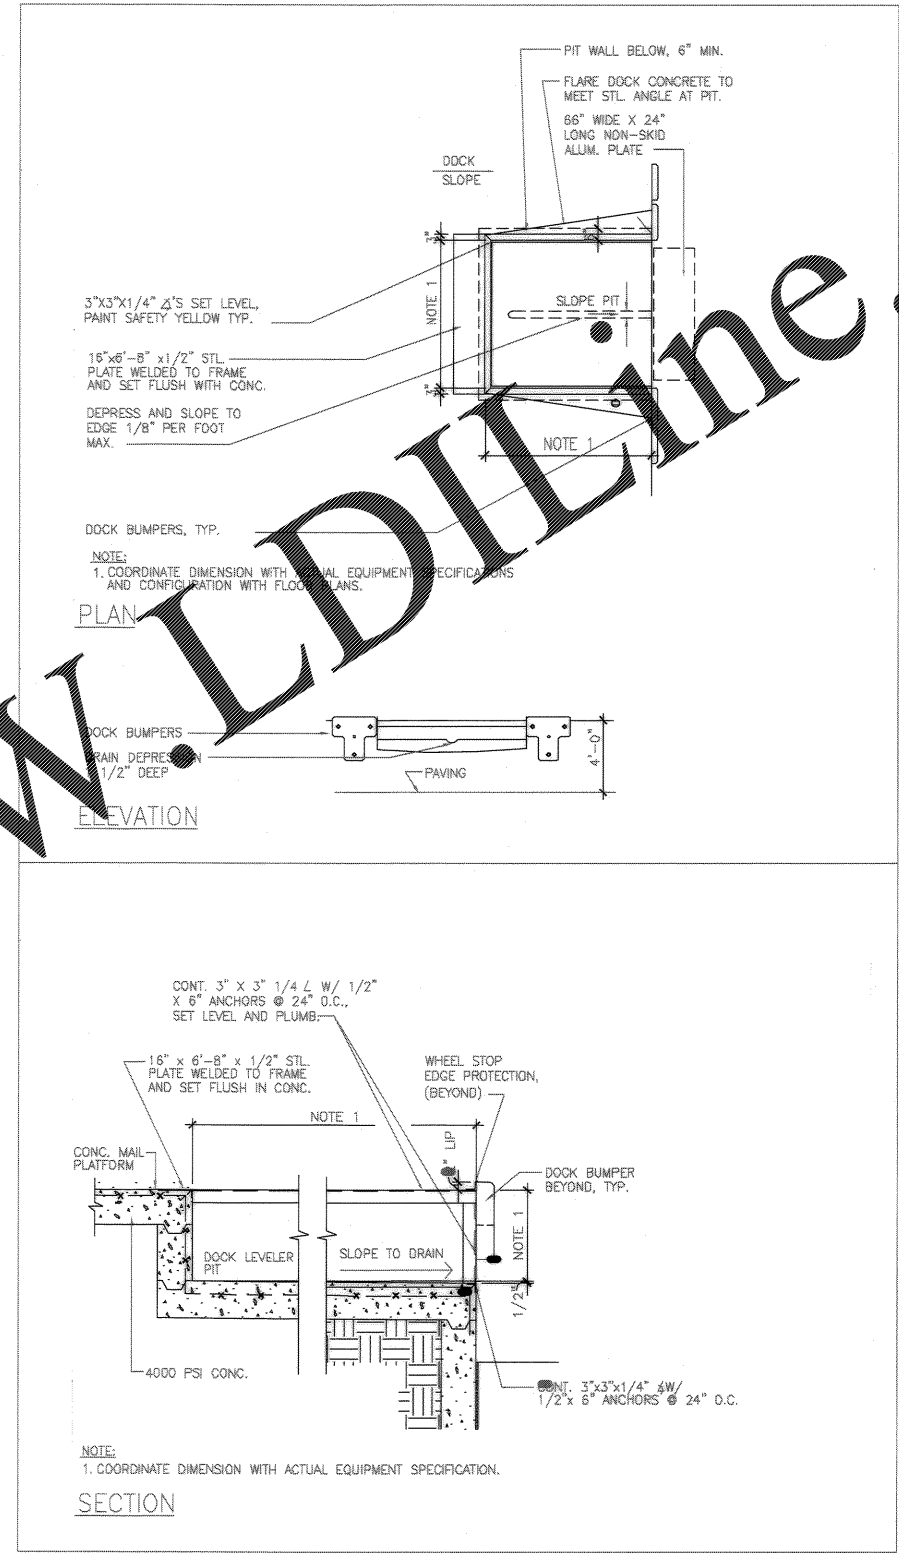

2 DOCK LEVELER PLAN, SECTION & ELEVATION

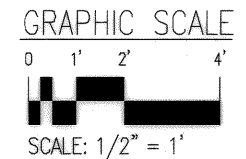

CHARLESTON AIR FORCE BASE CHARLESTON, SOUTH CAROLINA
DINING FACILITY
ENLARGED PLANS

APPROVED: *R.D. Thomas, Jr.* DATE: *5/11/64* EFD FOR COMMANDER, MAFAC

Naval Facilities Engineering Command
Southern Division
Charleston, South Carolina

STATE OF SOUTH CAROLINA
GLICK/BOEHM & ASSOCIATES, INC.
CHARLESTON
NO. B-80006
REGISTERED ARCHITECT

RECORD DRAWING DATE: *9/27/64*
CDDE I.D. NO. 80091
DRAWING SIZE: D
SPEC. NO. 06-98-0939
CONSTR. CONTR. NO. NS2467-98-C-0939
NAVFAC DRAWING NO. 5357901
SHEET 76 OF 194
A-403

DRAWING REVISIONS
Rev. Description Date Apprd. Prep By
1 DRWG. CORRECTED TO AS-BUILT 5/11/64 RDB/BOEHM
2 DRWG. CORRECTED TO AS-BUILT 5/11/64 RDB/BOEHM
3 DRWG. CORRECTED TO AS-BUILT 5/11/64 RDB/BOEHM

Glick/Boehm & Associates, Inc.
247 Meeting Street
Charleston, S.C. 29401
(803) 577-6377
CHK: BOEHM
APP: BOEHM
SUBMITTED BY (FIRM MEMBER-TITLE):
TECHNICAL BRANCH
MCE PRES. P-25-20