





1
A102
INTERIOR ELEVATION
SCALE: 1/4" = 1'-0"

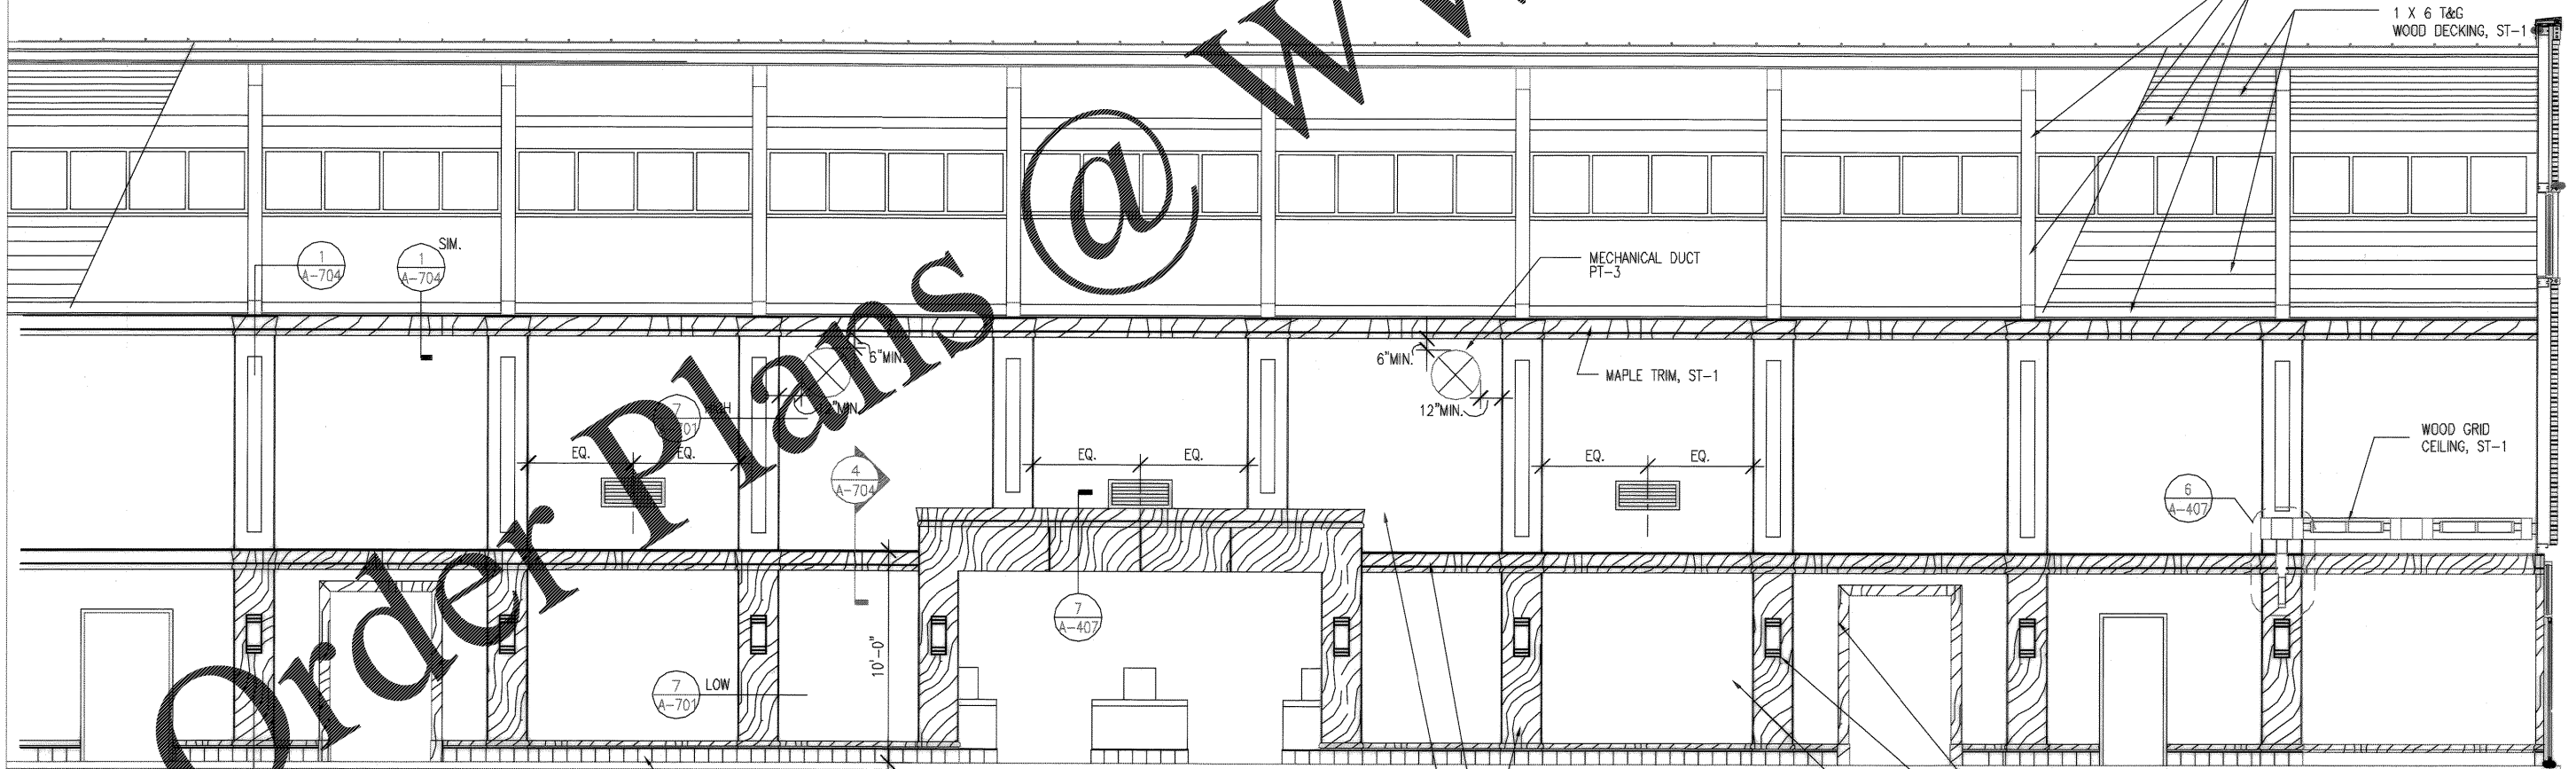

2
A102
INTERIOR ELEVATION
SCALE: 1/4" = 1'-0"

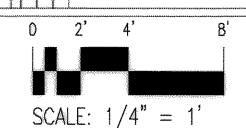

DINING FACILITY
INTERIOR ELEVATIONS

CHARLESTON AIR FORCE BASE CHARLESTON, SOUTH CAROLINA

Naval Facilities Engineering Command
Southern Division
Charleston, South Carolina

APPROVED: *R.D. Davis* DATE: *5/11/64* ETD FOR COMMANDER, NAFAC

Click/Boehm & Associates, Inc.
247 Meeting Street
Charleston, S.C. 29401
(803) 577-6377

Prep By: *AS* Date: *5/11/64* BOEHM
Rev. *AS* Description: *AS-BUILT DRWG. NO CORRECTIONS* BOEHM
CH ENGR. BOEHM
SUBMITTED BY (FIRM MEMBER-TITLE): BOEHM
TECHNICAL BRANCH
VEE FILE: *2-28-64*

RECORD DRAWING DATE: *9/27/64*
ODDE T.D. NO.: 80091
DRAWING SIZE: D
SPEC. NO. 06-98-0939
CONSTR. CONTR. NO. N62467-98-C-0939
NAVFAC DRAWING NO. 5357903
SHEET 78 OF 194

A405

Order Plans @ WWW.WLDLINE.COM