




1 EAVE DETAIL
A-306 SCALE: 3" = 1'-0"

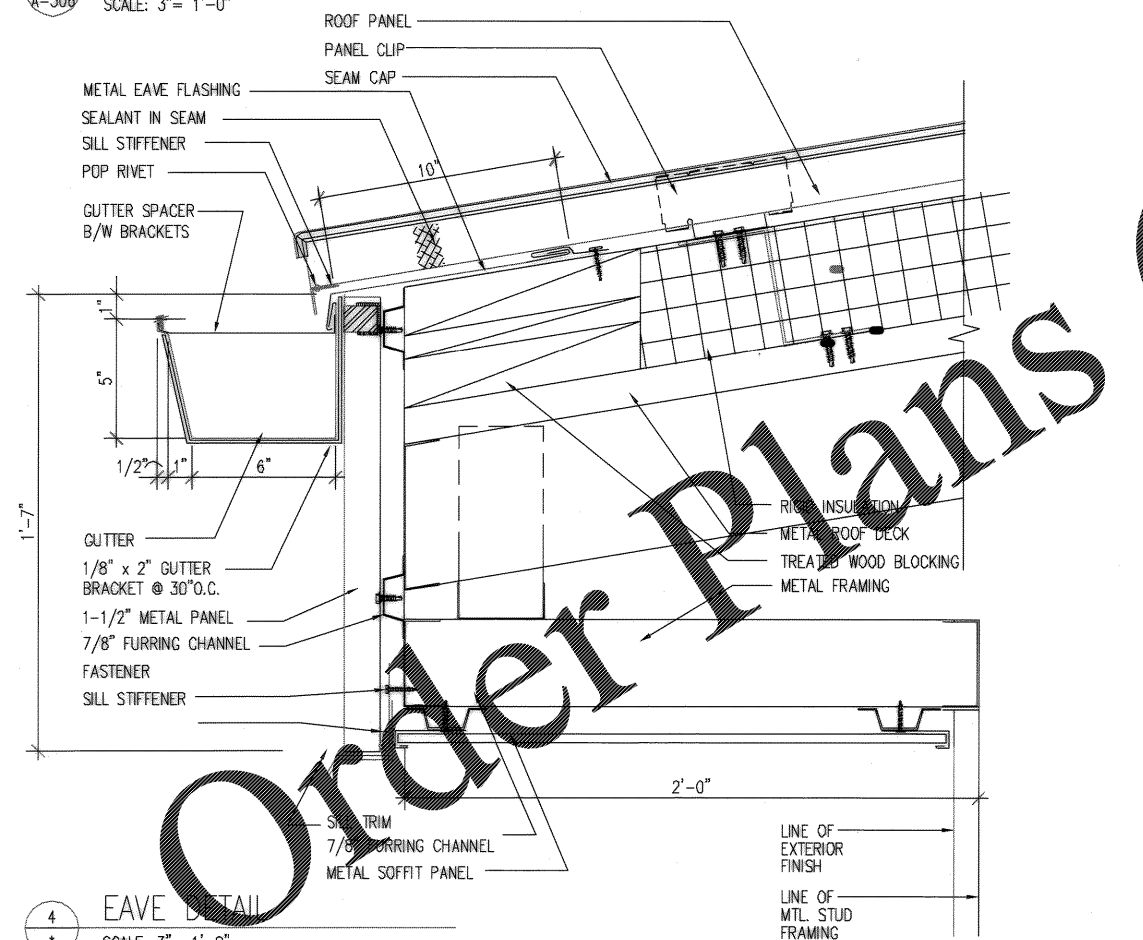


4 EAVE DETAIL
* SCALE: 3" = 1'-0"
* = A-303, A-304, A-305

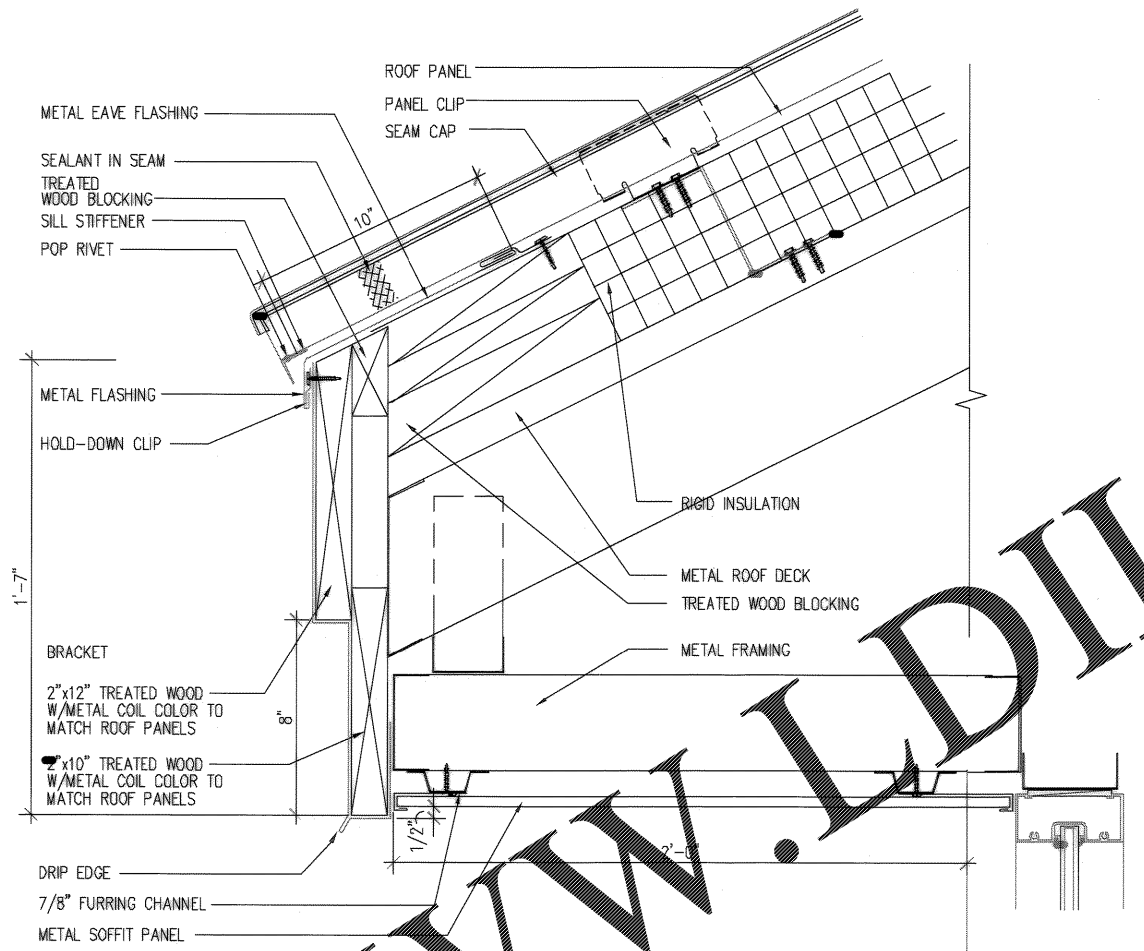


2 EAVE DETAIL
A-303 SCALE: 3" = 1'-0"

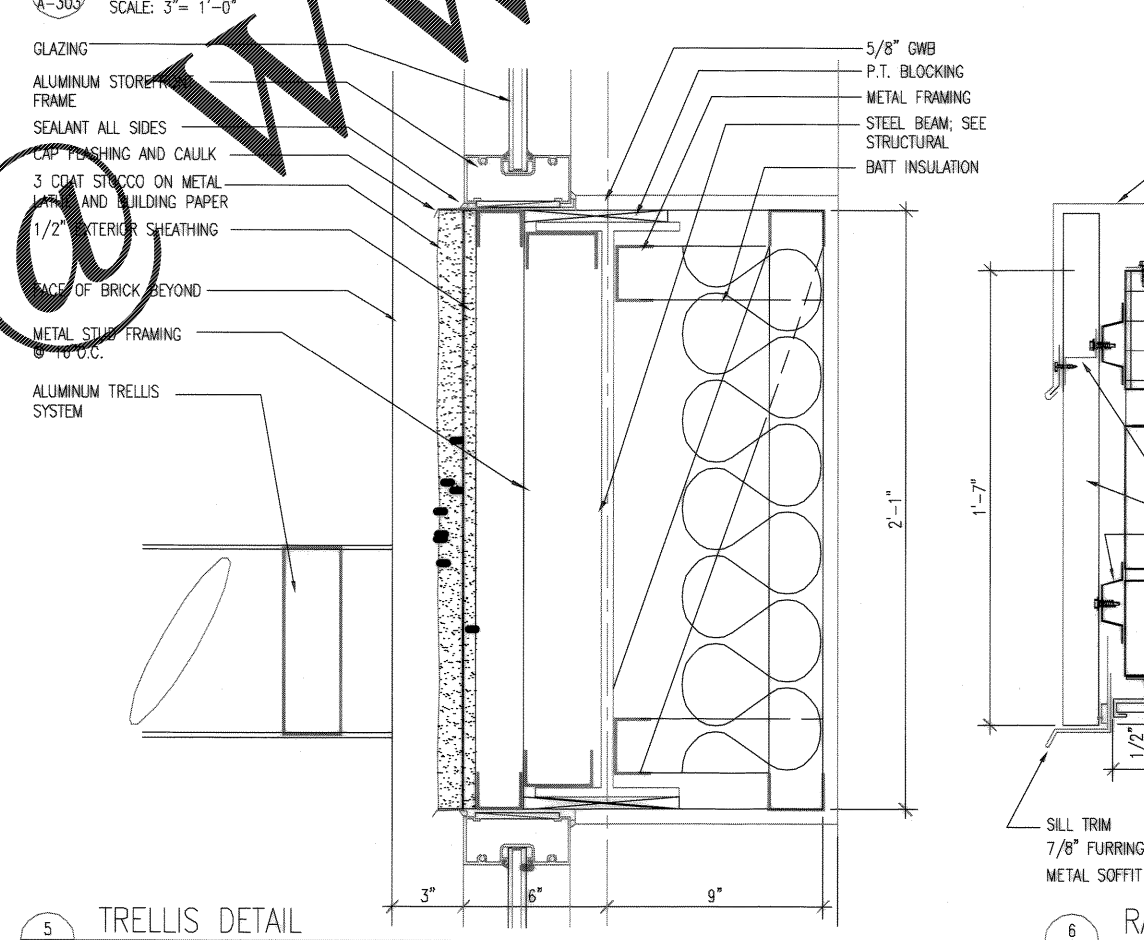

5 TRELLIS DETAIL
A-305 SCALE: 3" = 1'-0"

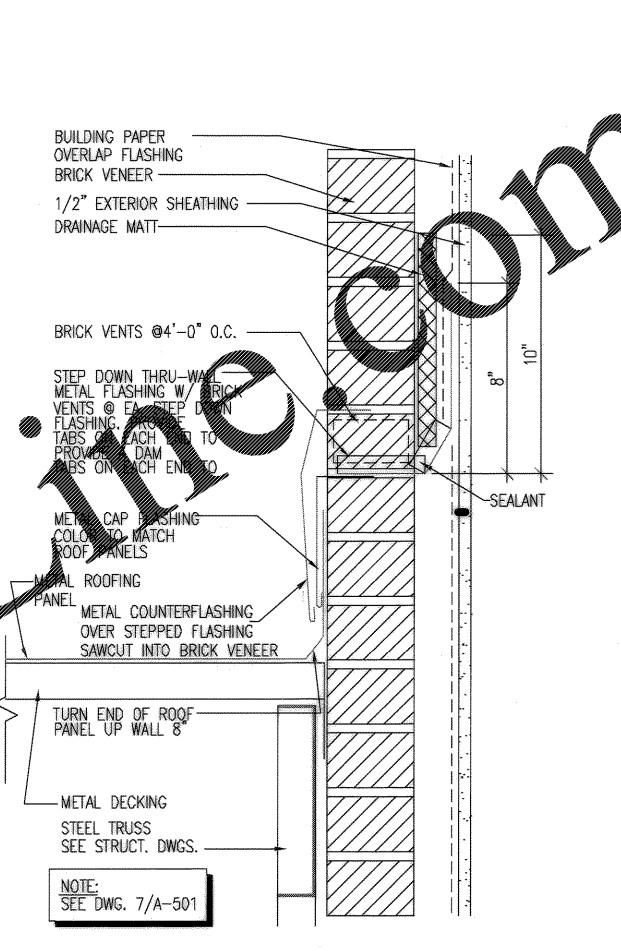

3 FLASHING DETAIL
* SCALE: 3" = 1'-0" * A-306, A-307

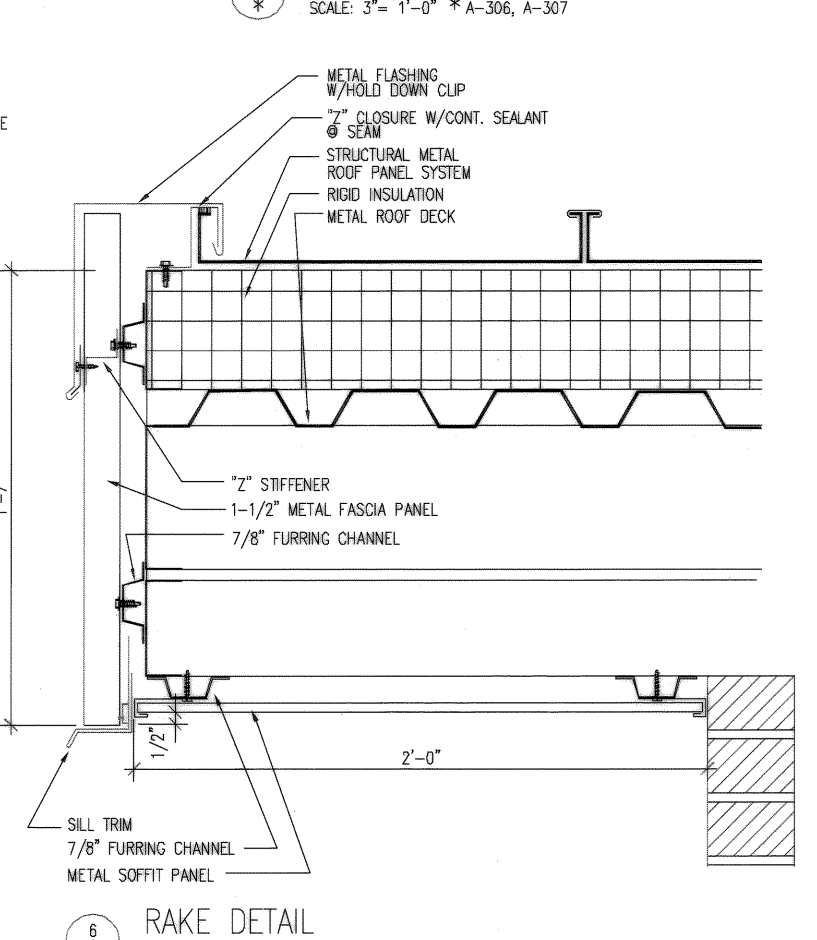

6 RAKE DETAIL
A-104 SCALE: 3" = 1'-0"

Order Plans

WWW.LDILLINE.COM

Glick/Boehm & Associates, Inc.
 247 Meeting Street, Suite 100
 Charleston, S.C. 29401 (803) 577-6377
 DR. BOEHM ARCHITECT
 JUST CH ENR
 SUBMITTED BY (FROM NUMBER-TITLE):
 VICE PRES. 9-25-04
 TECHNICAL BRANCH
 PFE

DRAWING REVISIONS
 Prep By Date Apprd. 10/14/04
 Damagiation: NO CORRECTIONS
 Rev. 1 AS-BUILT DRWG. NO CORRECTIONS

CHARLESTON, SOUTH CAROLINA
 DINING FACILITY
 SECTION DETAILS
 APPROVED: *BD* Plans 2c DATE: 5/11/04
 EFD FOR COMMANDER, NAVFAC

Naval Facilities Engineering Command
 Southern Division
 Charleston, South Carolina

STATE OF SOUTH CAROLINA
 Glick/Boehm & Associates, Inc.
 CHARLESTON
 NO. B-80006
 REGISTERED ARCHITECT

RECORD DRAWING DATE: 9/27/04
 CODE I.D. NO.: 80091
 DRAWING SIZE: D
 SPEC. NO. 05-98-0939
 CONSTR. CONTR. NO.: N62467-98-C-0939
 NAVFAC DRAWING NO.: 5357908
 SHEET 83 OF 194
A-503