


1 ENLARGED TILE LAYOUT  
1/2"=1'-0"

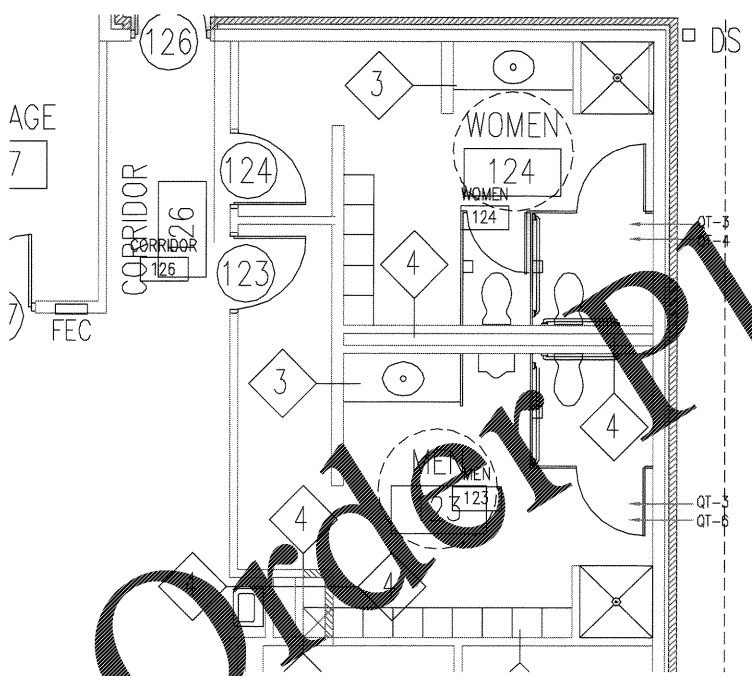

2 ENLARGED TILE LAYOUT  
1/2"=1'-0"

FINISH LEGEND	
ABBR.	DESCRIPTION
ACT-1	ARMSTRONG #589 BEVELED REGULAR CERAMIC TILE, WHITE, 2'X2'X3/4", LAY IN FINE LINE GRID
ACT-2	ARMSTRONG OPTIMA OPEN PLAN, 2'X2'X3/4"
R-1	ROPPE 4" COVE, #91, CAMEL
CPT-1	INVISION CELESTIAL GARDENS MARSHLANDS, #101, 0.87/3/88B/321B/320B
QT-1	QUARRY TILE #NW40, NORTHWEST 2000, "RAVINE", 8"X8"
QT-2	QUARRY TILE #NW15, NORTHWEST 2000, "DIAMOND", 8"X8"
QT-3	QUARRY TILE #NW20, NORTHWEST 2000, "OLYMPIA", 8"X8"
QT-4	QUARRY TILE #NW25, NORTHWEST 2000, "SALMON", 8"X8"
QT-5	QUARRY TILE #NW10, NORTHWEST 2000, "OYSTERS", 8"X8"
QT-6	QUARRY TILE #NW10, NORTHWEST 2000, "COLUMBIA", 8"X8"
CT-1	DALTILE #K165, "ALABAMA", 6"X6"
CT-2	DALTILE #K166, "SCOUT", 6"X6"
CT-3	DALTILE #K167, "CHAMOIS", 6"X6"
CT-4	DALTILE #K174, "MEXICAN SAND", 6"X6"
PT-1	BEVEMAR ARP SURFACE #TM-2 IT "OCHRE TEMPURA" TEXTURED
PT-2	BEVEMAR ARP SURFACE #TM-2 IT "OCHRE TEMPURA" TEXTURED
PT-3	BEVEMAR ARP SURFACE #TM-2 IT "OCHRE TEMPURA" TEXTURED
PT-4	BEVEMAR ARP SURFACE #TM-2 IT "OCHRE TEMPURA" TEXTURED
SS-1	DUPONT CORIAN "BONE"
VCT-1	ARMSTRONG IMPERIAL TEXTURE STD. EXCELON #51839 FORTRESS WHITE
VWC-1	OLNEY #32855 "VISIONS/MINERAL"
VWC-2	INNOVATION'S TROWEL #7409 CO. PUTTY
WT	NANIK WOOD BLINDS, 2", WOOD #1 NATURAL
ST-1	STAIN, NATURAL

NOTES	ABBREVIATIONS	KEY
N1 - NOT USED	CONC - CONCRETE	QT - 1
N2 - SEE ENLARGED TILE LAYOUT PLAN FOR FLOOR PATTERN, SHEET A-602	CPT - CARPET	QT - 2
N3 - SEE ELEVATIONS FOR TILE PATTERN, SHEET A-407	CT - CERAMIC TILE	QT - 3
N4 - PT-2 APPLIED TO TRUSSES & ALL RELATED HARDWARE, CONDUIT, FIXTURE BOXES, SPRINKLER PIPES, ETC. ATTACHED TO OR ADJACENT TO TRUSSES	QT - QUARRY TILE	QT - 4
N5 - WALLS TO RECEIVE PT-1 @ 10'-0" ABOVE THE MAPLE PLYWOOD VENEER	VCT - VINYL COMPOSITE TILE	QT - 5
N6 - FULL HEIGHT CERAMIC TILE UNLESS NOTED OTHERWISE	VWC - VINYL WALLCOVERING	QT - 6
N7 - PROVIDE QUARRY TILE, QT-6, IN ALL COOLERS & FREEZERS	PT - PAINT	
GENERAL	ACT - ACOUSTICAL CEILING TILE SYSTEM	
1. ALL FIRE ALARM STROBE FLASHERS & ANNUNCIATOR PANELS SHOULD BE PAINTED TO MATCH THE WALL.	ST - STAIN	
2. PACIFIC STRONG NON-YELLOWING WATER BASED FINISH ON ALL EXPOSED WOOD		
3. SEE DOOR SCHEDULE SHEET A/601 FOR DOOR & FRAME FINISHES		

FINISH SCHEDULE														
NO.	ROOM NAME	FLOOR	WALLS						CEILING		REMARKS			
			MATERIAL	FINISH	BASE	NORTH	EAST	SOUTH	WEST	MATERIAL		FINISH		
101	DINING ROOM		CONC.	CPT-1	WD ST-1	GB	VWC 2	GB	VWC 2	GB	VWC 2	T&G	ST 1	N4, N5
102	DINING ROOM		CONC.	CPT-1	WD ST-1	GB	VWC 2	GB	VWC 2	GB	VWC 2	T&G	ST 1	WOOD GRID CEILING, N4
103	DINING ROOM		CONC.	CPT-1	WD ST-1	GB	VWC 2	GB	VWC 2	GB	VWC 2	T&G	ST 1	N4, N5
104	LOBBY		CONC.	QT	QT-1	GB	VWC 1	GB	VWC 1	GB	VWC 1	WD	ST 1	WOOD GRID CEILING, N2
105	CORRIDOR		CONC.	QT	QT-1	GB	VWC 1	GB	VWC 1	GB	VWC 1	T&G	ST 1	N2, N4, N5
106	LOBBY		CONC.	QT	QT-1	GB	VWC 1	GB	VWC 1	GB	VWC 1	WD	ST 1	WOOD GRID CEILING, N2
106B	LOBBY		CONC.	QT-3	QT-1	GB	VWC 1	GB	VWC 1	GB	VWC 1	GB	PT-3	
107	WOMEN		CONC.	QT 3/4	QT-3	GB	CT 1	GB	CT 1	GB	CT 1	ACT 1	----	N3, N6
108	MEN		CONC.	QT 3/7	QT-3	GB	CT 1	GB	CT 1	GB	CT 1	ACT 1	----	N3, N6
109	ALCOVE		CONC.	QT 1	QT-1	GB	VWC 1	GB	VWC 1	GB	VWC 1	ACT 1	----	
110	OFFICE		CONC.	CPT 1	WD ST-1	GB	VWC 2	GB	VWC 2	GB	VWC 2	ACT 1	----	
111	SERVING LINE		CONC.	QT	QT-1	GB	CT	GB	CT	GB	CT	GB	PT-3	N2&3
112	GRILLE		CONC.	QT	QT 1	GB	CT	GB	CT	GB	CT	GB	PT-3	N2&3 QT-1
113	SERVING		CONC.	QT	QT 1	GB	CT	GB	CT	GB	CT	GB	PT-3	N2&3
114	SERVING LINE		CONC.	QT	QT 1	GB	CT	GB	CT	GB	CT	GB	PT-3	N2&3
115	JANITOR		CONC.	VCT 1	RUBBER 1	GB	PT- 3	GB	PT- 3	GB	PT- 3	ACT 1	----	
116	MECHANICAL EQUIP.		CONC.	SEAL	----	GB	PT- 3	GB	PT- 3	GB	PT- 3	ACT 1	----	
117	DISHWASHING		CONC.	QT 6	QT 6	GB	CT 2	GB	CT 2	GB	CT 2	ACT 2	----	N6
118	POT WASH		CONC.	QT 6	QT 6	GB	CT 2	GB	CT 2	GB	CT 2	ACT 2	----	N6
119	KITCHEN SERVING		CONC.	QT 6	QT 6	GB	CT 2	GB	CT 2	GB	CT 2	ACT 2	----	N6
120	KITCHEN		CONC.	QT 6	QT 6	GB	CT 2	GB	CT 2	GB	CT 2	ACT 2	----	N6
121	COMMUNICATIONS		CONC.	VCT 1	RUBBER 1	GB	PT- 3	GB	PT- 3	GB	PT- 3	ACT 1	----	
122	OFFICE		CONC.	VCT 1	RUBBER 1	GB	PT- 3	GB	PT- 3	GB	PT- 3	ACT 1	----	
123	MEN		CONC.	QT 3/7	QT 3	GB	CT 1	GB	CT 1	GB	CT 1	ACT 2	----	N2, N3, N6
124	WOMEN		CONC.	QT 3/4	QT 3	GB	CT 1	GB	CT 1	GB	CT 1	ACT 2	----	N2, N3, N6
125	LOADING DOCK		CONC.	----	----	----	----	----	----	----	----	MTL 1	----	
126	CORRIDOR		CONC.	QT 6	QT 6	GB	CT 2	GB	CT 2	GB	CT 2	ACT 1	----	N6
127	STORAGE		CONC.	VCT 1	RUBBER 1	GB	PT- 3	GB	PT- 3	GB	PT- 3	ACT 1	----	
128	OFFICE		CONC.	VCT 1	RUBBER 1	GB	PNT 3	GB	PNT 3	GB	PNT 3	ACT 1	----	
129	OFFICE		CONC.	VCT 1	RUBBER 1	GB	PNT 3	GB	PNT 3	GB	PNT 3	ACT 1	----	
130	DRY STORAGE		CONC.	QT 6	QT 6	GB	PT- 3	GB	PT- 3	GB	PT- 3	ACT 1	----	N7
131	VEGETABLE PREP		CONC.	QT 5	QT 5	GB	CT 2	GB	CT 2	GB	CT 2	ACT 1	----	N6
132	CAN WASH		CONC.	CONC.	BRICK	----	----	----	BRICK	----	BRICK	----	MTL	----
133	ELECT. ROOM		CONC.	CONC.	RUBBER 1	GB	PNT 3	GB	PT- 3	GB	PT- 3	ACT 1	----	
134	VEST.		CONC.	QT/CPT	----	----	----	----	----	----	----	----	----	
135	VEST.		CONC.	QT/CPT	----	----	----	----	----	----	----	----	----	
136	ALCOVE		CONC.	QT-3	QT-3	GB	VWC-1	GB	VWC-1	GB	VWC-1	GB	PT-3	
137	SUPPORT		CONC.	QT-5	QT-6	GB	CT-2	GB	CT-2	GB	CT-2	ACT-2	----	

\* NOTE: CORRIDOR AND DINING WVC TO MAPLE TRIM @ 10'-0" A.F.F. PAINT -4 ABOVE

Glick/Boehm & Associates, Inc.  
247 Meeting Street  
Charleston, S.C. 29401  
Tel: (803) 577-6377  
Fax: (803) 577-6378

DRWING CORRECTED TO AS-BUILT  
Prep By: *AKW* Date: *5/1/04*  
Rev: *1*

DRAWING REVISIONS

DRAWING BRANCH: *BOEHM*  
SUBMITTED BY (FROM MEMBER-TITLE): *BOEHM*  
DATE: *5/1/04*  
EFD FOR COMMANDER, NAVFAC

CHARLESTON AIR FORCE BASE  
CHARLESTON, SOUTH CAROLINA

DINING FACILITY  
FINISH SCHEDULE

APPROVED: *RD* DATE: *5/1/04*

Naval Facilities Engineering Command  
Southern Division  
Charleston, South Carolina

STATE OF SOUTH CAROLINA  
GLICK/BOEHM & ASSOCIATES, INC.  
REGISTERED ARCHITECT  
NO. B-80006

RECORD DRAWING DATE: *9/27/04*  
CODE I.D. NO.: 80091  
DRAWING SIZE: *D*  
SPEC. NO. 06-98-0939  
CONSTR. CONTR. NO. *N62467-9B-C-0939*  
NAVFAC DRAWING NO. *5357913*  
SHEET *88* OF *194*

A-602