




HEAD

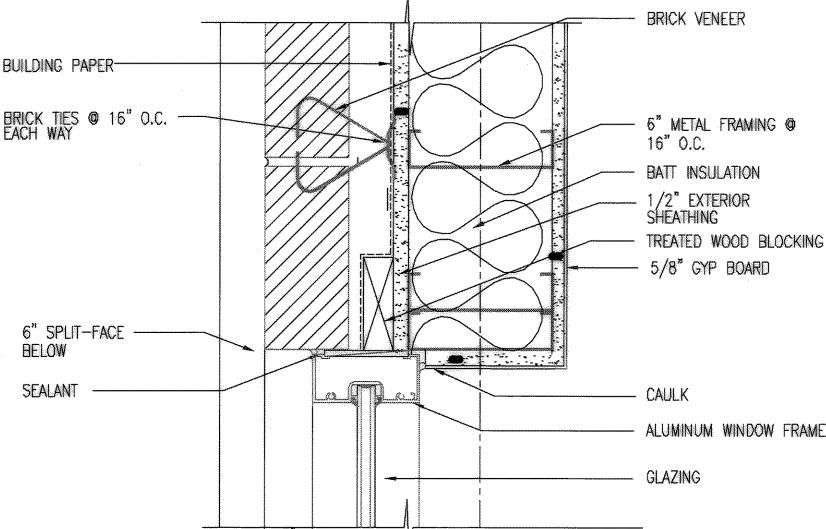


JAMB

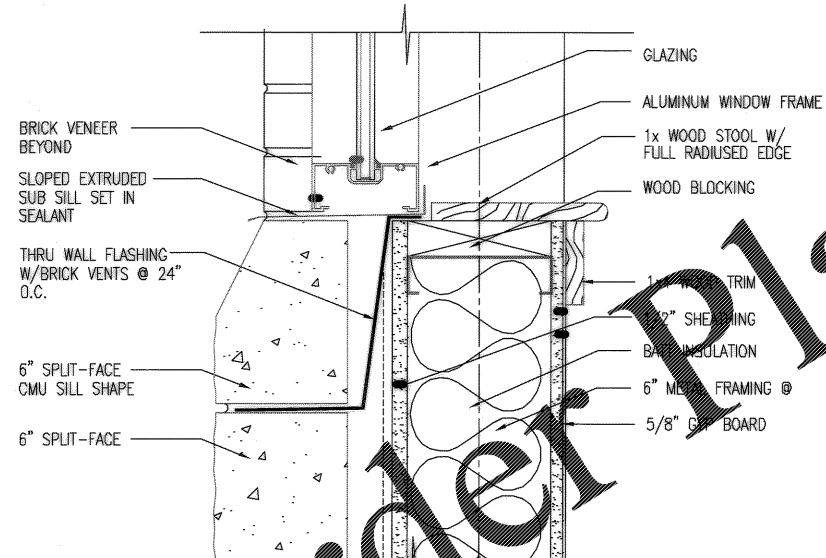


SILL

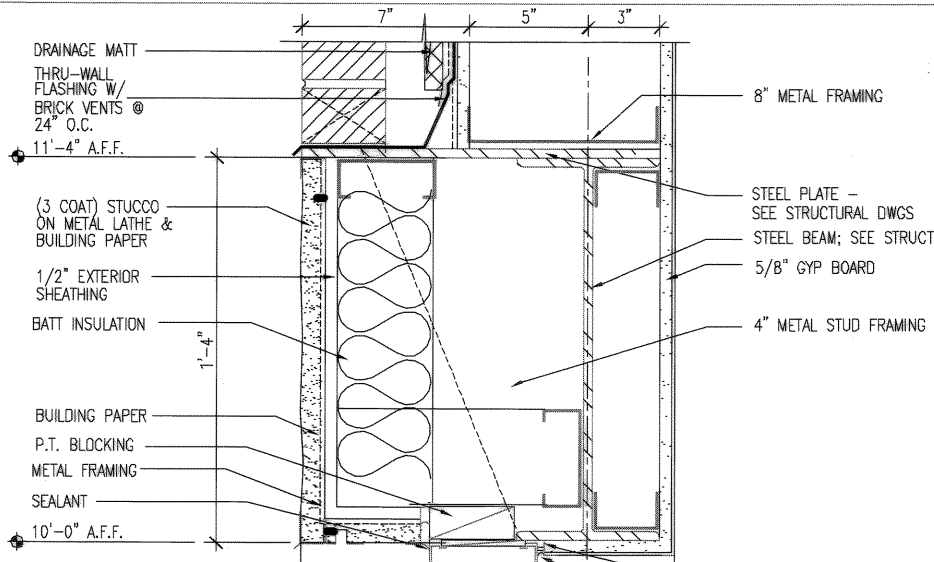


HEAD

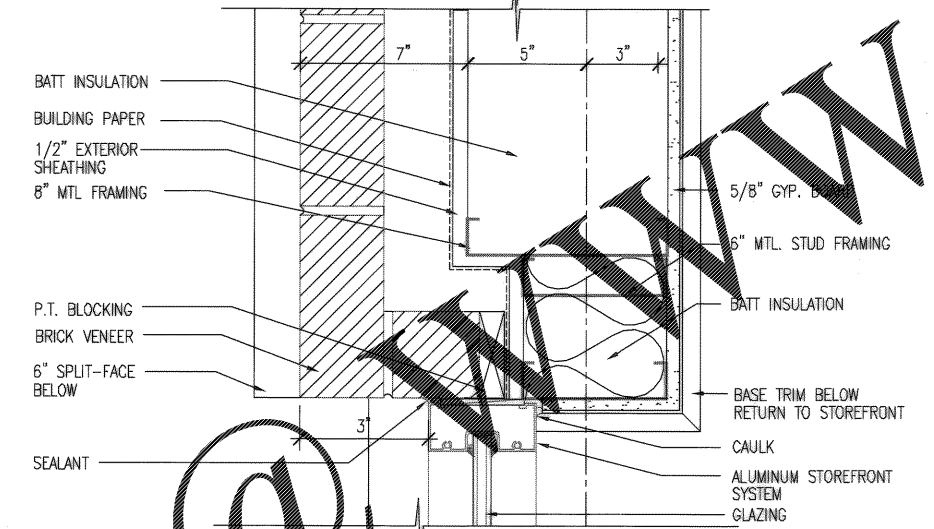


JAMB

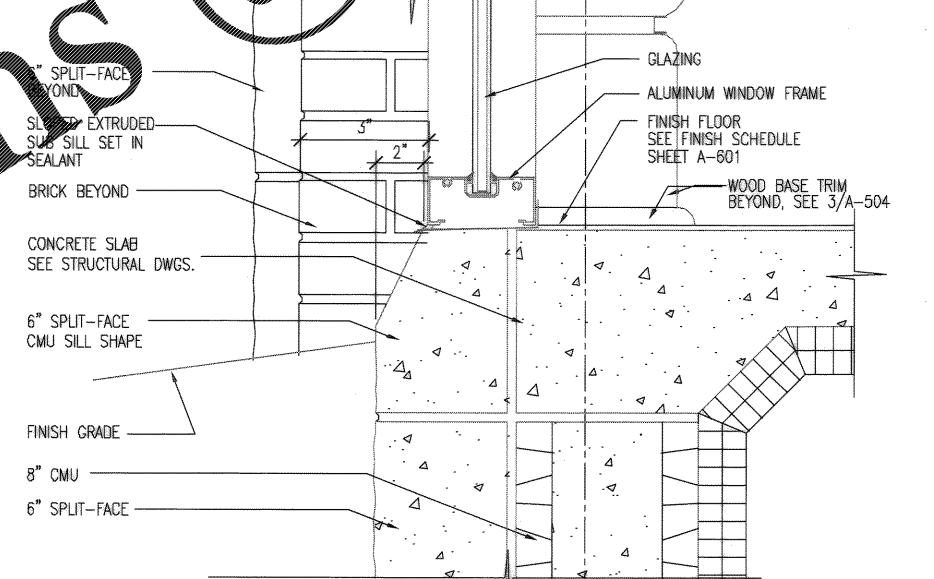


WINDOW DETAIL

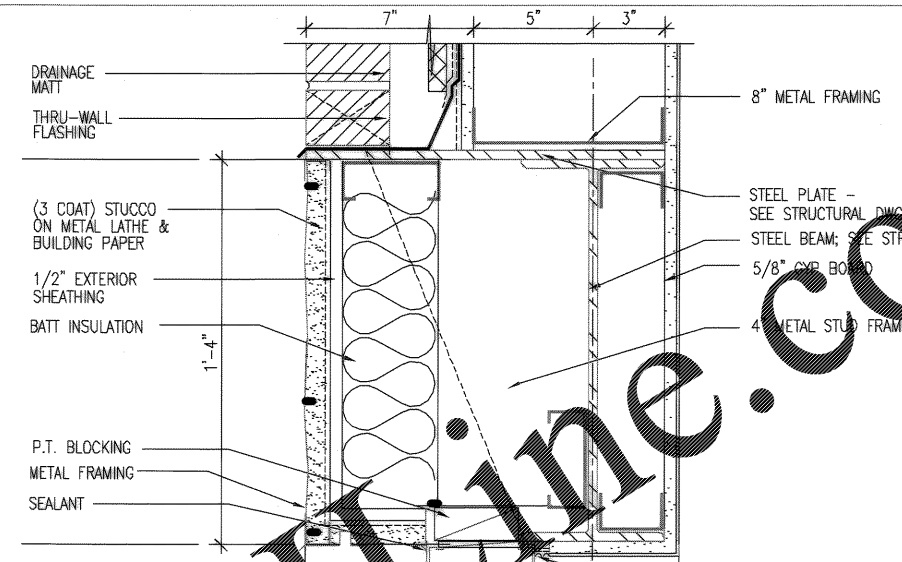

HEAD

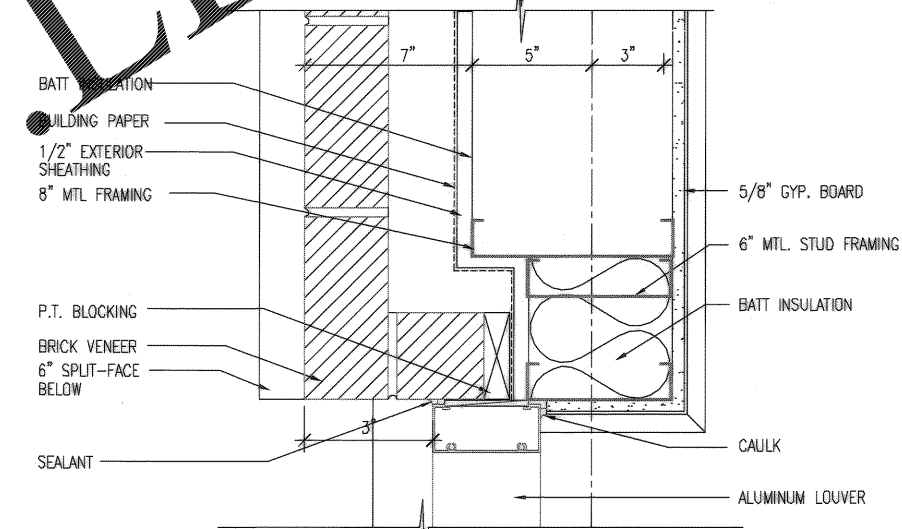

JAMB

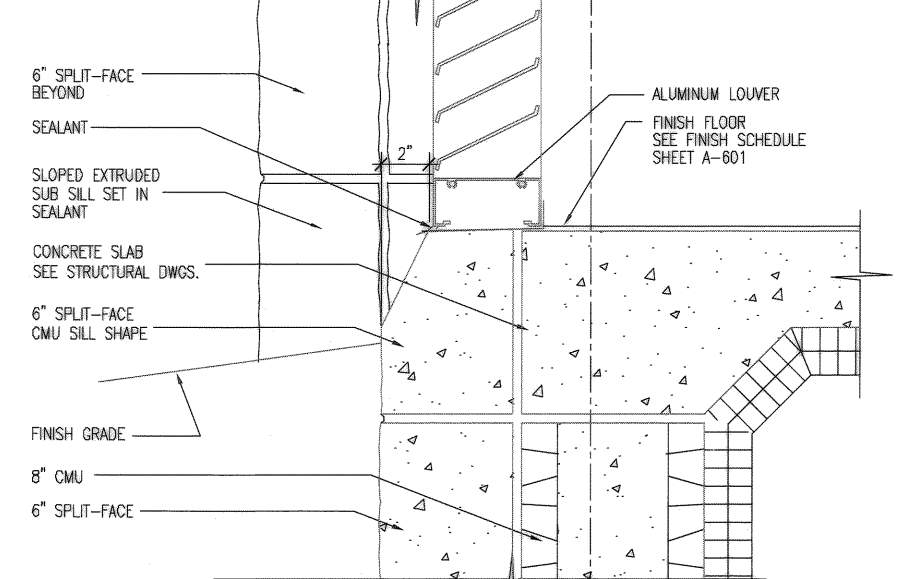

WINDOW DETAIL

Order Plans @ WWW.LDOnline.com

1 WINDOW DETAIL
A-605 SCALE: 3" = 1'-0"

2 WINDOW DETAIL
A-605 SCALE: 3" = 1'-0"

3 WINDOW DETAIL
A-605 SCALE: 3" = 1'-0"

DRAWING REVISIONS
 Description: CORRECTED TO AS-BUILT
 Date: 5/14/04
 Prepped By: JGT
 Checked By: BOEHM
 Approved By: BOEHM
 Date: 5/14/04

CHARLESTON AIR FORCE BASE
 CHARLESTON, SOUTH CAROLINA
 DINING FACILITY
 WINDOW DETAILS

APPROVED: [Signature]
 DATE: 5/14/04
 ETD FOR COMMANDER, NAVFAC

Naval Facilities Engineering Command
 Southern Division
 Charleston, South Carolina

STATE OF SOUTH CAROLINA
 Glick/Boehm & Associates, Inc.
 REGISTERED ARCHITECT
 NO. B-80005

RECORD DRAWING DATE: 9/27/04
 CODE T.D. NO.: 80091
 DRAWING SIZE: D
 SPEC. NO.: 06-98-0939
 CONSTR. CONTR. NO.: N62467-9B-C-0939
 NAVFAC DRAWING NO.: 5357916
 SHEET 91 OF 194

A-605