



1 DINING ROOM CEILING GRID PLAN  
SCALE: 3" = 1'-0"

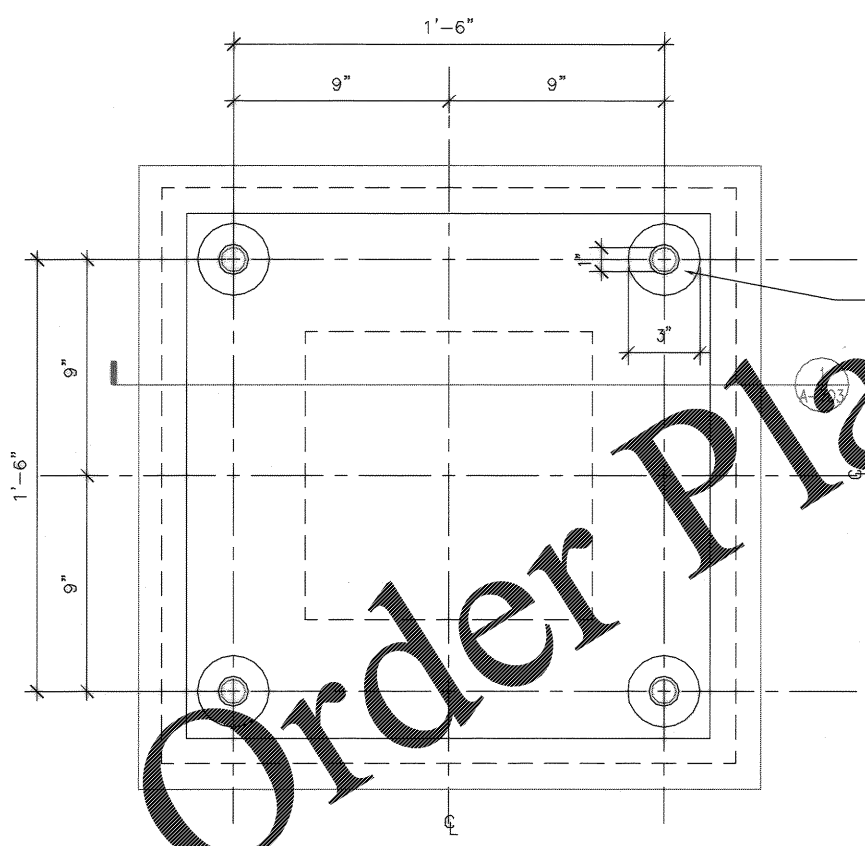


4 DINING ROOM CEILING GRID PLAN  
SCALE: 3" = 1'-0"

2 DINING ROOM CEILING GRID PLAN  
SCALE: 3" = 1'-0"

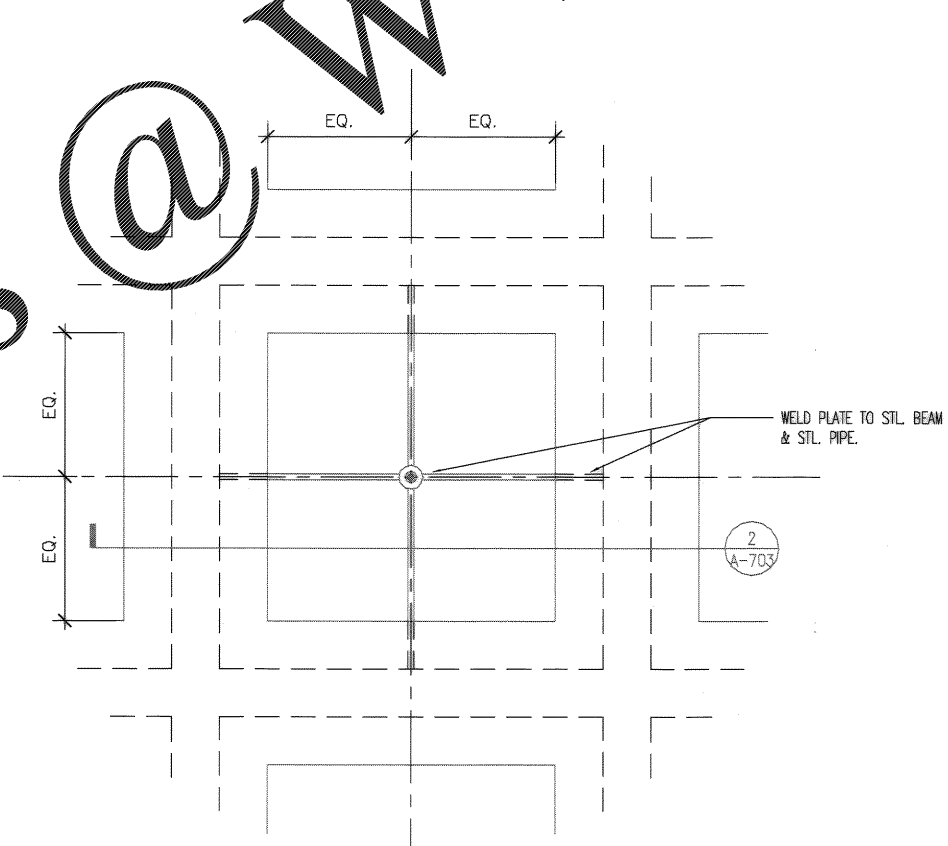

5 DINING ROOM CEILING GRID PLAN  
SCALE: 3" = 1'-0"

3 DINING ROOM CEILING GRID PLAN  
SCALE: 3" = 1'-0"

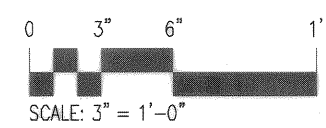

CHARLESTON AIR FORCE BASE CHARLESTON, SOUTH CAROLINA  
 DINING FACILITY  
 INTERIOR DETAILS  
 APPROVED: *BD/MS/RE* DATE: 5/1/04  
 ETD FOR COMMANDER, NAVFAC

Naal Facilities Engineering Command  
 Southern Division  
 Charleston, South Carolina

STATE OF SOUTH CAROLINA  
 CLICK/BOEHM & ASSOCIATES, INC.  
 CHARLESTON NO. B-8006  
 REGISTERED ARCHITECT

RECORD DRAWING DATE: 01/21/04  
 CODE I.D. NO.: 80091  
 DRAWING SIZE: D  
 SPEC. NO. 08-98-0939  
 CONSTR. CONTR. NO.: N62467-98-C-0939  
 NAVFAC DRAWING NO.: 5357821  
 SHEET 96 OF 194  
 A-703

DRAWING REVISIONS  
 Description: AS-BUILT DRWG. NO CORRECTIONS  
 Prep By: *AKW* Date: 5/1/04  
 Approved: *AKW* Date: 5/1/04  
 Design: *BOEHM* Drawn: *JCS* Check: *BOEHM*  
 Submitted by (Firm Member Title): TECHNICAL BRANCH  
 Submitted by (Firm Member Title): ME. PRES. B-33-88  
 Date: DATE