


ENLARGED MECHANICAL ROOM PLAN (BASE BID)  
SCALE: 1/4" = 1'-0"

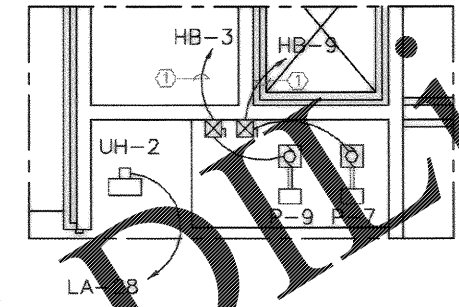

ENLARGED PARTIAL MECHANICAL ROOM PLAN (CHILLER PLANT REPLACEMENT OPTION)  
SCALE: 1/4" = 1'-0"

SEE ENLARGED PARTIAL MECHANICAL ROOM PLAN FOR ALTERNATE LAYOUT UNDER CHILLER PLANT REPLACEMENT OPTION

KEYED NOTES (THIS SHEET ONLY)

- ① 3#12, 1#126, 1/2" C

Order Plans @

WWW.LDLINE.COM

Click/Boehm & Associates, Inc.  
257 Meeting Street  
Charleston, S.C. 29403  
7-8377

DRAWING REVISIONS


Rev.	Description	Prep. By	Date	Appr. By
1	DRWG. CORRECTED TO AS-BUILT	ALLEN	11/24/04	ALLEN

CHARLESTON AIR FORCE BASE  
CHARLESTON, SOUTH CAROLINA  
DINING FACILITY  
ENLARGED MECHANICAL ROOM PLAN  
APPROVED: [Signature] P.E. DATE: 11/24/04 EDD FOR COMMANDER, NAVFAC

Naval Facilities Engineering Command  
Southern Division  
Charleston, South Carolina



GRAPHIC SCALE

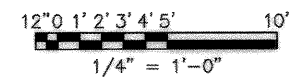

RECORD DRAWING DATE	9/27/04
CODE ID NO.	80911
DRAWING SIZE	0
SPEC. NO.	06-88-0938
CONSTN. CONTR. NO.	862467-98-C-0939
NAVFAC DRAWING NO.	5358/003
SHEET 178 OF 194	

E-401