


Order Plans

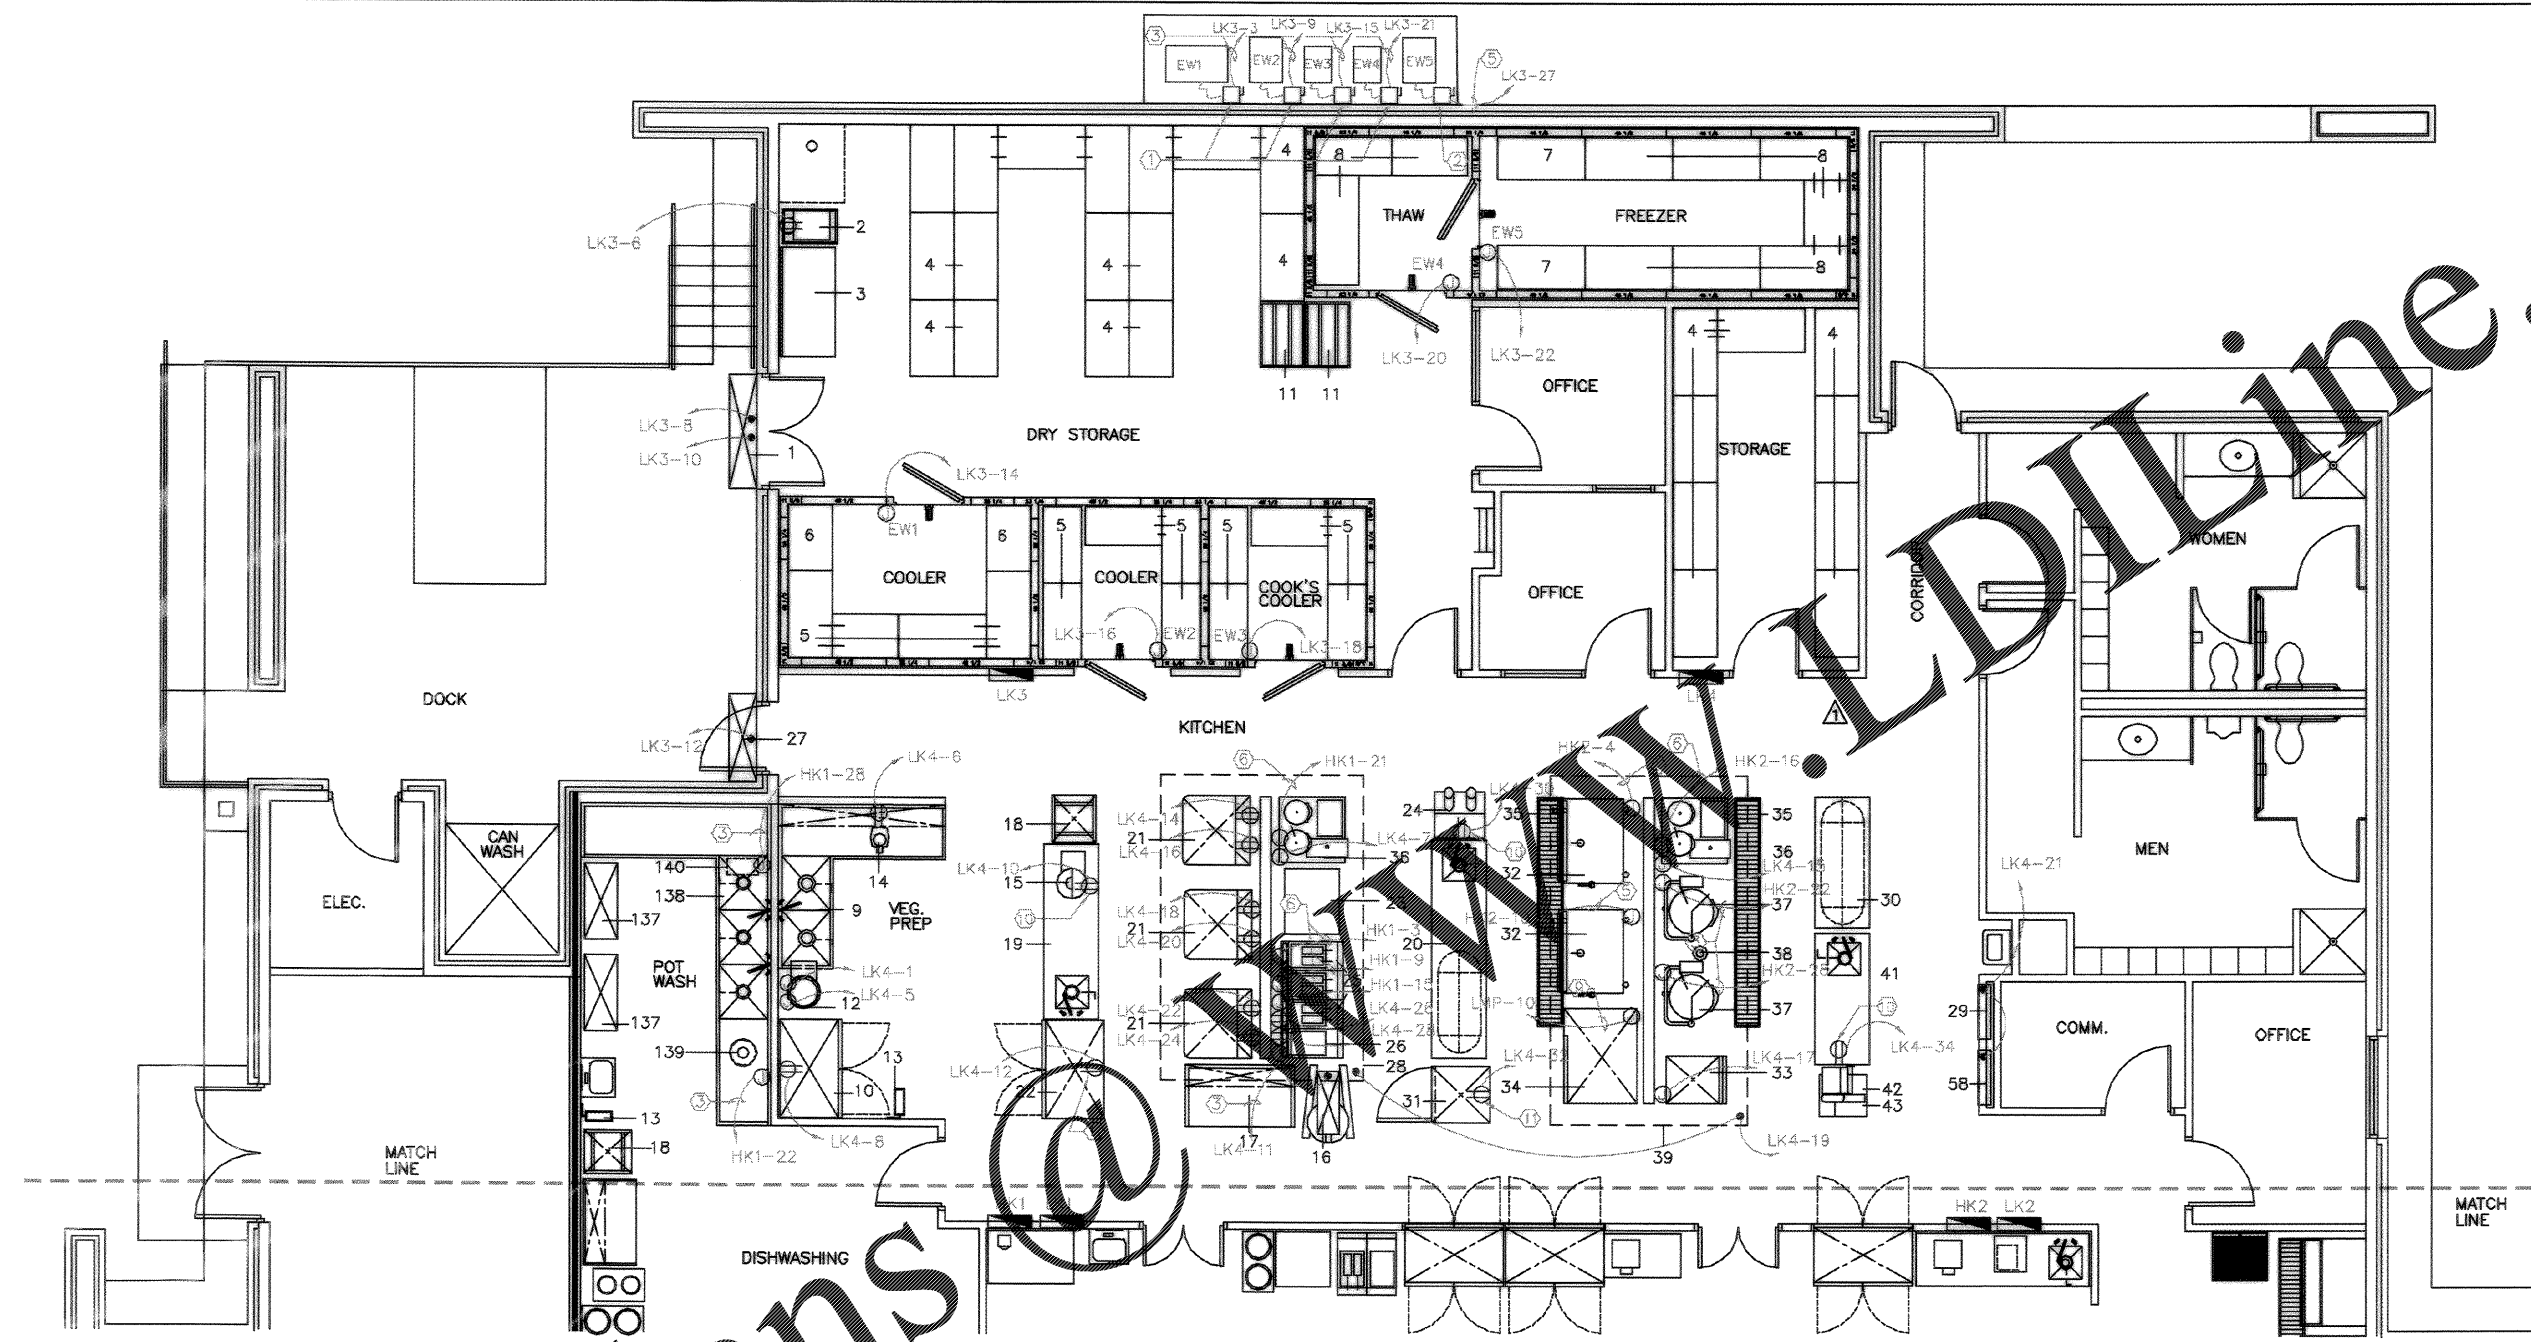

KITCHEN AND SERVERY ELECTRICAL PLAN

1/4"=1'-0"

KEY NOTE (APPLIES TO E402 AND E403 ONLY)

- ① DISCONNECT SWITCH, 30/3/3R/20AF
- ② DISCONNECT SWITCH, 60/3/3R/40AF
- ③ 2-#10, 1-#10GND, 1/2" C
- ④ 2-#10, 1-#10GND, 3/4" C
- ⑤ 3-#10, 1-#10GND, 3/4" C
- ⑥ 3-#8, 1-#10GND, 3/4" C
- ⑦ 3-#8, 1-#8GND, 1" C
- ⑧ 3-#2, 1-#8GND, 1 1/4" C
- ⑨ 3-#4/0, 1-#4GND, 2 1/2" C
- ⑩ MOUNT RECEPTACLE 8" A.F.F. ON 2 RIGID STEEL CONDUITS
- ⑪ RECEPTACLE ON S.D. CORD FROM CEILING @ 80" A.F.F.
- ⑫ RECEPTACLE, 30A, 208V, 1φ
- ⑬ RECEPTACLE, 30A, 480V, 3φ
- ⑭ RECEPTACLE, 40A, 480V, 3φ
- ⑮ MOUNT RECEPTACLE 10" A.F.F. ON 2 RIGID STEEL CONDUITS



RECORD DRAWING DATE	9/27/24
CODE I.D. NO.	80851
DRAWING SIZE	D
SPEC. NO.	06-88-0938
CONSTR. CONTR. NO.	N62467-98-C-0939
NAVFAC DRAWING NO.	3358004
SHEET	179 OF 184

E-402

Naval Facilities Engineering Command  
Southern Division  
Charleston, South Carolina

CHARLESTON AIR FORCE BASE CHARLESTON, SOUTH CAROLINA

DINING FACILITY

KITCHEN AND SERVERY ELECTRICAL PLAN

APPROVED: *R.D. Moore, P.E.* DATE: *8/27/24* EIC FOR COMMANDER, NAVFAC

Rev.	Description	Date	By	App'd	Checked
1	AS-BUILT DRAWING NO CORRECTIONS	8/27/24	ALLEN	ALLEN	ALLEN

DRAWING REVISIONS

Prep By: ALLEN  
Date: 8/27/24  
Checked: ALLEN  
App'd: ALLEN

Submitted by (with membership no.): ALLEN  
Submitted by (with membership no.): ALLEN  
Submitted by (with membership no.): ALLEN  
Submitted by (with membership no.): ALLEN

06/17/2018 17:51:30  
06/17/2018 17:51:30  
