



FIXTURE "A"
SCALE: NONE

1. RECESSED FLUORESCENT TROFFER.
2. 2'x4', 3 1/2" (MIN.) TO 4 1/2" (MAX.) HEIGHT.
3. STEEL HOUSING AND FRAME, WHITE ENAMEL FINISH, .125" THICK ACRYLIC PRISMATIC LENS.
4. ELECTRONIC BALLAST(S) WITH TOTAL HARMONIC DISTORTION < 20%, POWER FACTOR > .95, U.L. LISTED CLASS P, SOUND RATED A, MAXIMUM ANSI INPUT WATTS FOR 3 LAMPS OF 95 WATTS.
5. 3-F32T8, 3500K LAMPS.
6. 277V.
7. PROVIDE MOUNTING ACCESSORIES AS REQUIRED TO MOUNT FIXTURE IN LAY-IN OR HARD CEILING AS SHOWN ON ARCHITECTURAL CEILING PLAN.

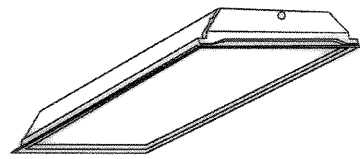


FIXTURE "B"
SCALE: NONE

1. RECESSED FLUORESCENT TROFFER.
2. 2'x4', 3 1/2" (MIN.) TO 4 1/2" (MAX.) HEIGHT.
3. STEEL HOUSING AND FRAME, WHITE ENAMEL FINISH, .125" THICK ACRYLIC PRISMATIC LENS.
4. ELECTRONIC BALLAST(S) WITH TOTAL HARMONIC DISTORTION < 20%, POWER FACTOR > .95, U.L. LISTED CLASS P, SOUND RATED A, MAXIMUM ANSI INPUT WATTS FOR 2 LAMPS OF 60 WATTS.
5. 2-F32T8, 3500K LAMPS.
6. 277V.
7. PROVIDE MOUNTING ACCESSORIES AS REQUIRED TO MOUNT FIXTURE IN LAY-IN OR HARD CEILING AS SHOWN ON ARCHITECTURAL CEILING PLAN.

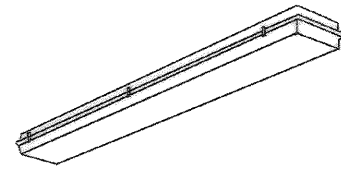


FIXTURE "C"
SCALE: NONE

1. ENCLOSED FLUORESCENT INDUSTRIAL.
2. 4' LENGTH, 8" MAXIMUM WIDTH, 5" MAXIMUM DEPTH.
3. IMPACT AND UV RESISTANT POLYESTER HOUSING, HIGH IMPACT ACRYLIC DIFFUSER.
4. U.L. LISTED FOR DAMP LOCATIONS.
5. BALLAST FOR COLD WEATHER (0° F) STARTING, POWER FACTOR > .9, U.L. LISTED CLASS P, SOUND RATED A.
6. 2-F32T8, 3500K LAMPS.
7. 277V.

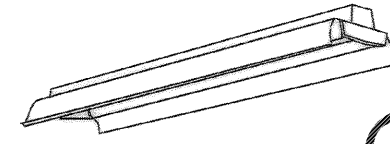


FIXTURE "D"
SCALE: NONE

1. FLUORESCENT INDUSTRIAL.
2. 4' LENGTH, 12" WIDTH, 4" DEPTH.
3. LENS HOUSING AND REFLECTOR, APERTURED REFLECTOR FOR 5-10% UPLIGHT, WHITE ENAMEL FINISH.
4. ELECTRONIC BALLAST(S) WITH TOTAL HARMONIC DISTORTION < 20%, POWER FACTOR > .95, U.L. LISTED CLASS P, SOUND RATED A, MAXIMUM ANSI INPUT WATTS FOR 2 LAMPS OF 60 WATTS.
5. 2-F32T8, 3500 K LAMPS.
6. 277V.

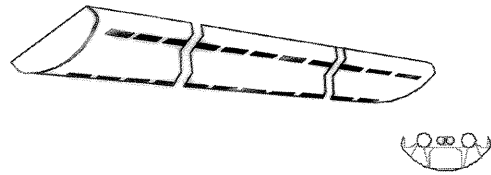


FIXTURE "E"
SCALE: NONE

1. LINEAR INDIRECT FLUORESCENT WITH DOWNLIGHT VENTS.
2. 4' LENGTH, 8" X 3" ROUNDED CROSS SECTION. FIXTURES MAY BE CONSTRUCTED IN UNINTERRUPTED SECTIONS UP TO 24' LONG.
3. EXTRUDED ALUMINUM HOUSING, WHITE PAINTED FINISH.
4. CLEAR ACRYLIC LENS OVER DOWNLIGHT VENTS.
5. HANG WITH BOTTOM OF FIXTURE 9' A.F.F. USING A HANG CABLE.
6. PROVIDE FACTORY CONNECTORS/JOINERS TO MATCH FINISH OF FIXTURE AND CREATE GEOMETRIC PATTERN SHOWN ON THE PLANS.
7. ELECTRONIC BALLAST(S) WITH TOTAL HARMONIC DISTORTION < 20%, POWER FACTOR > .95, U.L. LISTED CLASS P, SOUND RATED A.
8. 2-F32T8, 3500K LAMPS, AND 2-F40BX, 3500K LAMPS PER 4' SECTION.
9. 277V.
10. BASIS OF FIXTURES PEEL-LESS ENT SERIES.

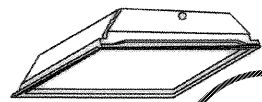



FIXTURE "F"
SCALE: NONE

1. RECESSED FLUORESCENT TROFFER.
2. 2'x2', 3 1/2" (MIN.) TO 4 1/2" (MAX.) HEIGHT.
3. STEEL HOUSING AND FRAME, WHITE ENAMEL FINISH, .125" THICK ACRYLIC PRISMATIC LENS.
4. ELECTRONIC BALLAST(S) WITH TOTAL HARMONIC DISTORTION < 20%, POWER FACTOR > .95, U.L. LISTED CLASS P, SOUND RATED A, MAXIMUM ANSI INPUT WATTS FOR 3 LAMPS OF 49 WATTS.
5. 3-F17T8, 3500K LAMPS.
6. 277V.
7. PROVIDE MOUNTING ACCESSORIES AS REQUIRED TO MOUNT FIXTURE IN LAY-IN OR HARD CEILING AS SHOWN ON ARCHITECTURAL CEILING PLAN.

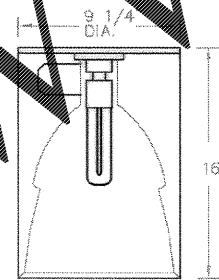

FIXTURE "G"
SCALE: NONE

1. SURFACE MOUNTED FLUORESCENT DOWNLIGHT.
2. SEAMLESS ALUMINUM CAN, DARK BRONZE FINISH.
3. SPECULAR CLEAR ALZAK OPEN REFLECTOR.
4. U.L. LISTED FOR DAMP LOCATIONS.
5. HIGH POWER FACTOR BALLAST (>.9).
6. 1-26 WATT COMPACT FLUORESCENT TRI-TUBE LAMP.
7. 277V.
8. SEE ARCHITECTURAL PLANS FOR MOUNTING DETAIL.

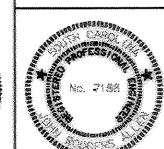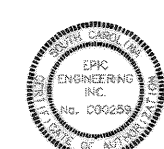

RECORD DRAWING DATE	9/27/09
CODE LD. NO.	80081
DRAWING SIZE:	D
SPEC. NO.	D6-88-0938
CONSTN. CONTR. NO.	IN6247-98-C-3939
NAVFAC DRAWING NO.	5356006
SHEET 193 OF 194	
E-503	

Client/Booth/Agency/Contractor/Division/Sheet No./Title	247 Meeting Street, Charleston, S.C. 29403 OSCH SUB QUATZ SUBMITTED BY (FIRM NUMBER-PROJECT NUMBER) TECHNICAL BRANCH PKR
Date	9/27/09
Prep By	PKR
Check By	PKR
Drawn By	PKR
Revised	
AS-BUILT DRAWG. NO. CONNECTIONS	
REVISIONS	

CHARLESTON AIR FORCE BASE CHARLESTON, SOUTH CAROLINA
DINING FACILITY
DETAILS
APPROVED: [Signature] [Title]
EPIC FOR COMMANDER, NAVFAC

Naval Facilities Engineering Command
Southern Division
Charleston, South Carolina

Order Plans @

WWW.LDLINE.COM