



Order Plans @

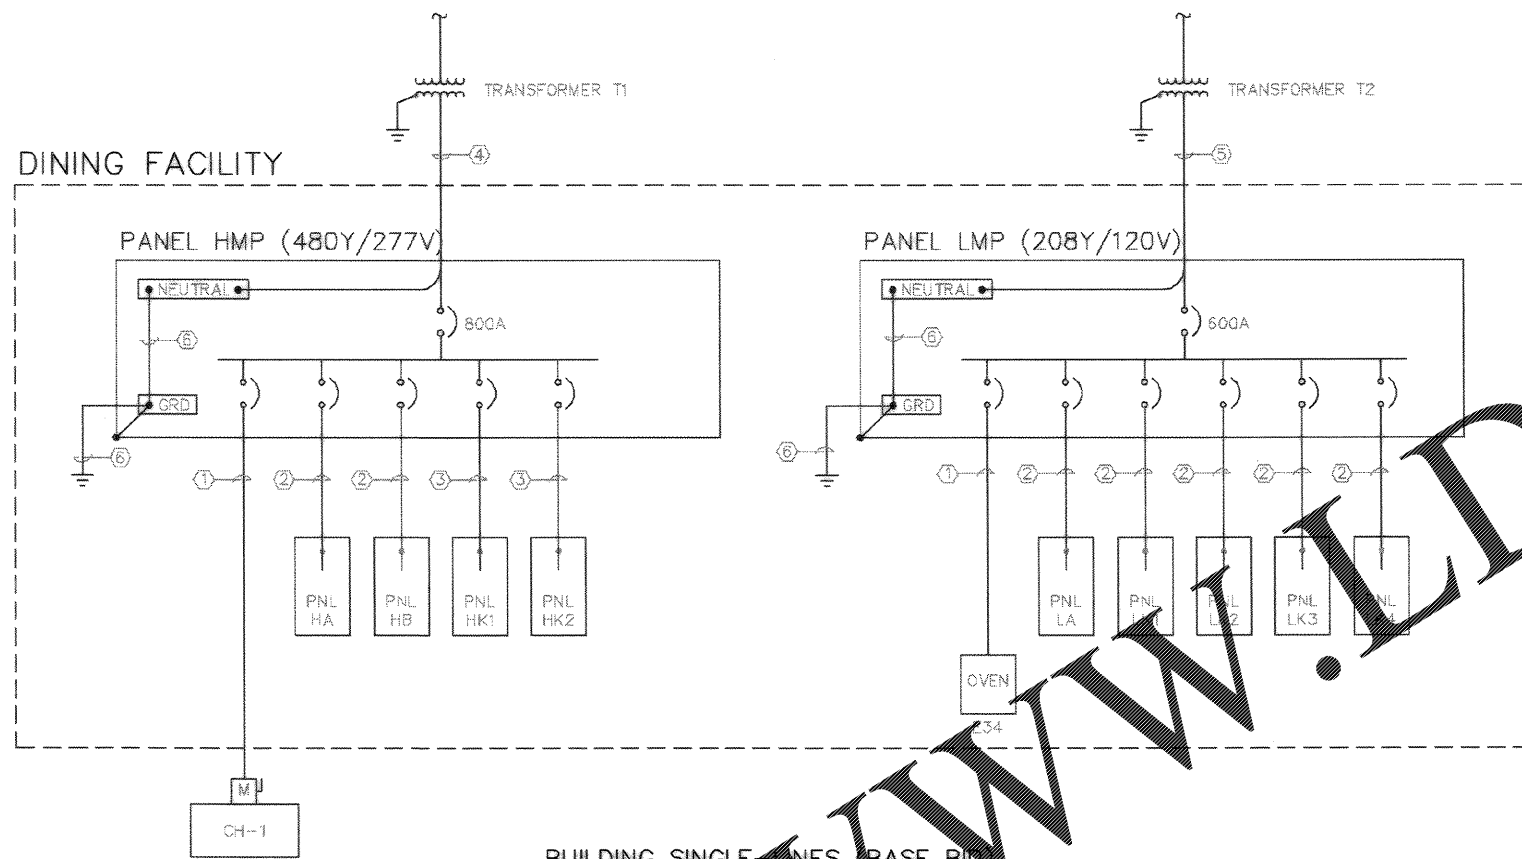

BUILDING SINGLE-LINES BASE BID

KEYED NOTES (THIS SHEET ONLY)

- ① 3#4/0, 1#4G, 2 1/2"Ø
- ② 4#4/0, 1#4G, 2 1/2"Ø
- ③ 3#500MCM, 1#2G, 3"Ø
- ④ 2 RUNS OF (3#500MCM, 1#250MCM N, 3 1/2"Ø) EACH
- ⑤ 2 RUNS OF (4#350MCM, 3 "Ø) EACH
- ⑥ #2/0 GROUND

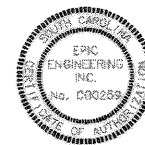

RECORD DRAWING DATE: 9/27/14
 CODE I.D. NO.: 80081
 DRAWING SIZE: D
 SPEC. NO.: 06-88-08.08
 CONSTR. CONTR. NO.: N02467-88-C-0839
 NAVFAC DRAWING NO.: 5358012
 SHEET 182 OF 194

E-602

Naval Facilities Engineering Command
 Southern Division
 Charleston, South Carolina

CHARLESTON AIR FORCE BASE CHARLESTON, SOUTH CAROLINA
DINING FACILITY
 BUILDING SINGLE-LINES (BASE BID)
 APPROVED: [Signature] REV. 5/14/14 ETD FOR COMMANDER, NAVFAC

DRAWING REVISIONS

Rev.	Description	Prep By	Date	Appr'd.
1	AS-BUILT DWG. NO CORRECTIONS	[Signature]	9/27/14	[Signature]

Click/Boehm & Associates, Inc.
 247 Meeting Street
 Charleston, SC 29401
 (803) 725-6377
 DRAWN BY: BOEHM, CLAYTON
 CHECKED BY: ALLEN, CHAD
 SUBMITTED BY: (FOR VERIFICATION)
 TECHNICAL MANAGER: ALLEN, ONE