


NOTE: RUN REFRIGERATION LINES
IN WALL AT THIS AREA.

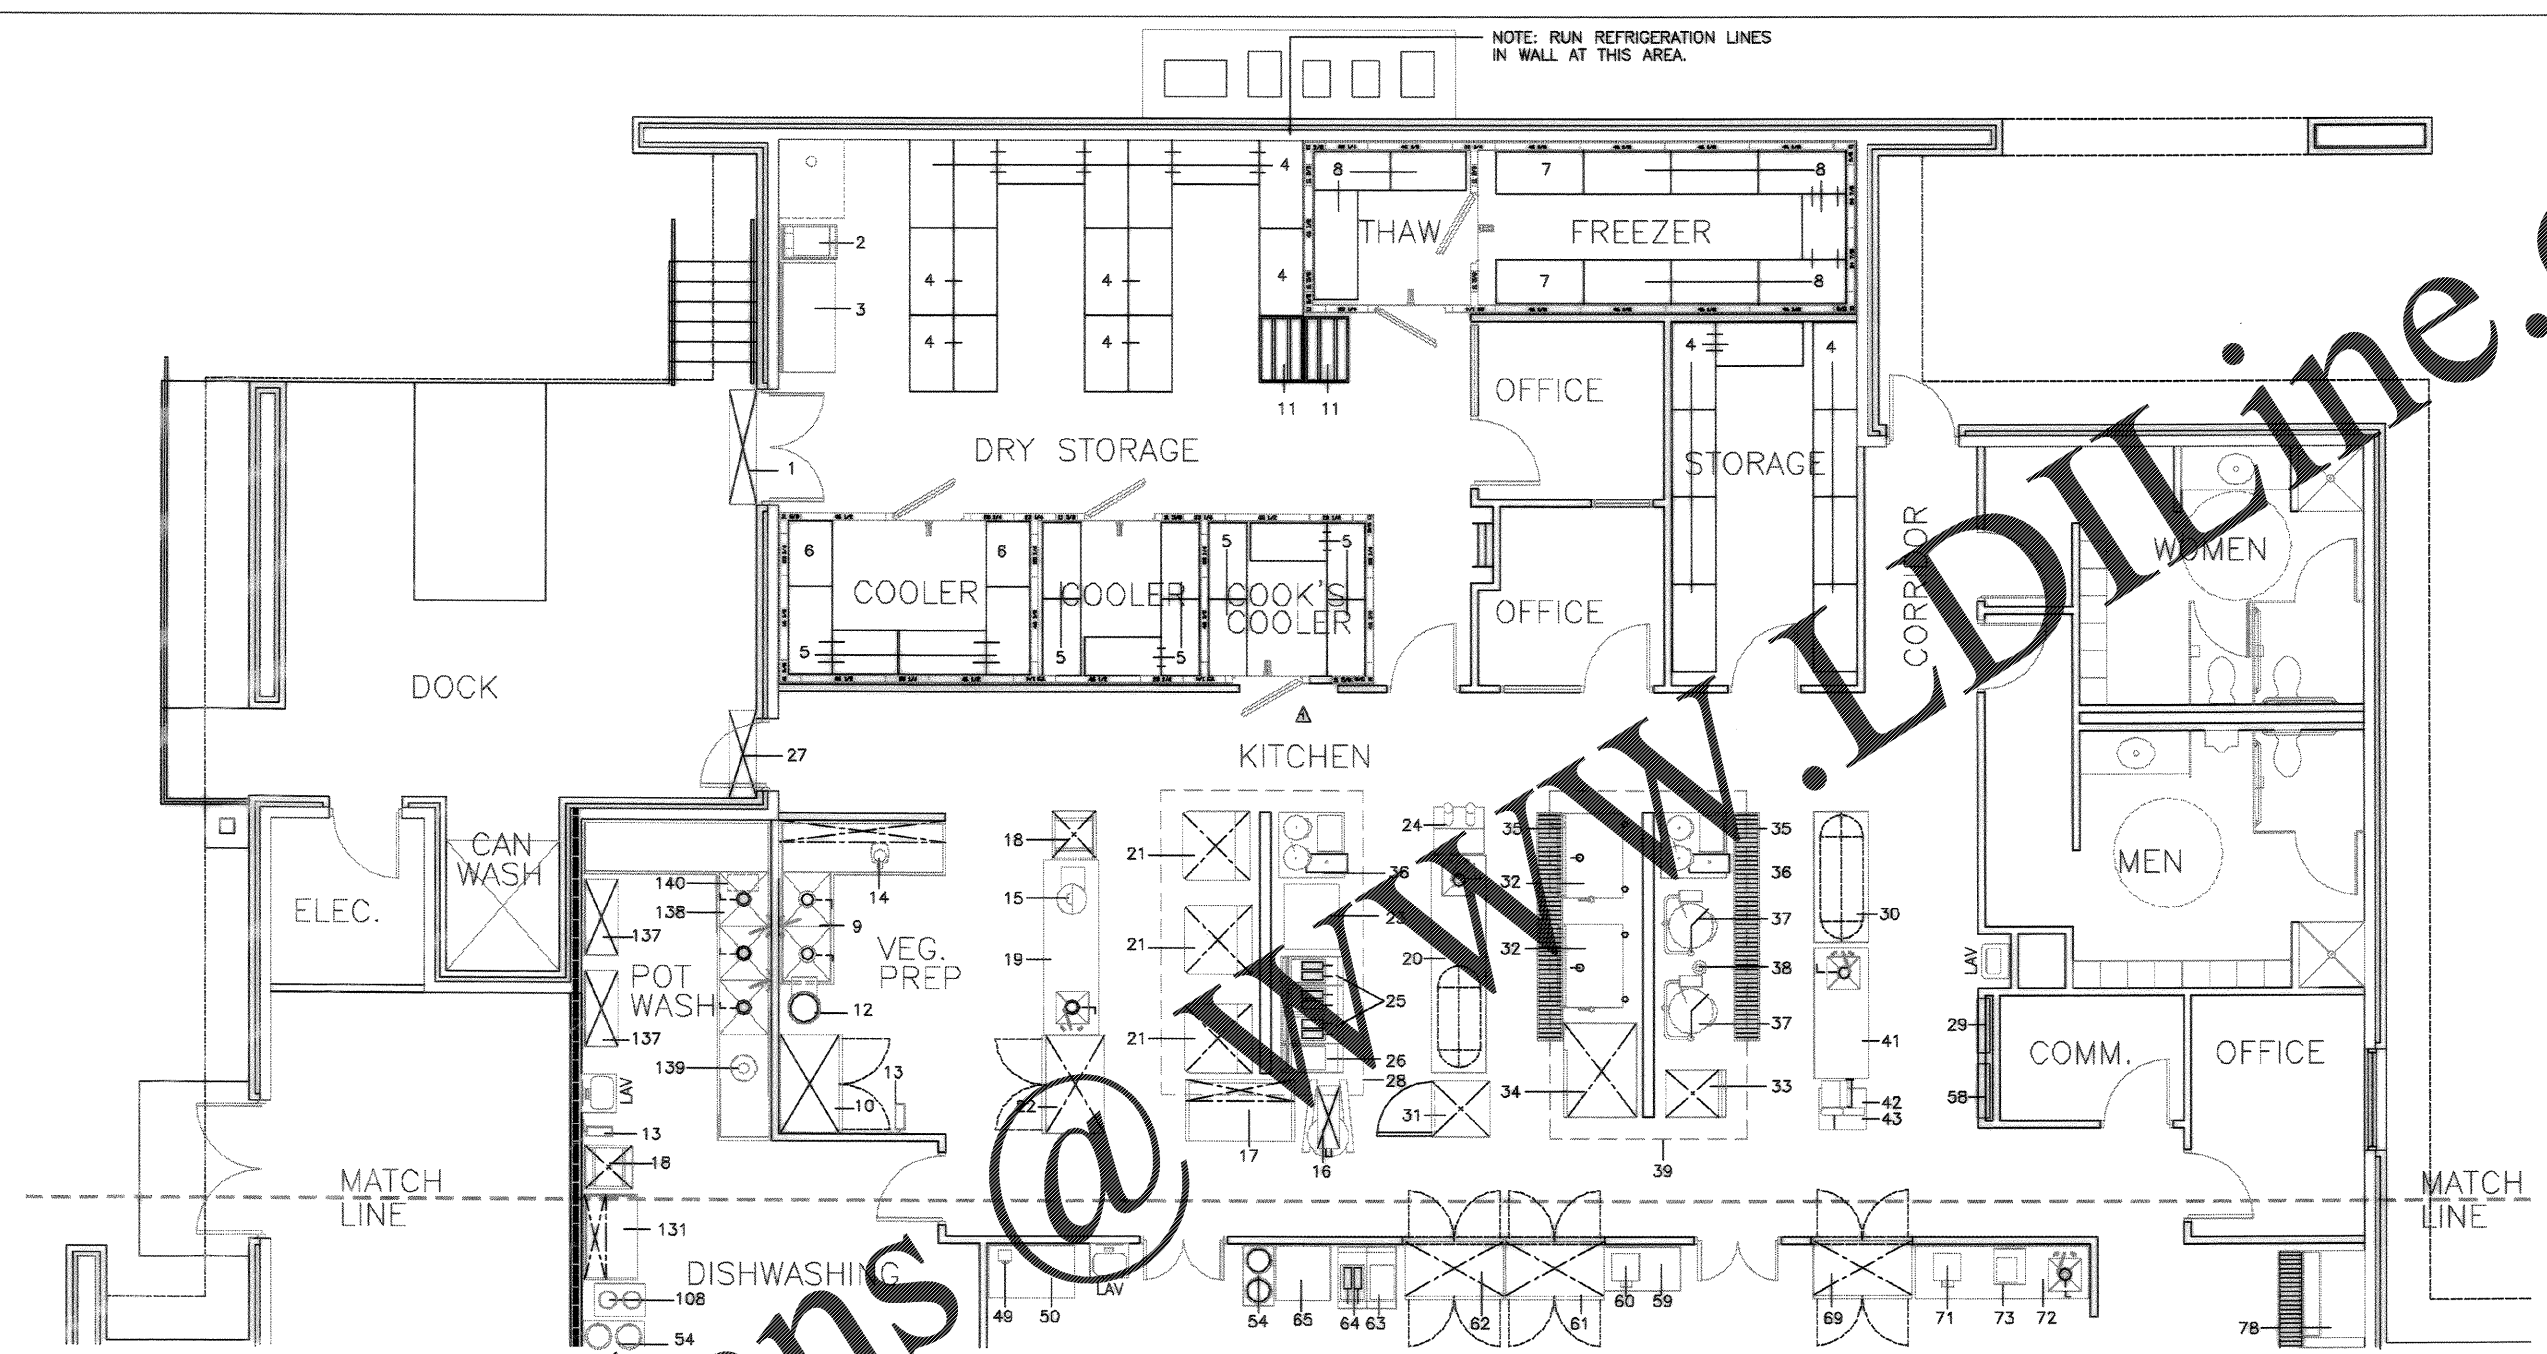

1 KITCHEN AND SERVERY FLOOR PLAN
K102 1/4"=1'-0"

Glick/Backin & Associates, Inc. 247 Meeting Street, Suite 200 Charleston, S.C. 29403 (803) 733-6377			
DRAWING REVISIONS Description 1 DRWG. CORRECTED TO AS-BUILT	Date Approved 11/27/14	Prepped By MZ/PAV/MS	Submitted by (per manufacturing) YESKON, BARNER
CHARLESTON AIR FORCE BASE CHARLESTON, SOUTH CAROLINA		APPROVED: <i>[Signature]</i> DATE: 1/14/14 ESP FOR COMMANDER, NAVFAC	
Naval Facilities Engineering Command Southern Division Charleston, South Carolina		DINING FACILITY KITCHEN AND SERVERY FLOOR PLAN	
RECORD DRAWING DATE 9/27/14	CODE I.D. NO. 80091	DRAWING SIZE 11	SPEC. NO. 06-98-09.59 CONSTR. CONTR. NO. 162467-98-C-0939 NAVFAC DRAWING NO. 5357925
SHEET 100 OF 194		K102	

Order Plans