


Order Plans @

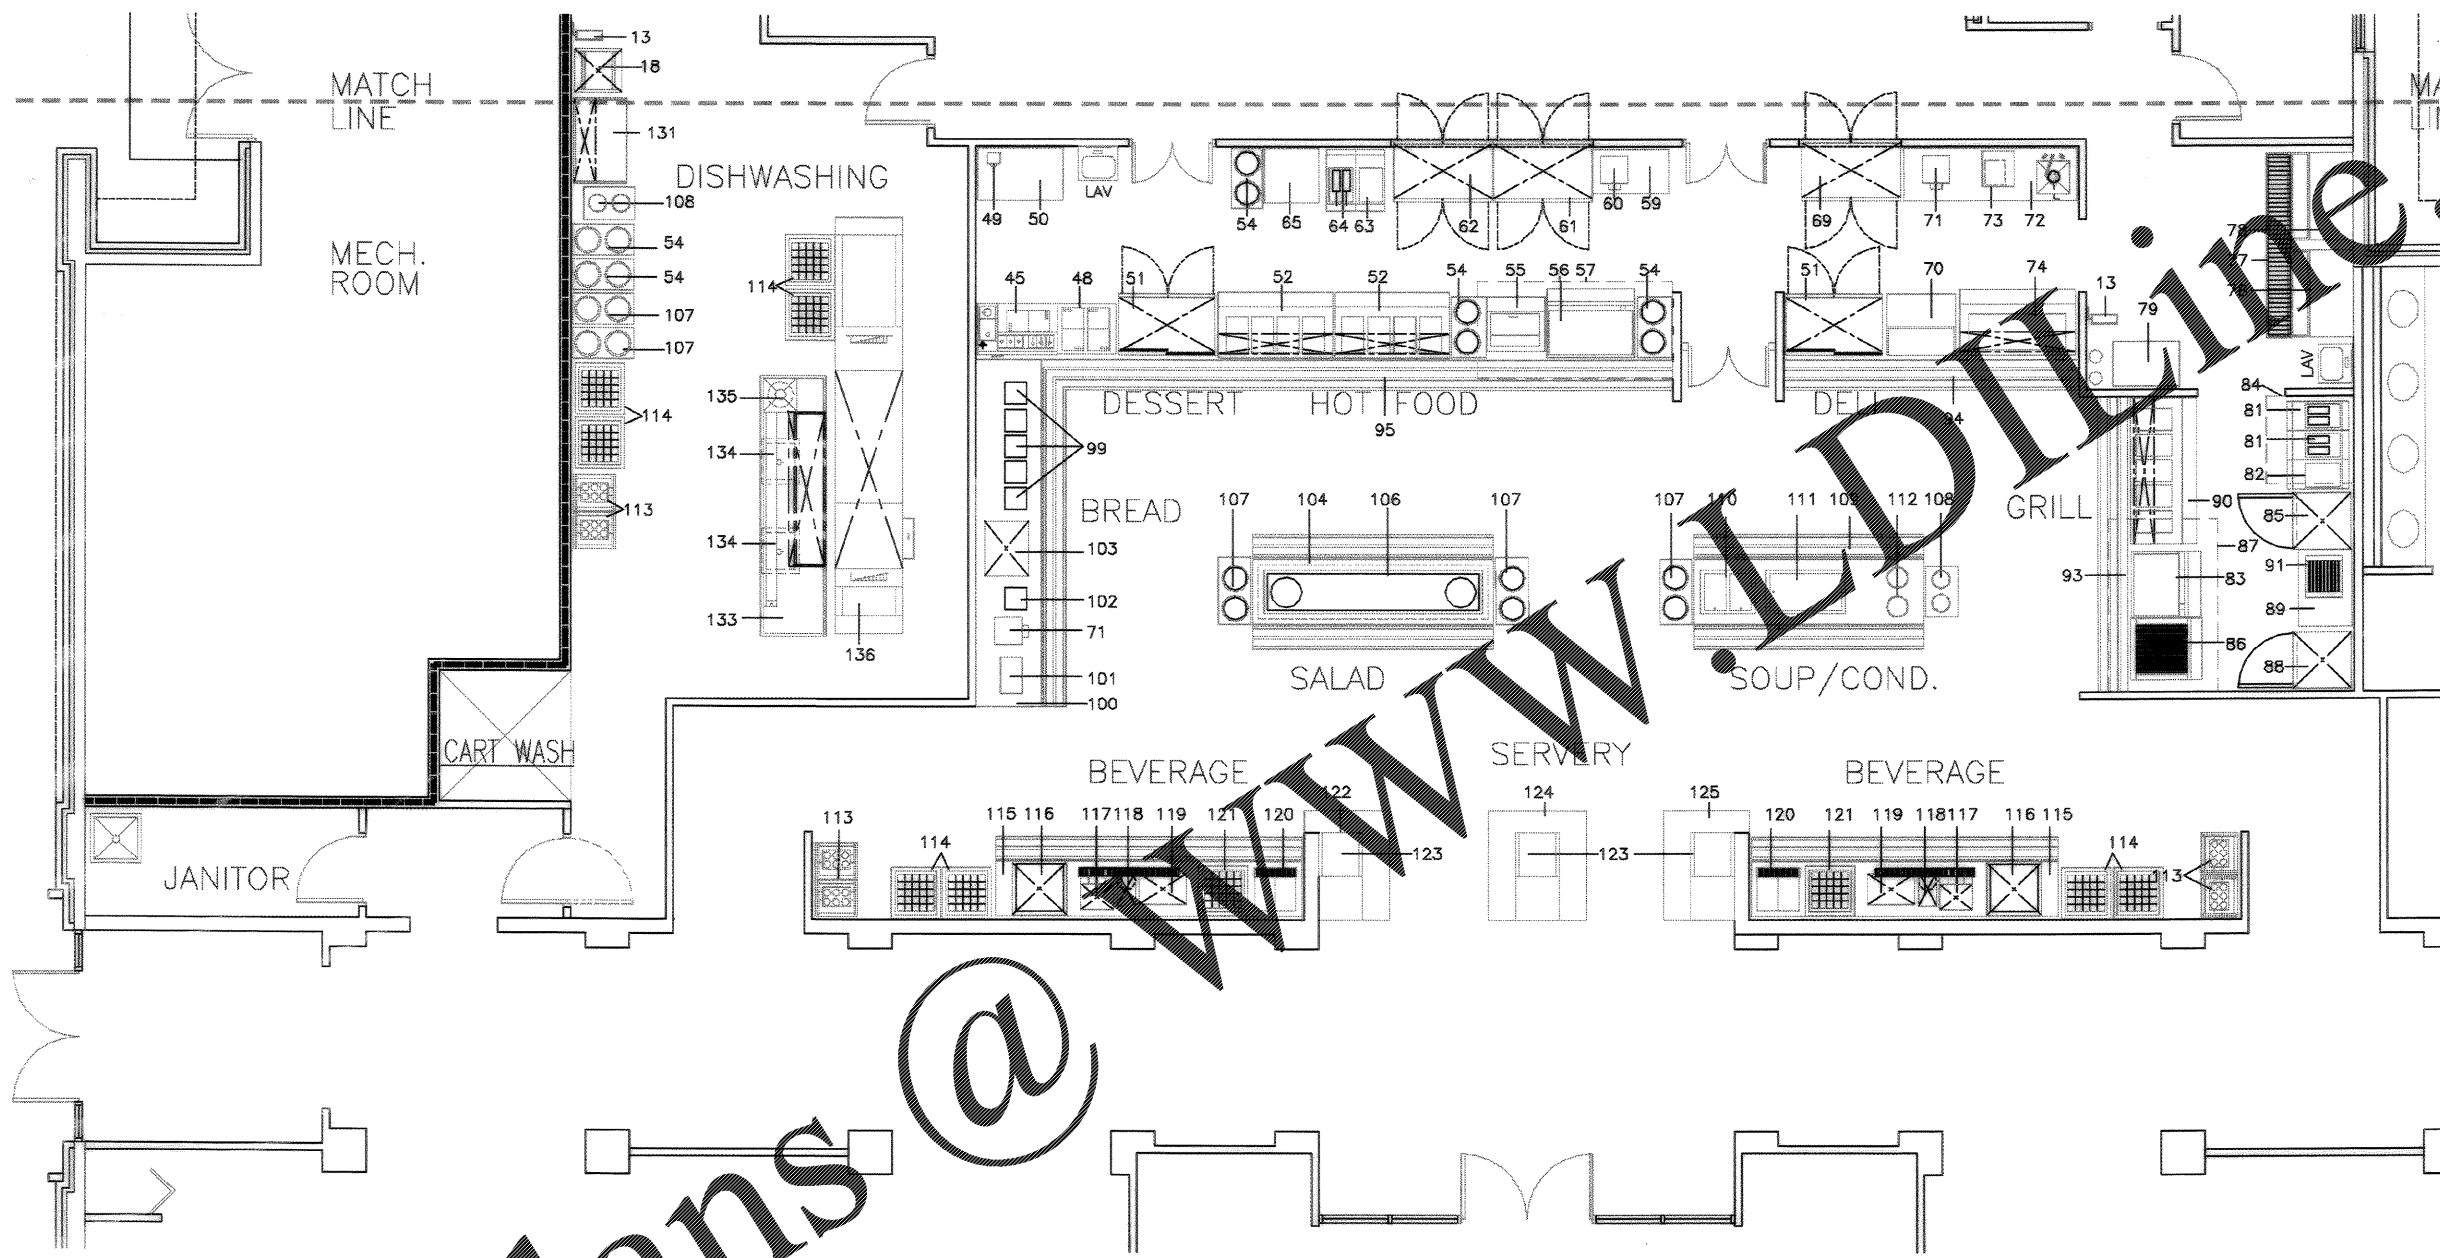

1 KITCHEN AND SERVERY FLOOR PLAN
 K103 1/4"=1'-0"

RECORD DRAWING DATE 4/27/04	
CODE I.D. NO. 80991	
DRAWING SIZE: D	
SPEC. NO. 06-95-0939	
CONSTR. CONTR. NO. N82467-95-C-0939	
NAVFAC DRAWING NO. 5357925	
SHEET 101 OF 194	
K103	
Naval Facilities Engineering Command Southern Division Charleston, South Carolina	
CHARLESTON AIR FORCE BASE CHARLESTON, SOUTH CAROLINA DINING FACILITY KITCHEN AND SERVERY FLOOR PLAN APPROVED: <i>[Signature]</i> DATE: <i>[Date]</i> BY: <i>[Name]</i> AND COR. COMMANDER, WHIC:	
DRAWING REVISIONS Description 1. <i>[Revision]</i>	Prep By: <i>[Name]</i> Date: <i>[Date]</i> Checked By: <i>[Name]</i> Date: <i>[Date]</i> Submitted By: <i>[Name]</i> Date: <i>[Date]</i> Checked By: <i>[Name]</i> Date: <i>[Date]</i> Submitted By: <i>[Name]</i> Date: <i>[Date]</i> Checked By: <i>[Name]</i> Date: <i>[Date]</i>