


Order Plans @

WWW.Engineering.com

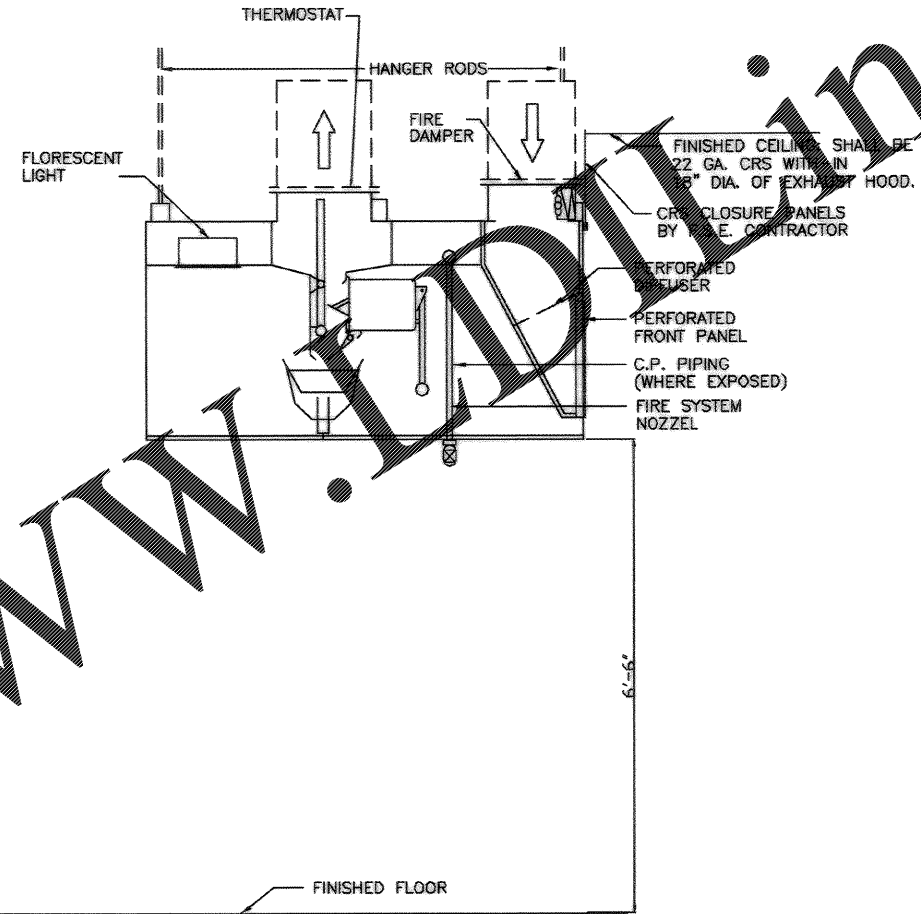

1 HOOD SECTION ITEM # 57 & 87
K103/K504 NO SCALE

GSKY/Bochert, Jr. Associates, Inc. 247 Meeting Street, S.W. Charleston, S.C. 29401 (803) 727-6377	
DRAWING REVISIONS Description Date By	PREPARED BY DATE CHECKED BY DATE APPROVED BY DATE
1 1/21/04 E/S/PL E/S/PL	THERMAL BARRIER PRE
CHARLESTON AIR FORCE BASE CHARLESTON, SOUTH CAROLINA DINING FACILITY VENTILATION DETAILS	
APPROVED: <i>[Signature]</i> P.E. DATE: 5/10/04 EXP. FOR COMMANDER, NAVFAC	
Naval Facilities Engineering Command Southern Division Charleston, South Carolina	
RECORD DRAWING DATE: 9/27/04 CODE LD. NO.: 80091 DRAWING SIZE: D SPEC. NO. 06-98-0939 CONSTR. CONTR. NO.: NB2467-98-C-0939 NAVFAC DRAWING NO.: 535793B SHEET 113 OF 194	
K504	