


Order Plans @ www.dlLine.com

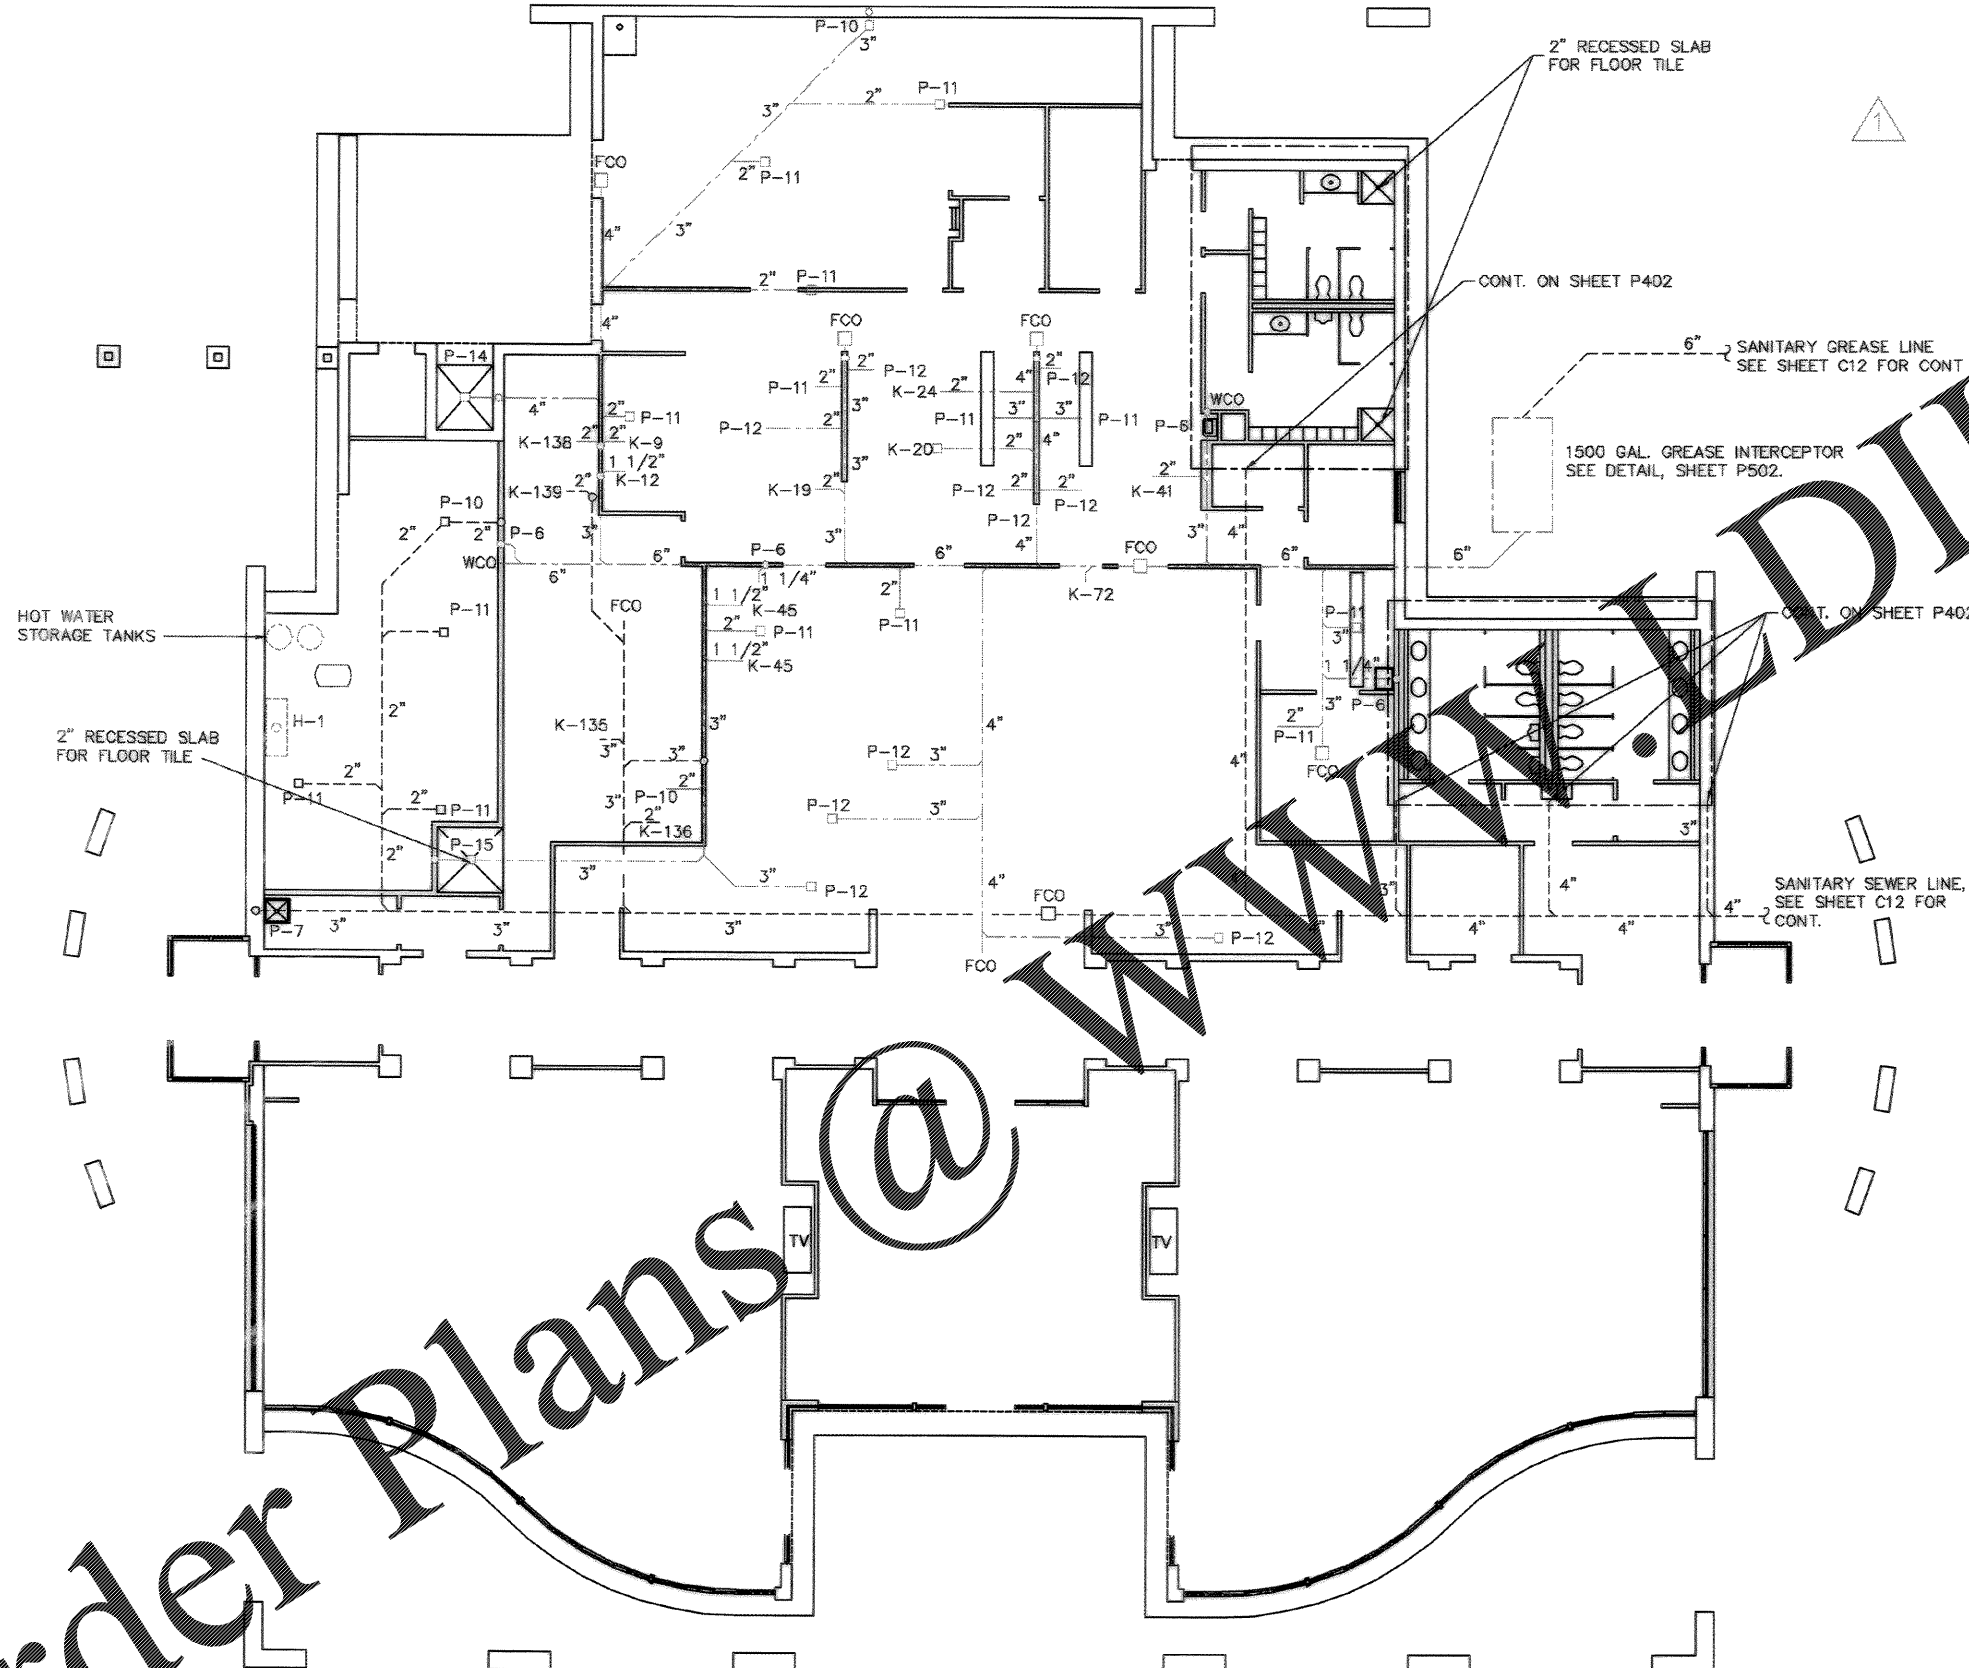


- NOTES:**
1. REFER TO SHEETS K301 AND K302 FOR DETAILED KITCHEN EQUIPMENT INSTALLATION INFORMATION.
 2. SEWER LINES APPROVED AS SCHEDULE 40 PVC.

CRICK/BROOKS & ASSOCIATES, INC. 247 Meeting Street Charleston, S.C. 29403 (803) 737-6377	DATE 7/1/09	TIME
DESIGNED BY J. S. BARNES	DATE	TIME
CHECKED BY J. S. BARNES	DATE	TIME
APPROVED BY J. S. BARNES	DATE	TIME
TECHNICAL MANAGER		

REV.	DESCRIPTION	DATE	BY	CHKD.
1	DRWG. CORRECTED TO AS-BUILT	7/1/09	JMB	JMB

CHARLESTON AIR FORCE BASE
CHARLESTON, SOUTH CAROLINA
DINING FACILITY
SANITARY WASTE & SEWER PLAN
APPROVED BY: JMB DATE: 7/1/09

Naval Facilities Engineering Command
Southern Division
Charleston, South Carolina

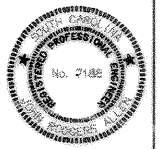

RECORD DRAWING DATE 9/27/09
CODE LD. NO. 80081
DRAWING SIZE: D
SPEC. NO. 06-88-0830
CONSTR. CONTR. NO. NS2467-88-C-0830
NAVFAC DRAWING NO. 6357950
SHEET 128 OF 184

SANITARY WASTE & SEWER PLAN - DINING HALL
SCALE: 1/8" = 1'-0"

P-102