




ENLARGED PLAN - WASTE AND VENT
SCALE: 1/4"=1'-0"

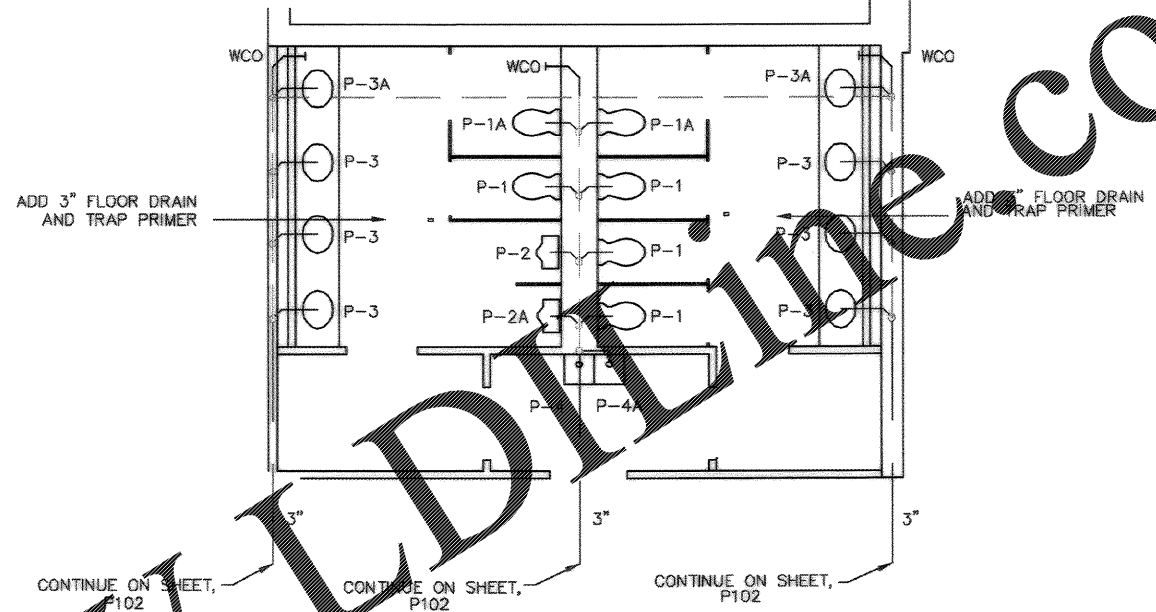

ENLARGED PLAN - WASTE AND VENT
SCALE: 1/4"=1'-0"

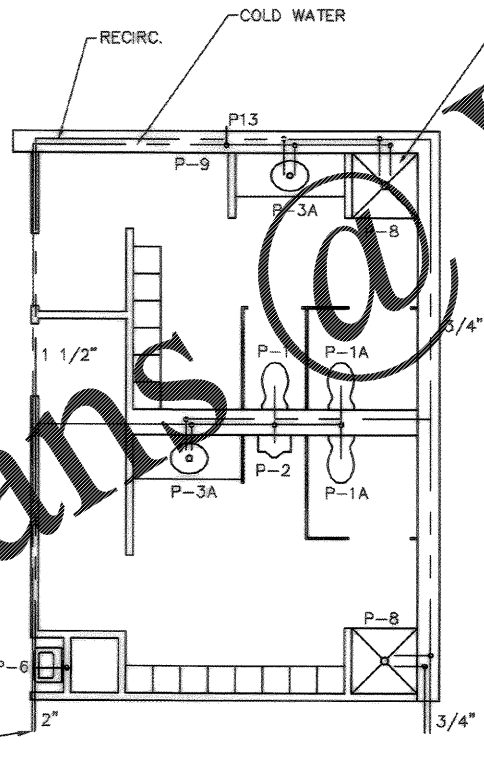

ENLARGED PLAN - COLD AND HOT WATER
SCALE: 1/4"=1'-0"

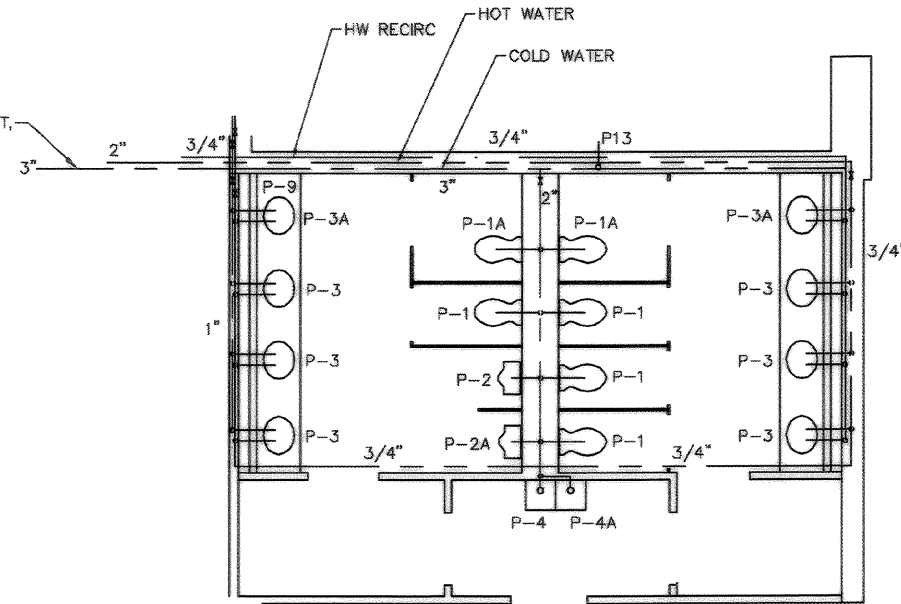

ENLARGED PLAN - COLD AND HOT WATER
SCALE: 1/4"=1'-0"

Order Plans @

WWW.LDLINE.COM



Naval Facilities Engineering Command
Southern Division
Charleston, South Carolina

CHARLESTON AIR FORCE BASE CHARLESTON, SOUTH CAROLINA
DINING FACILITY
BATHROOM WATER & WASTE

Rev.	Description	Date	By	Checked	Approved	Scale	Sheet No.	Total Sheets	Project No.	Project Name
1	DRWG. CORRECTED TO AS-BUILT	11/11	W/T							

RECORD DRAWING DATE: 9/27/64
CODE I.D. NO. 80881
DRAWING SIZE: D
SPEC. NO. 06-88-0906
CONS. PLAN, CONTR. NO. MS2487-88-C-0939
NAVFAC DRAWING NO. 5357952
SHEET 127 OF 194

P-402