

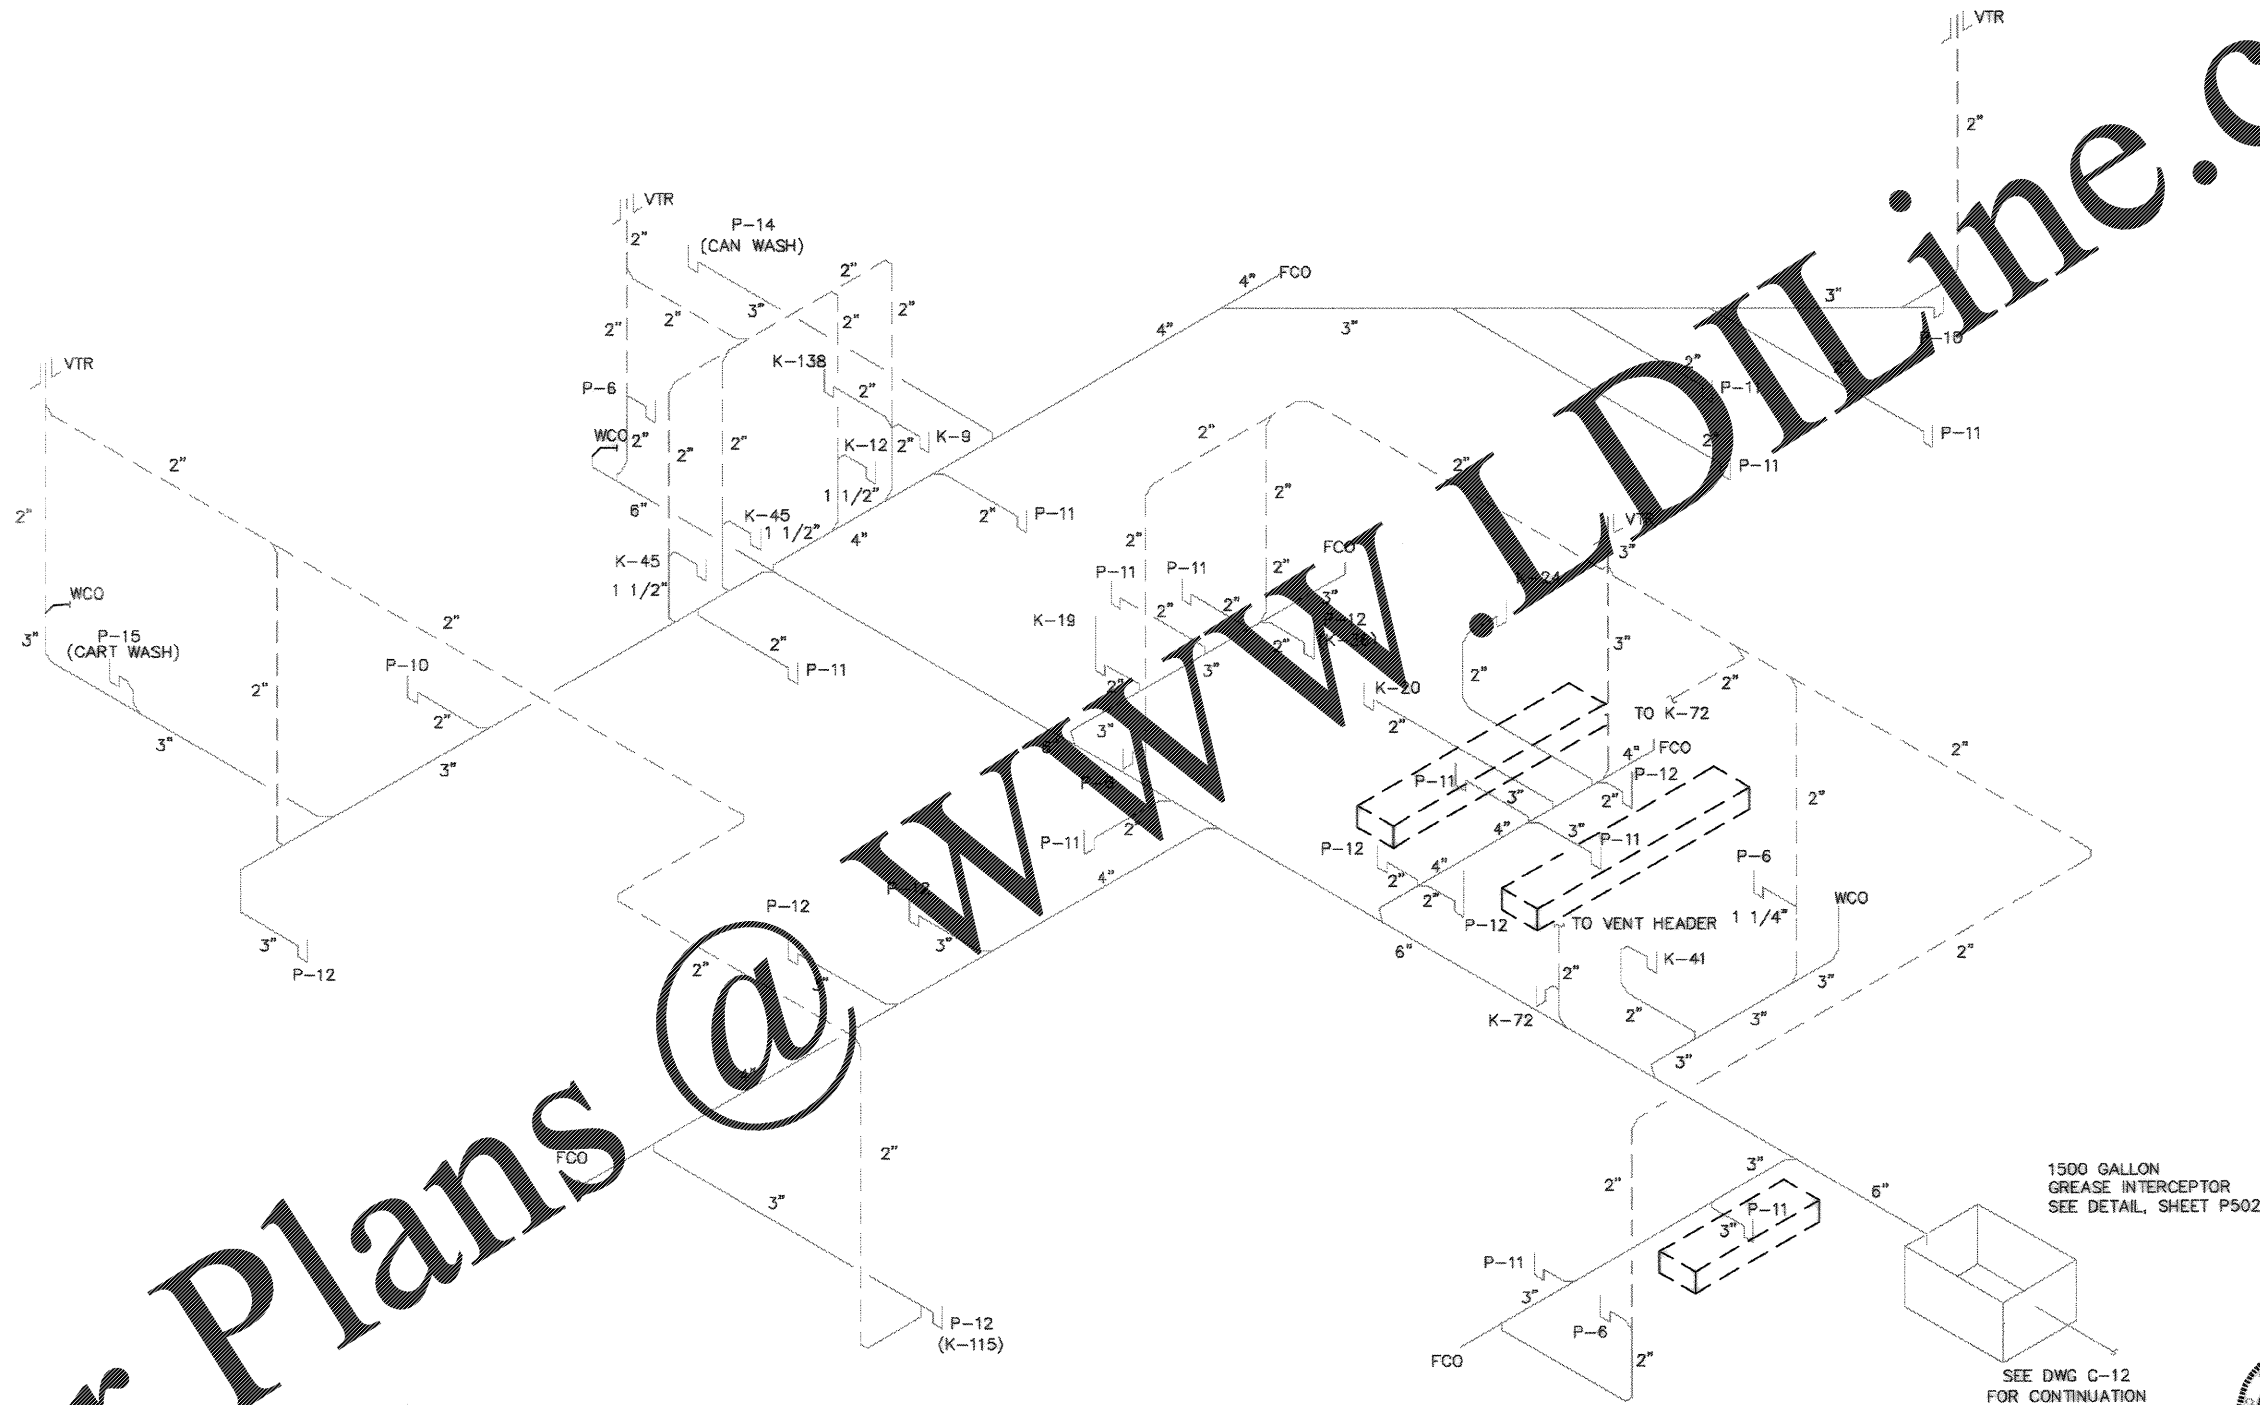


Order Plans @

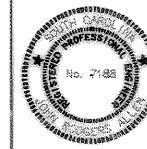

SANITARY GREASE RISER

NTS

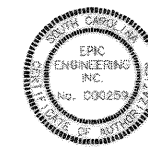

RECORD DRAWING DATE: 02/27/04
 CODE ID NO.: B0181 D
 DRAWING SIZE: 11x17
 SPEC. NO.: D6-88-0939
 CONSTRUCTION, CONTR. NO.: N62467-98-C-0839
 NAVFAC DRAWING NO.: 5357955

SHEET 130 OF 194

P-901

REV.	DATE	DESCRIPTION	BY	CHKD.	DATE
1	02/27/04	AS-BUILT DRWG. NO CORRECTIONS	ADD	ADD	

DRAWING REVISIONS

CHARLESTON AIR FORCE BASE
 CHARLESTON, SOUTH CAROLINA
DINING FACILITY
 SANITARY GREASE RISER

Naval Facilities Engineering Command
 Southern Division
 Charleston, South Carolina



REVISIONS

DATE FOR COMMENT: 02/27/04