



Order Plans @ www.wdwline.com

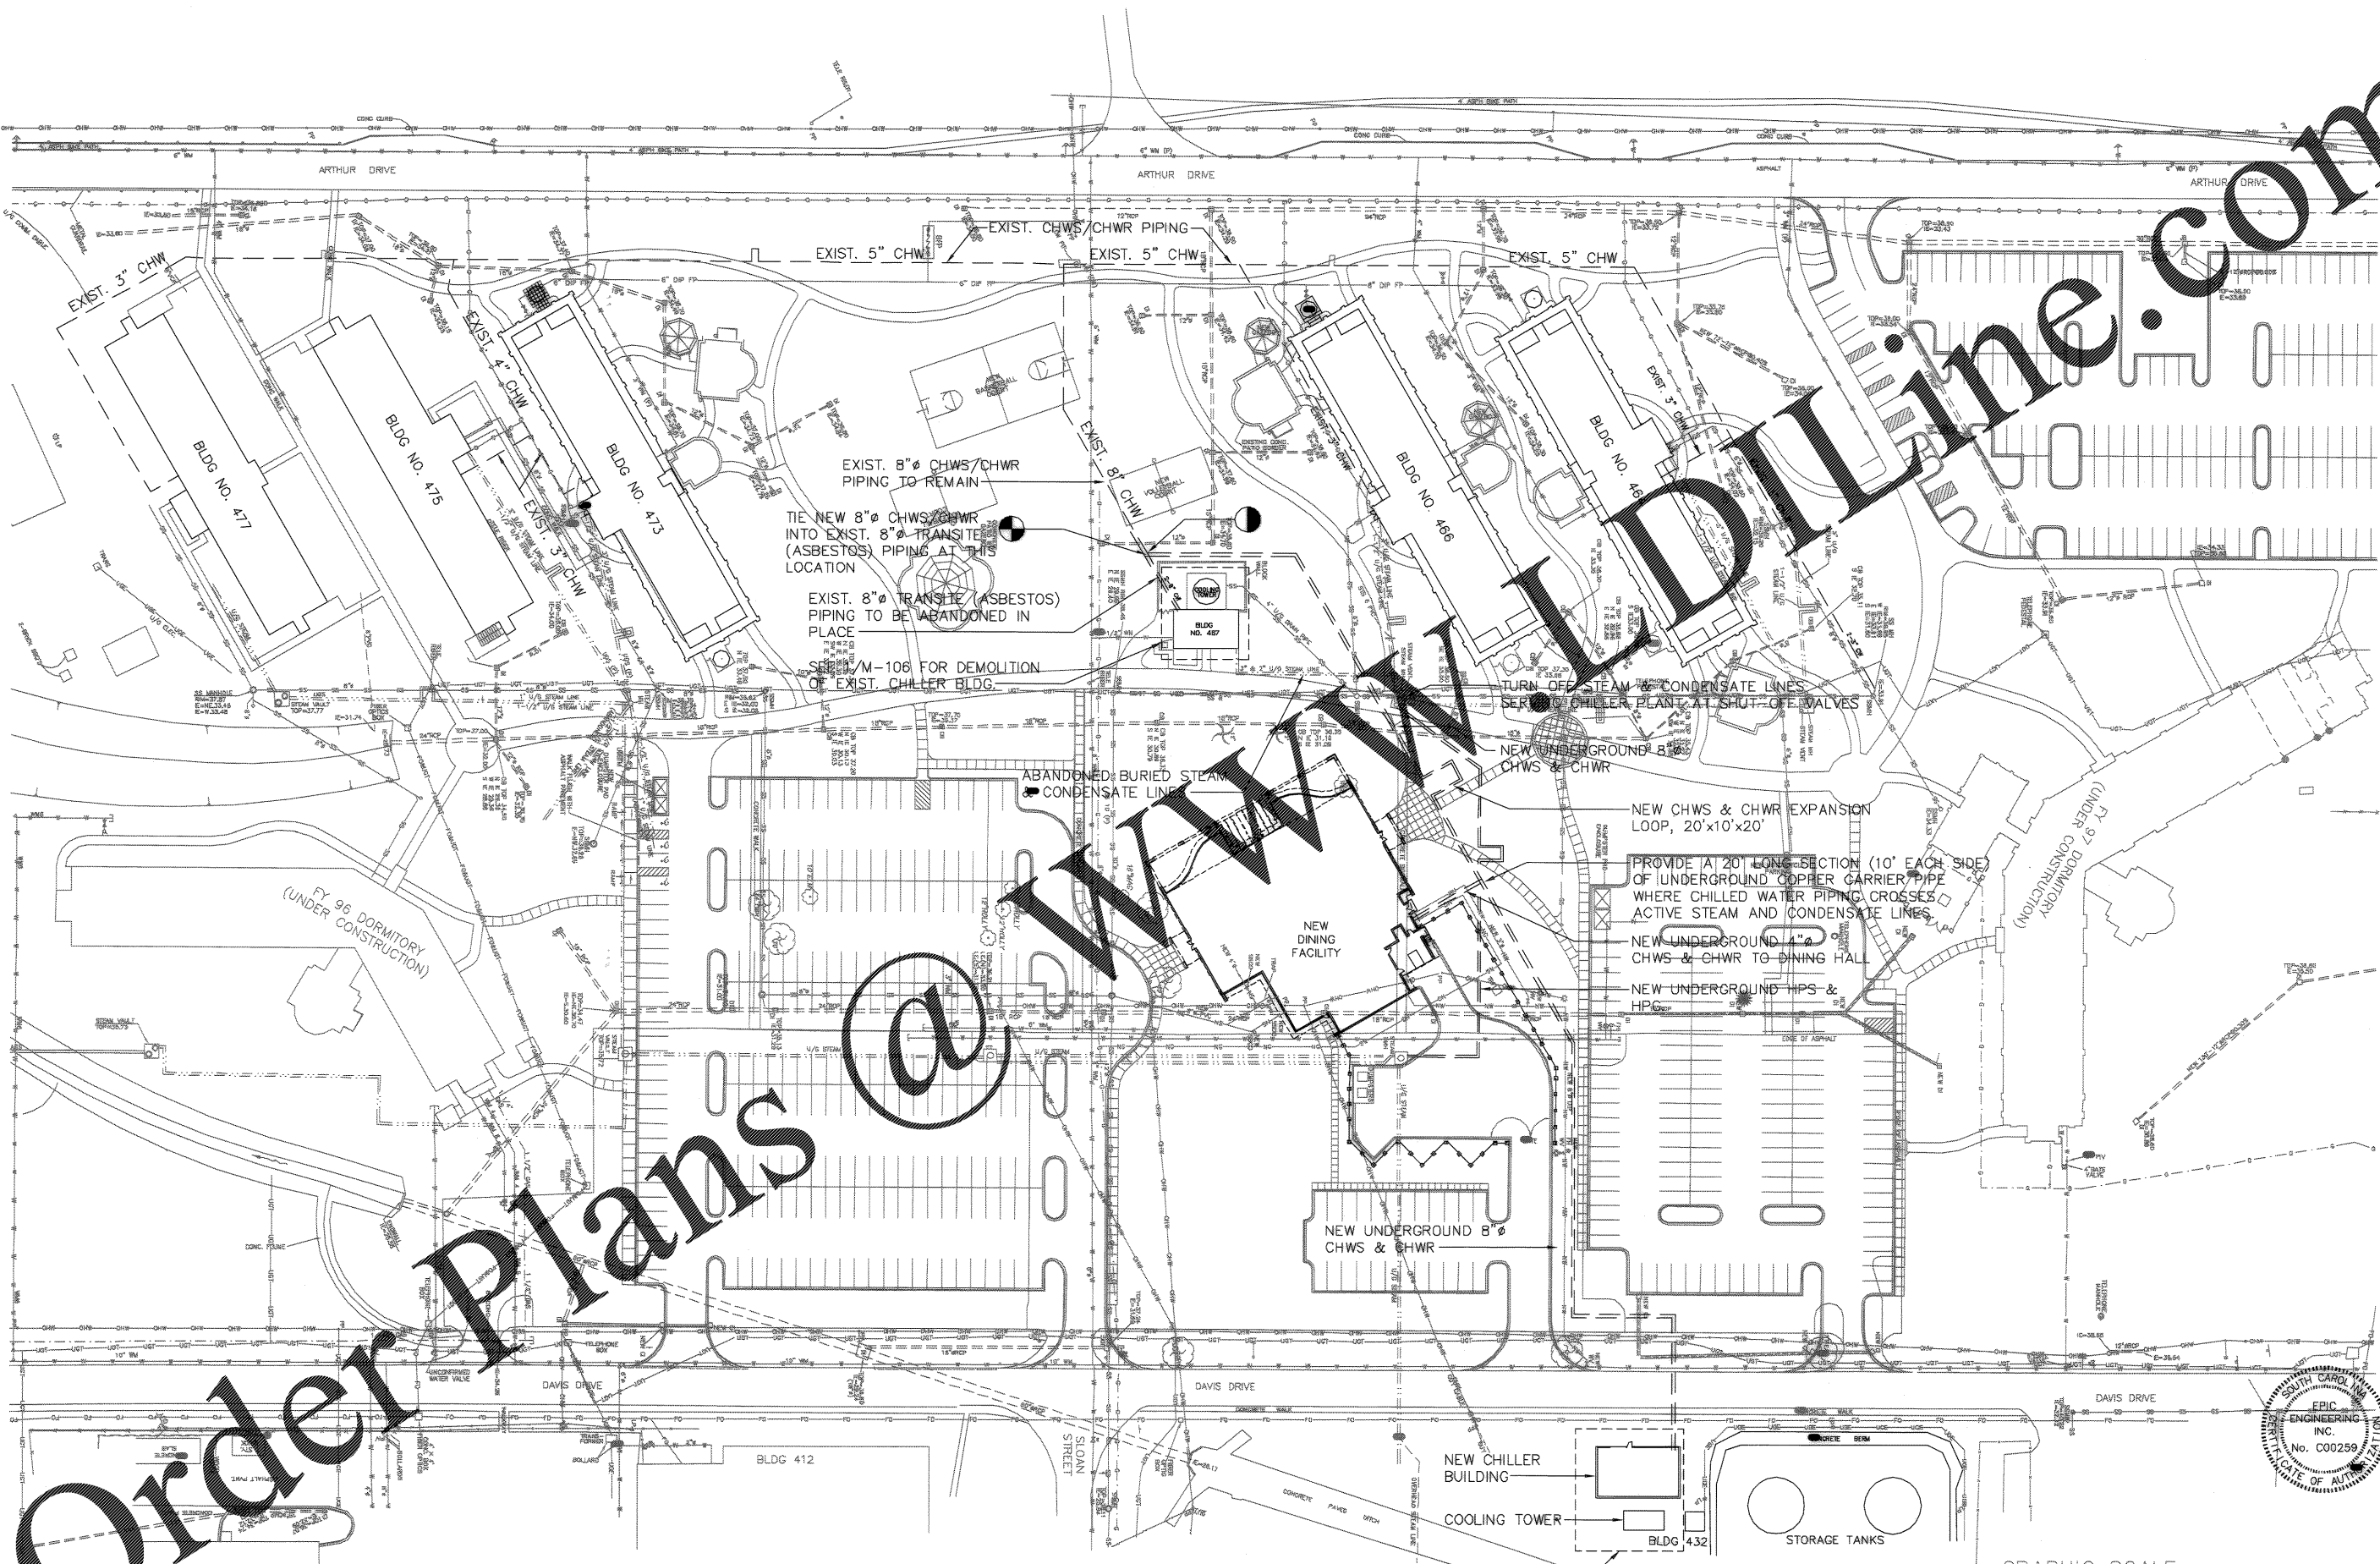

1
M102 MECHANICAL SITE PLAN
SCALE: 1"=50'-0"

SEE SHEET 1/M-105 FOR
WORK IN THIS AREA

GRAPHIC SCALE

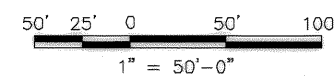

<p>RECORD DRAWING DATE 9/28/04 CODE I.D. NO. 80091 DRAWING SIZE: D SPEC. NO. 06-98-0939 CONSTR. CONTR. NO. N62467-98-C-0939 NAVFAC DRAWING NO. 5357960 SHEET 135 OF 194</p>		<p>NO. 7188 EPIC ENGINEERING INC. No. 00259 STATE OF AUTHORITY</p>		<p>NO. 00259 RODGERS ALLEN</p>	
<p>Naval Facilities Engineering Command Southern Division Charleston, South Carolina</p>		<p>CHARLESTON AIR FORCE BASE CHARLESTON, SOUTH CAROLINA</p>		<p>DINING FACILITY MECHANICAL SITE PLAN - CPRO</p>	
<p>APPROVED: <i>RJ Maco PE</i> DATE: 5/1/04</p>		<p>ETD FOR COMMANDER, NAVFAC</p>		<p>DATE: 5/1/04</p>	
<p>Rev. 1 AS-BUILT</p>		<p>Description: AS-BUILT</p>		<p>Submitted by: SENNATI, OR ENGR ALLEN</p>	
<p>Prep By: H.M. 9/1/04</p>		<p>Date: 9/1/04</p>		<p>Appr. By: SENNATI, OR ENGR ALLEN</p>	
<p>DRAWING REVISIONS</p>		<p>Click/Boehm & Associates, Inc. 247 Meeting Street, Suite 100 Charleston, S.C. (803) 577-6377</p>		<p>DATE: 5/1/04</p>	