


Order Plans @


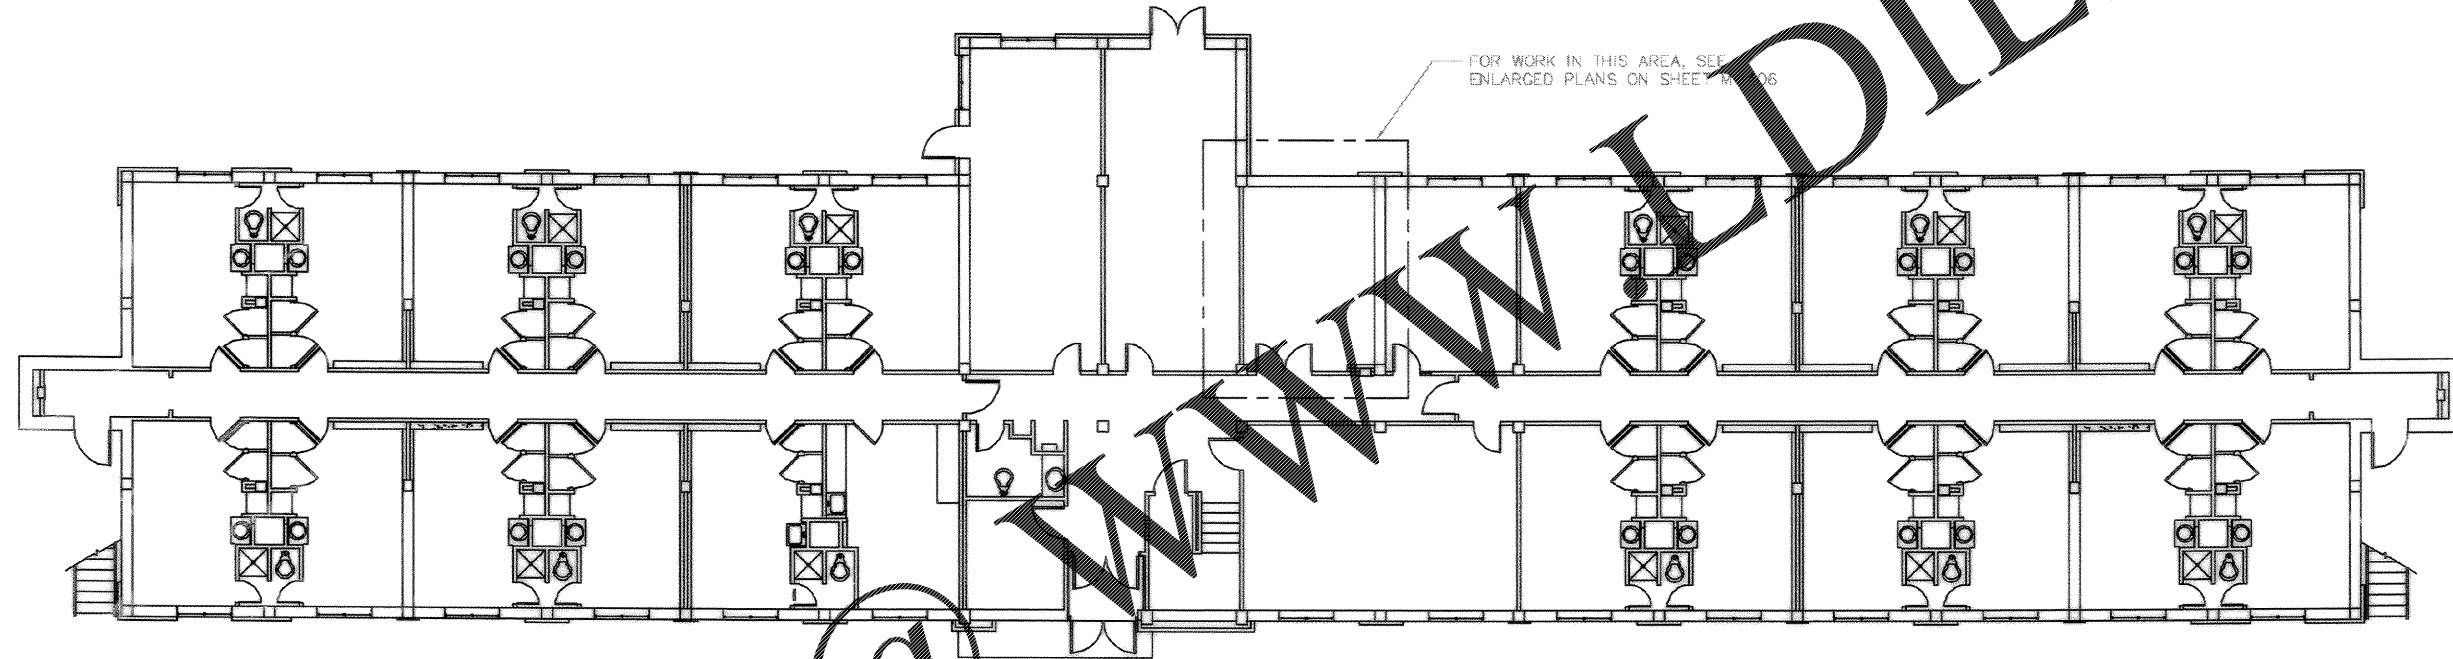


M109

MECHANICAL FIRST FLOOR PLAN - BUILDING 477

SCALE: 1/8"=1'-0"

FOR WORK IN THIS AREA, SEE ENLARGED PLANS ON SHEET M-106

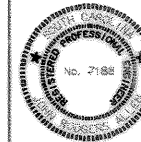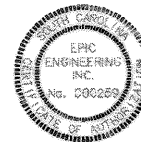

Naval Facilities Engineering Command
Southern Division
Charleston, South Carolina

CHARLESTON AIR FORCE BASE
DINING FACILITY
DORM 477 MECH. PLAN - CPRO

CHARLESTON, SOUTH CAROLINA
APPROVED: *RD/MS* PE DATE: *5/14/84* EPC FILE NUMBER: *NAFAC*

Rev.	Description	By	Date	Appr.
1	AS SHOWN, NO CORRECTIONS	ADP	5/14/84	ADP

Click/Beal, Inc.
247 Meeting Street
Charleston, S.C. 29401
Tel: (803) 777-8377

Prepared by: *ADP*
Checked by: *ADP*
Reviewed by: *ADP*
Submitted by: *ADP*
Mechanical Branch

RECORD DRAWING DATE: *9/27/84*
CODE & NO.: *90081*
DRAWING SIZE: *D*
SPEC. NO. *06-88-0938*
CONSTR. CONTR. NO. *602467-98-C-0939*
NAVFAC DRAWING NO. *6357967*
SHEET 142 OF 184

M-109