


Order Plans @

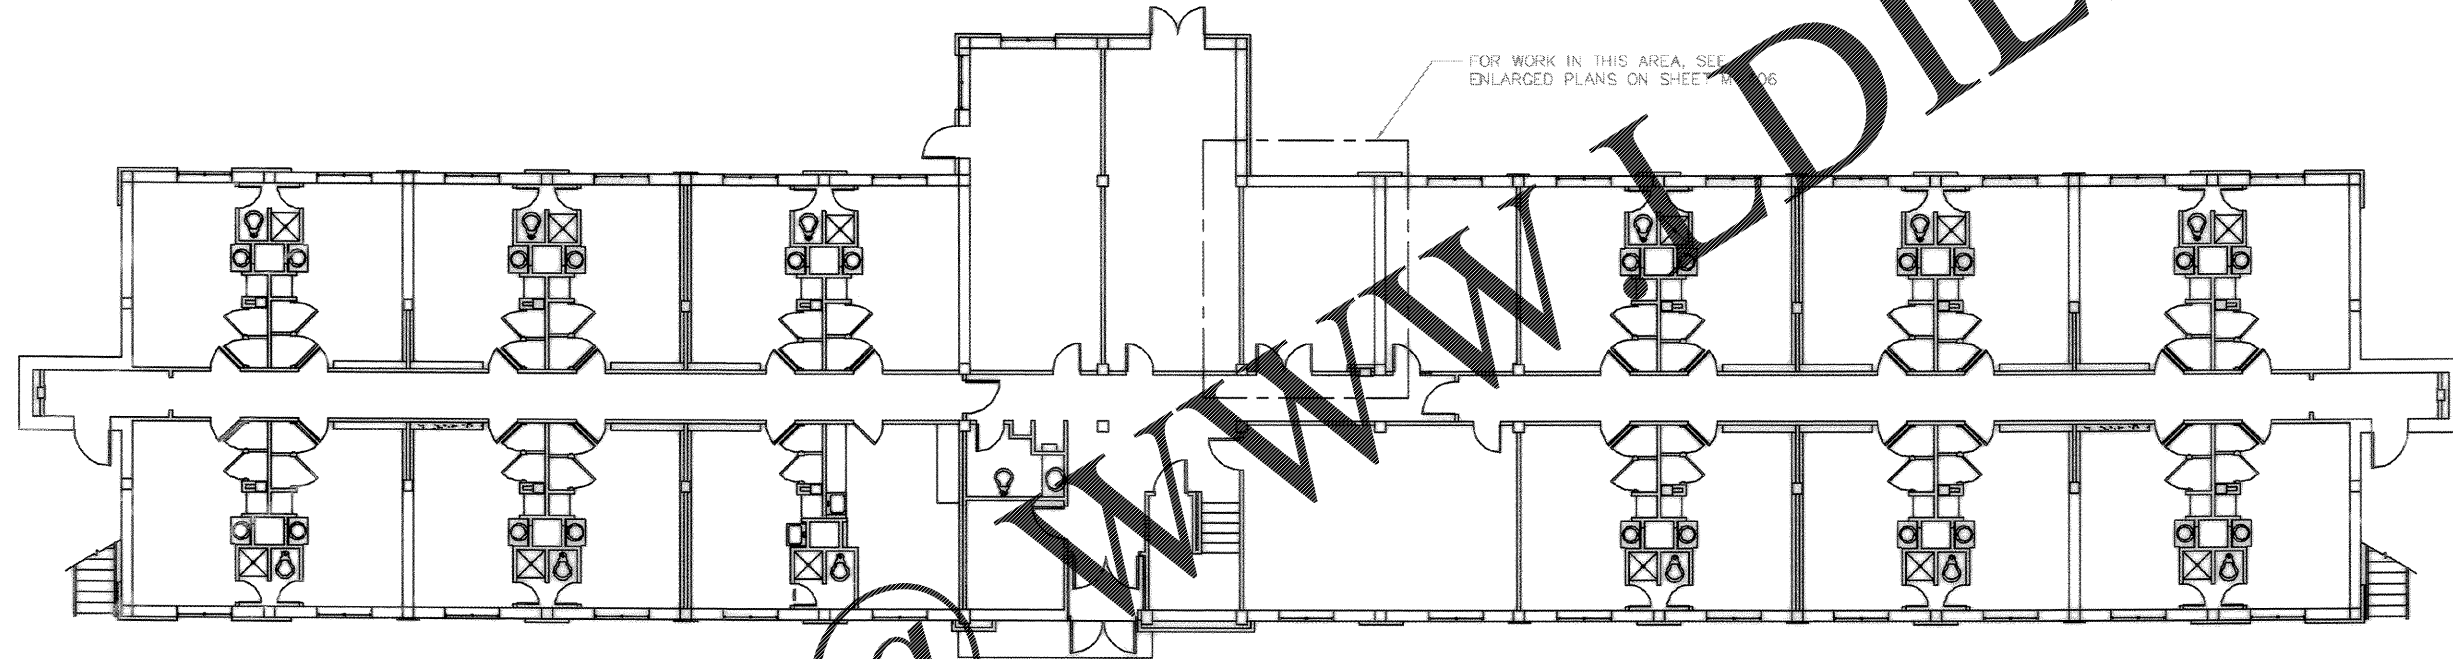


M109

MECHANICAL FIRST FLOOR PLAN - BUILDING 477

SCALE: 1/8"=1'-0"

FOR WORK IN THIS AREA, SEE ENLARGED PLANS ON SHEET M-106

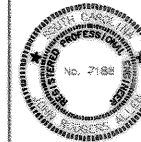

Naval Facilities Engineering Command
Southern Division
Charleston, South Carolina

CHARLESTON AIR FORCE BASE
DINING FACILITY
DORM 477 MECH. PLAN - CPRO

CHARLESTON, SOUTH CAROLINA
APPROVED: *RD/MS* PE DATE: *5/11/84* EPC FILE NUMBER: *NAFAC*

Rev.	Description	By	Date	Appr.
1	AS SHOWN, NO CORRECTIONS	MS	5/11/84	MS

Click/Beal, Inc.
247 Meeting Street
Charleston, S.C. 29401
Tel: (803) 777-6377
Fax: (803) 777-6377
E-mail: info@clickbeal.com
Website: www.clickbeal.com

RECORD DRAWING DATE: 9/27/84
CODE & NO.: 90081
DRAWING SIZE: D
SPEC. NO. 06-88-0938
CONSTR. CONTR. NO. 602467-98-C-0939
NAVFAC DRAWING NO. 5357967
SHEET 142 OF 184

M-109