



1
M502 **PIPING SEISMIC RESTRAINT DETAIL**
SCALE: NONE

- NOTES:
- REFER TO SMACNA GUIDELINES FOR MAXIMUM SPACING OF SEISMIC RESTRAINTS.
 - ALL GAS, FIRE SUPPRESSION AND HIGH HAZARD PIPING SYSTEMS SHALL BE SEISMICALLY RESTRAINED (NO EXCEPTIONS). ALL OTHER PIPING SYSTEMS SHALL BE SEISMICALLY RESTRAINED WHEN REQUIRED BY THE VIBRATION SYSTEMS & SEISMIC RESTRAINT SCHEDULE UNLESS NOT REQUIRED BY ANY ONE OF THE FOLLOWING CONDITIONS:
 - PIPING SUSPENDED BY INDIVIDUAL HANGERS 12 INCHES OR LESS IN LENGTH FROM THE TOP OF THE PIPE TO THE SUPPORTING STRUCTURE.
 - PIPING IN BOILER AND MECHANICAL ROOMS WHICH HAS LESS THAN 1 1/4 INCH INSIDE DIAMETER.
 - PIPING IN OTHER AREAS WHICH HAS LESS THAN 2 1/2 INCH INSIDE DIAMETER.


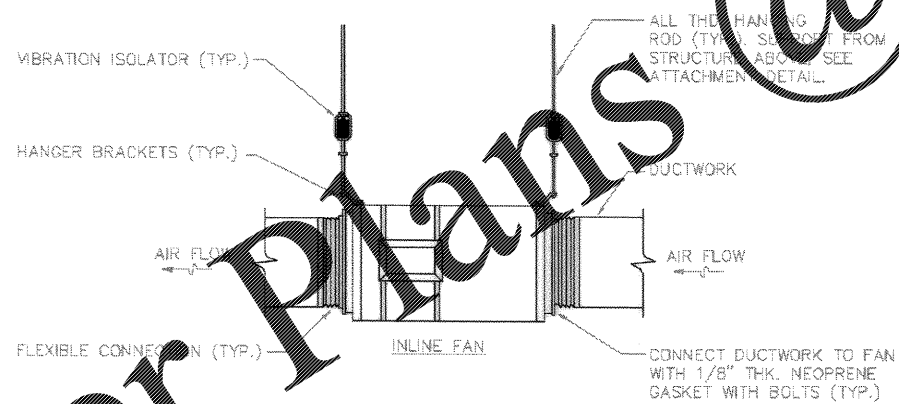


3
M502 **INLINE FAN INSTALLATION DETAIL**
SCALE: NONE

NOTE:
PROVIDE MANUFACTURERS RECOMMENDED CLEARANCES FOR UNIT SERVICE AND ACCESS.

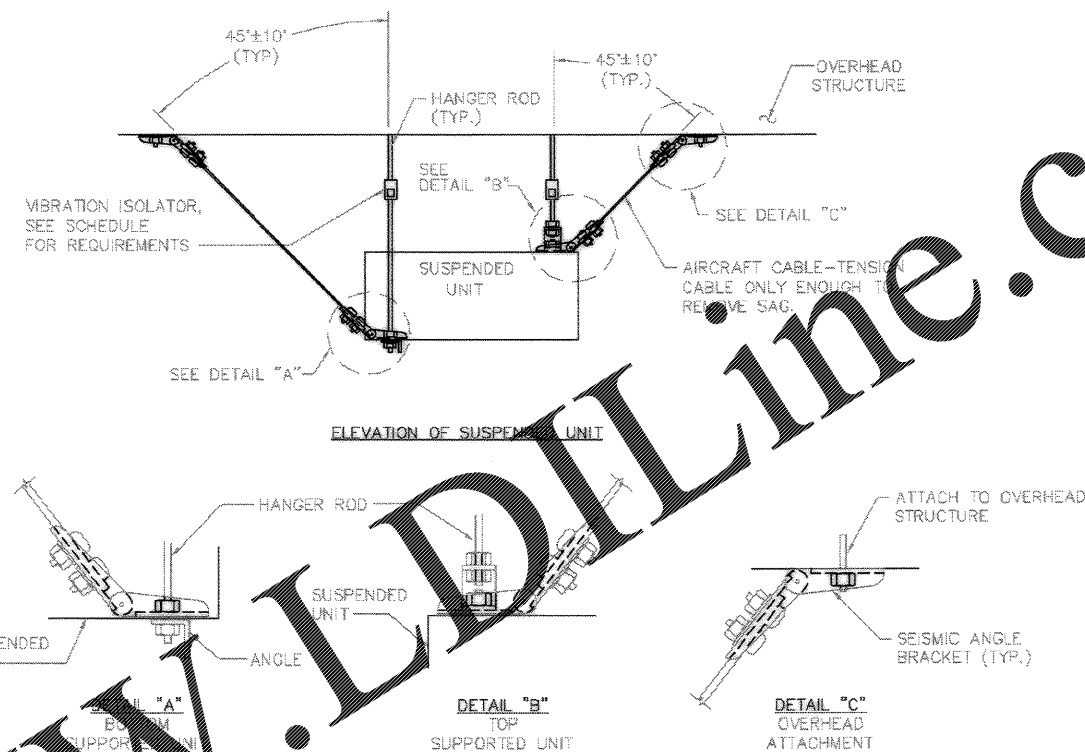

2
M502 **SUSPENDED UNIT SEISMIC RESTRAINT DETAIL**
SCALE: NONE

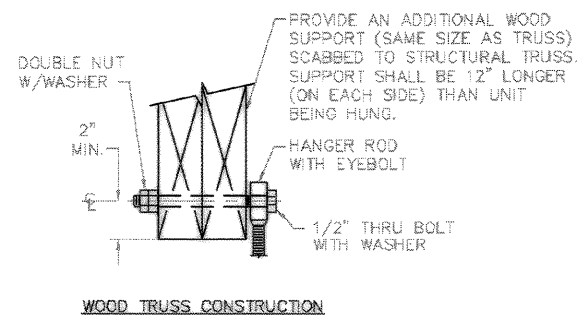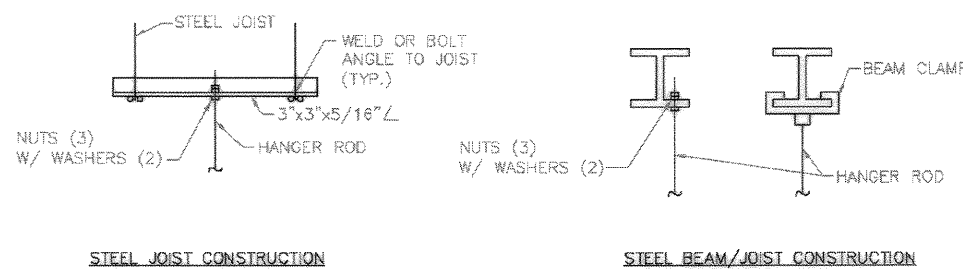

4
M502 **OVERHEAD ATTACHMENT DETAILS**
SCALE: NONE

DRAWING REVISIONS		Click/Boehm & Associates, Inc. 247 Hickory, St. Matthews, N.C. 28105 TEL: 704-837-8377
Rev.	Date	Author
1	11/17/04	Click/Boehm & Associates, Inc.
Description		Click/Boehm & Associates, Inc.
1. AS-BUILT DRAWING, NO CORRECTIONS		Click/Boehm & Associates, Inc.
APPROVED		Click/Boehm & Associates, Inc.
CHARLESTON AIR FORCE BASE		Click/Boehm & Associates, Inc.
CHARLESTON, SOUTH CAROLINA		Click/Boehm & Associates, Inc.
DINING FACILITY		Click/Boehm & Associates, Inc.
TYPICAL DETAILS		Click/Boehm & Associates, Inc.
Naval Facilities Engineering Command		Click/Boehm & Associates, Inc.
Southern Division		Click/Boehm & Associates, Inc.
Charleston, South Carolina		Click/Boehm & Associates, Inc.
RECORD DRAWING DATE		9/27/04
CODE: 1.2, 1.3, 1.4, 9.9, 10.0		
DRAWING SIZE:		D
SPEC. NO. 06-88-0938		
CONSTR. CONTR. NO.		062467-88-C-0939
NAVFAC DRAWING NO.		63579.75
SHEET 130 OF 194		
M-502		

Order Plans @ WWW.LDLine.com