



1 M505 CHILLED AND HOT WATER END SUCTION PUMP DETAIL  
SCALE: NONE

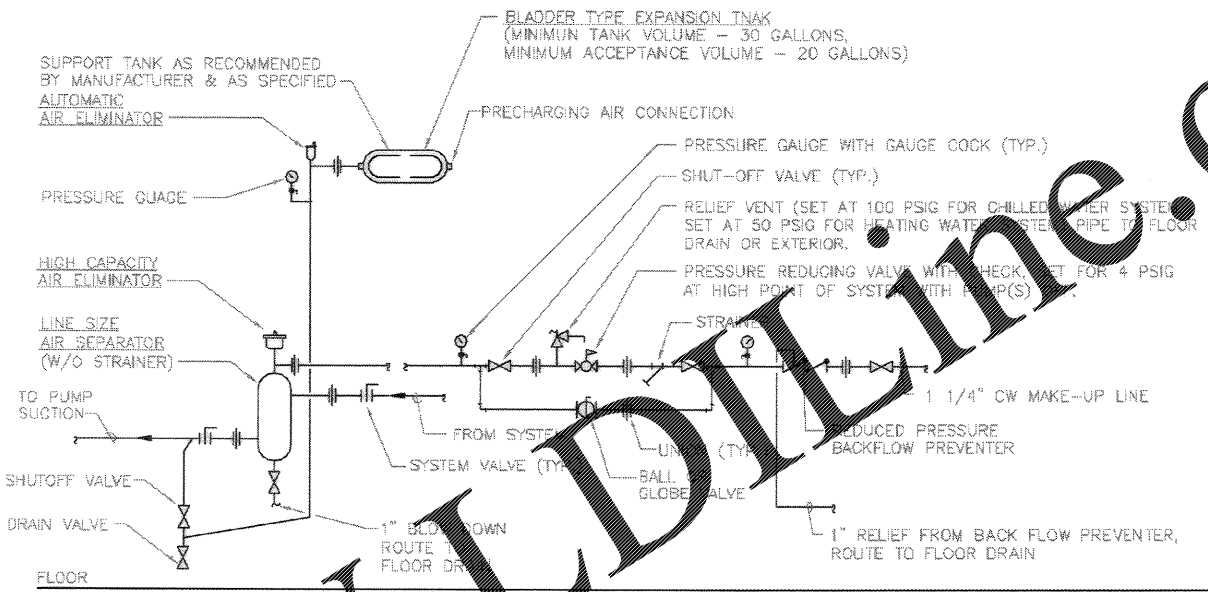


2 M505 EXPANSION TANK, AIR SEPARATOR & MAKE-UP WATER DETAIL  
SCALE: NONE


NOTE: THIS DETAIL USED ONLY FOR BOILER HEATING WATER SYSTEM IF CPRO IS ACCEPTED.

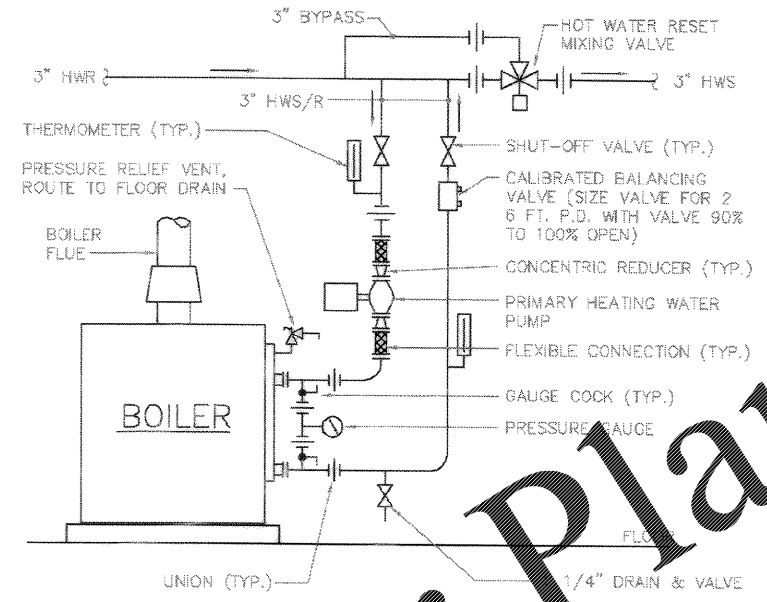

3 M505 HEATING WATER BOILER PIPING DETAIL  
SCALE: NONE

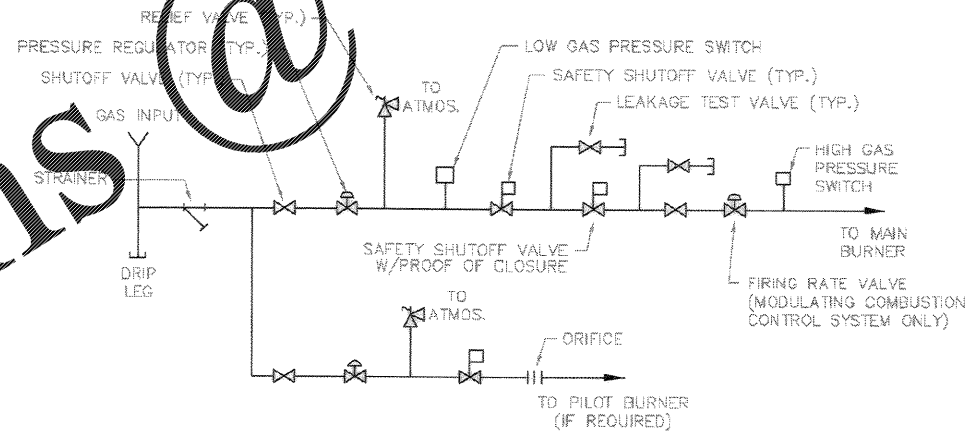

4 M505 GAS TRAIN DETAIL  
SCALE: NONE

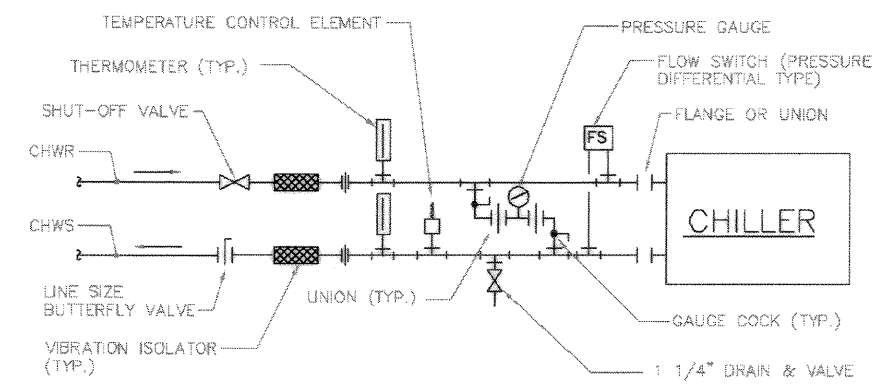

5 M505 AIR COOLED CHILLER PIPING DETAIL  
SCALE: NONE

NOTE: THIS DETAIL NOT USED IF CPRO IS ACCEPTED.

Order Plans

WWW.LDLINE.COM

Prepared by: [Name]  
Checked by: [Name]  
Reviewed by: [Name]  
Date: [Date]

Rev.	Description	Date	By
1	AS-BUILT ORIGIN NO CORRECTIONS	01/14/04	[Name]

CHARLESTON AIR FORCE BASE  
DINING FACILITY  
TYPICAL DETAILS

Naval Facilities Engineering Command  
Southern Division  
Charleston, South Carolina



RECORD DRAWING DATE	9/27/04
CODE LD. NO.	80081
DRAWING SIZE	D
SPEC. NO.	D6-88-0938
CONSTR. CONTR. NO.	N62467-88-C-0938
TRAVEL DRAWING NO.	535737B
SHEET 133 OF 194	
M-505	

