



1 WATER COOLED CHILLER PIPING DETAIL  
SCALE: NONE

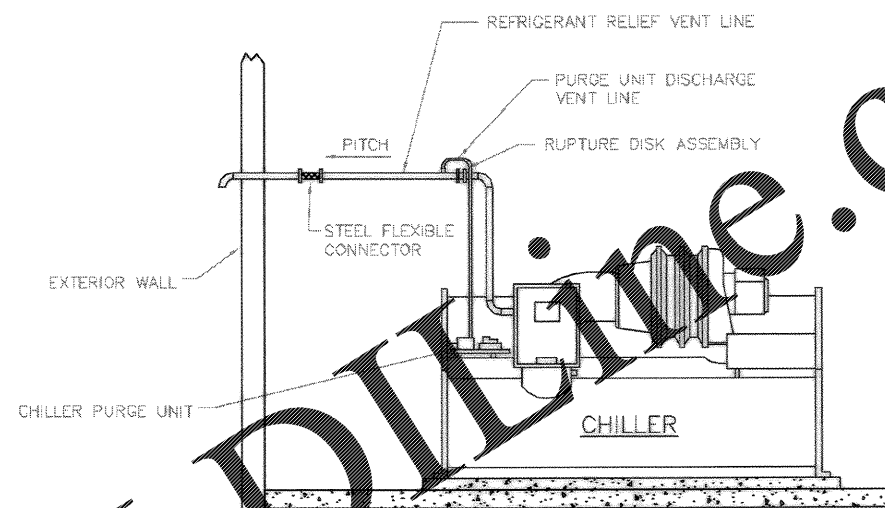


2 REFRIGERANT VENT PIPING DETAIL  
SCALE: NONE

NOTE: SIZE VENT LINES IN ACCORDANCE WITH THE MANUFACTURERS RECOMMENDATIONS.

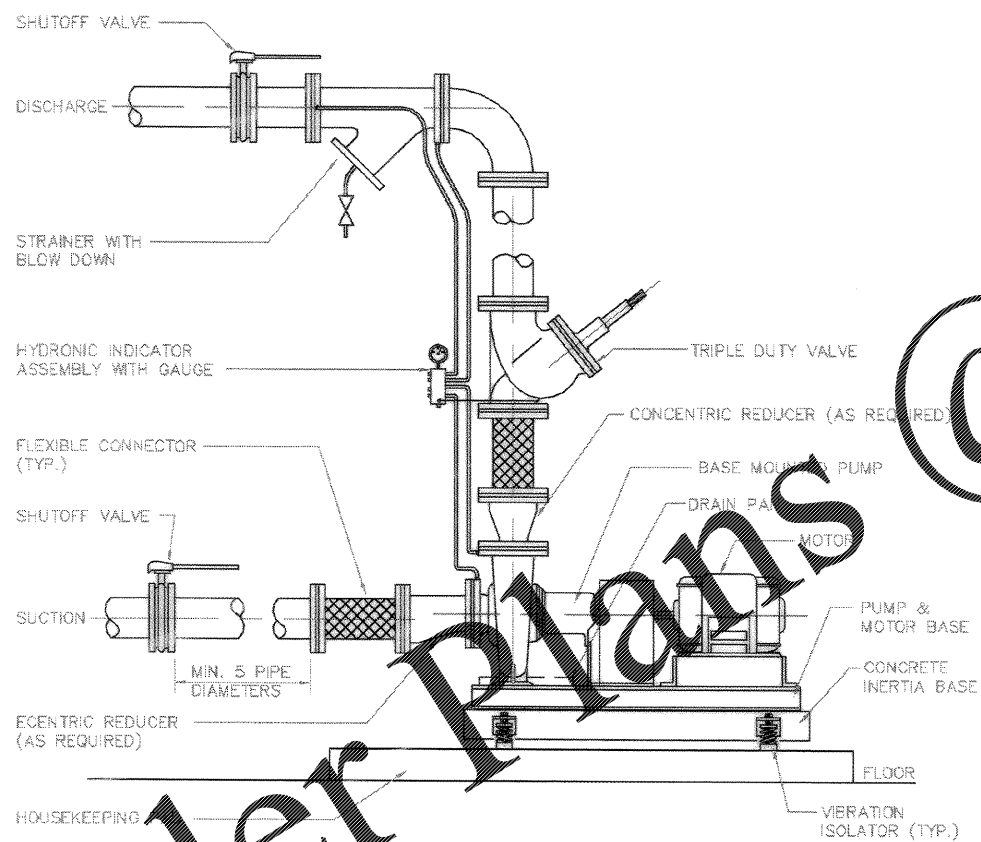

3 CONDENSER WATER END SUCTION PUMP DETAIL  
SCALE: NONE

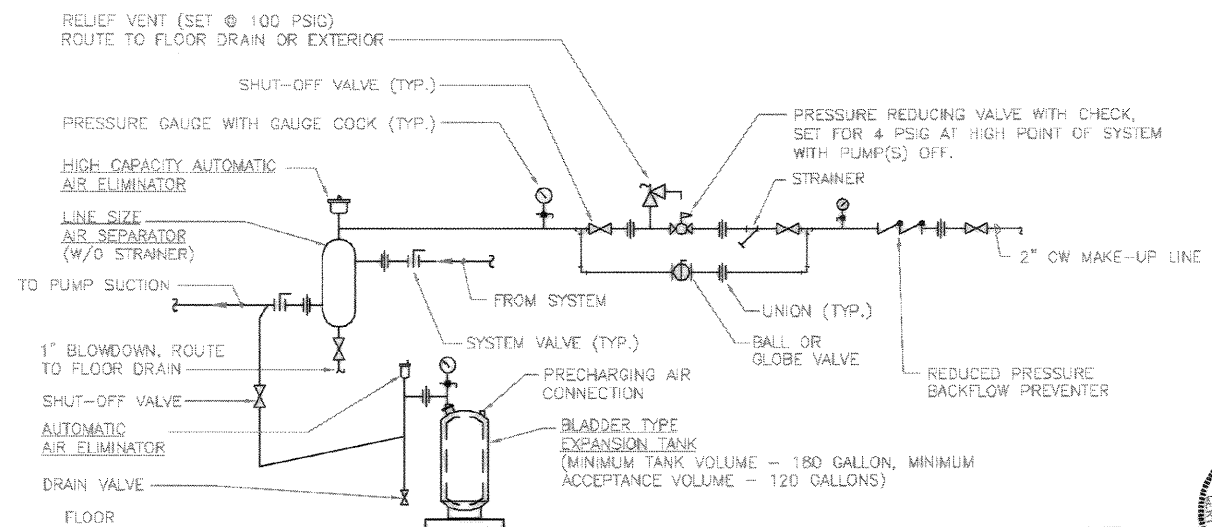

4 EXPANSION TANK, AIR SEPARATOR & MAKE-UP WATER DETAIL  
SCALE: NONE

Grid/Booth & Assoc. Inc. Engineering & Construction, S.C. Charleston, S.C. 29405-1000 (803) 737-6377 FAX (803) 737-6378 E-MAIL: GRIFF@GRIFF.COM WWW.GRIFF.COM	
DRAWING REVISIONS Description No. 1 DRWG. CORRECTED TO AS-BUILT	Prep. By Date 5/14/04 5/14/04
CHARLESTON AIR FORCE BASE DINING FACILITY TYPICAL DETAILS - CPRO	APPROVED RDP/pe DATE 5/14/04 EPD FOR COMMANDER, IN/AVC
Naval Facilities Engineering Command Southern Division Charleston, South Carolina	APPROVED EPIC ENGINEERING INC. No. 7188 No. C00299
RECORD DRAWING DATE 9/27/04 CODE I.D. NO. 80081 DRAWING SIZE: D SPEC. NO. 08-98-0839 CONSTR. CONTR. NO. M2467-98-C-0839 NAFAC DRAWING NO. 5357979 SHEET 154 OF 184	M-506

Order Plans

@

WWW.LDLINE.COM