


1 CHILLED WATER SYSTEM CONTROL DIAGRAM  
SCALE: NONE

NOTE: THIS DIAGRAM NOT USED IF CPRQ IS ACCEPTED.

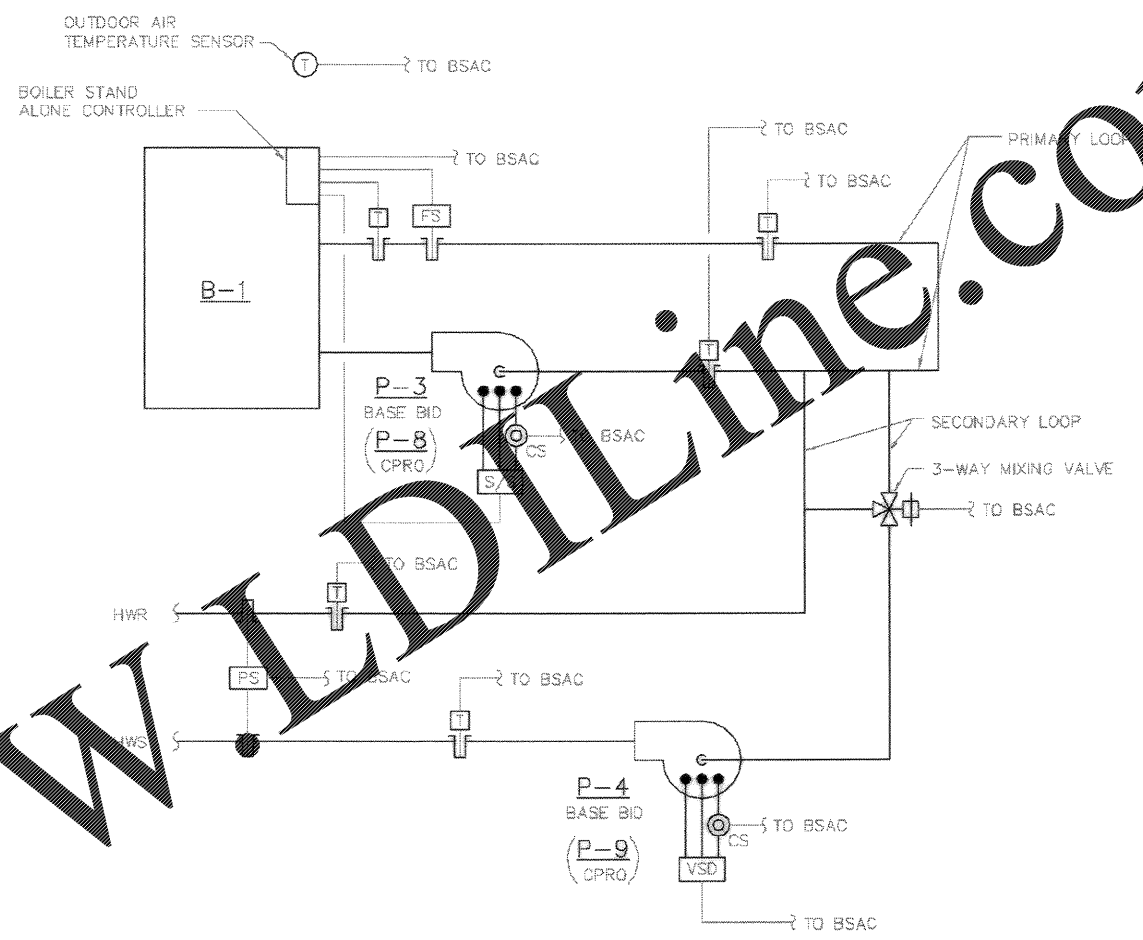

2 HEATING HOT WATER SYSTEM CONTROL DIAGRAM  
SCALE: NONE

Order Plans @

WWW.IDIline.com

Rev.	1	AS-BUILT DIRM. NO CORRECTIONS	DATE	07/14/04	BY	W. J. ALLEN
Prep By	W. J. ALLEN	Date	07/14/04	Appr'd.	W. J. ALLEN	DATE
DRAWING REVISIONS	Description 1. AS-BUILT DIRM. NO CORRECTIONS					

Rev.	1	AS-BUILT DIRM. NO CORRECTIONS	DATE	07/14/04	BY	W. J. ALLEN
Prep By	W. J. ALLEN	Date	07/14/04	Appr'd.	W. J. ALLEN	DATE
DRAWING REVISIONS	Description 1. AS-BUILT DIRM. NO CORRECTIONS					

CHARLESTON AIR FORCE BASE CHARLESTON, SOUTH CAROLINA  
DINING FACILITY  
CONTROL DIAGRAMS  
APPROVED: W. J. ALLEN, PE DATE: 07/14/04 EPD FOR COMMANDER, MAFAC

Naval Facilities Engineering Command  
Southern Division  
Charleston, South Carolina



RECORD DRAWING DATE	9/27/04
CODE I.D. NO.	80091
DRAWING SIZE	D
SPEC. NO.	06-98-0938
CONSTR. CONTR. NO.	NAVFAC 98-C-0939
NAVFAC DRAWING NO.	53579ES
SHEET	161 OF 194

M-606