




1 M608 DORMITORY 477 CONTROL DIAGRAM
SCALE: NONE

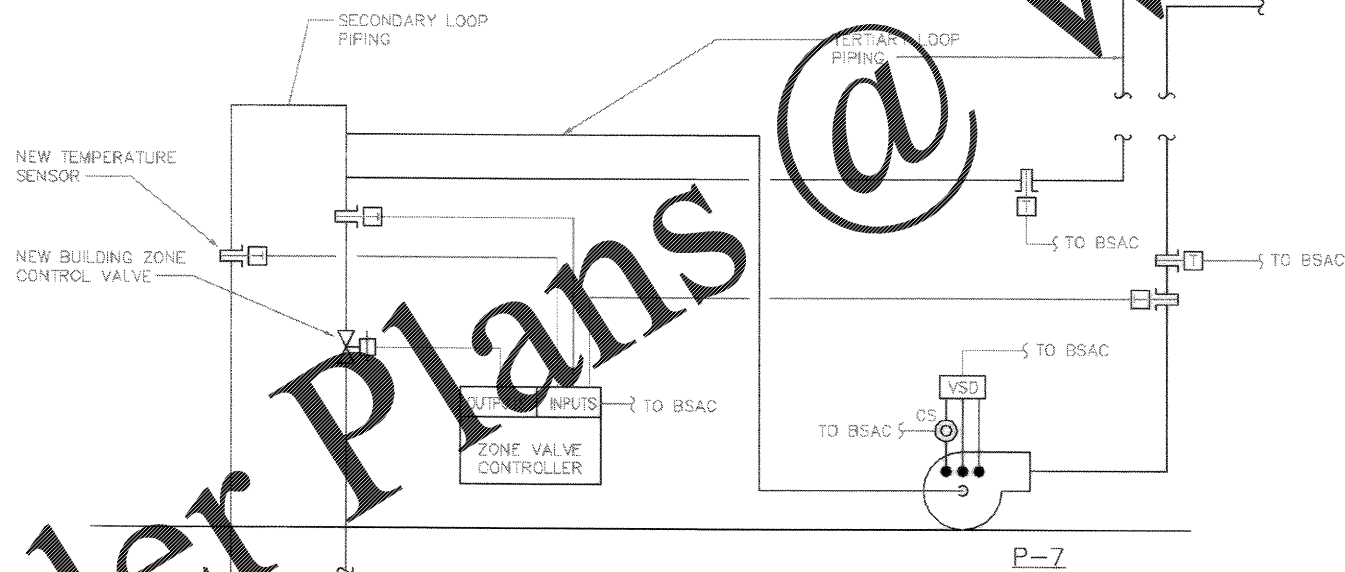

2 M608 DINING FACILITY CHILLED WATER CONTROL DIAGRAM
SCALE: NONE

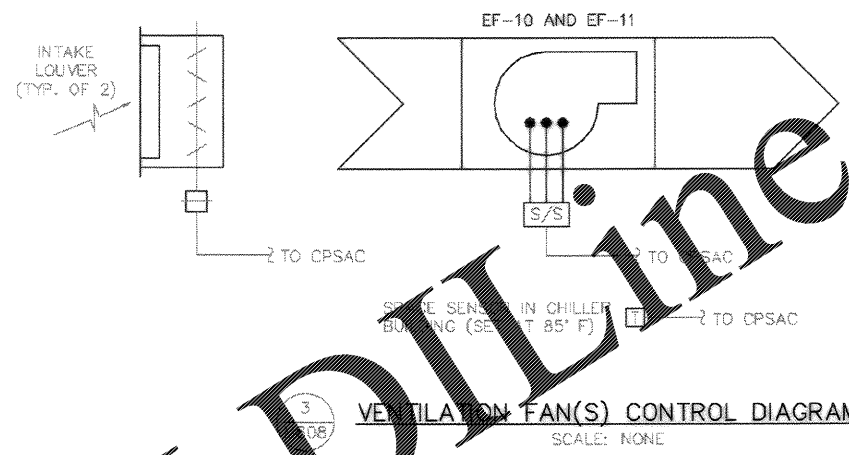

3 M608 VENTILATION FAN(S) CONTROL DIAGRAM
SCALE: NONE

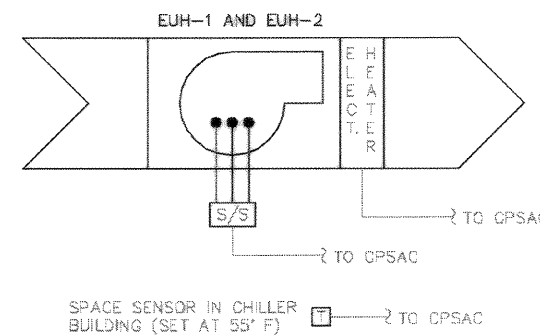

4 M608 UNIT HEATER(S) CONTROL DIAGRAM
SCALE: NONE

EPIC ENGINEERING INC. 247 Meeting Street Charleston, S.C. 29403 TEL: 843-799-1111 FAX: 843-799-1112 WWW.EPICENGINEERING.COM							
DRAWING REVISIONS Description NO. DATE BY 1 AS-BUILT REV. NO CORRECTIONS 12/14/08 MJK	PREP BY DATE APPROVAL MJK 12/14/08	CHECKED BY DATE MJK 12/14/08	DESIGNED BY DATE MJK 12/14/08	DRAWN BY DATE MJK 12/14/08	SUBMITTED BY (Firm Representative) MJK 12/14/08	APPROVED BY (Firm Representative) MJK 12/14/08	DATE 12/14/08
CHARLESTON AIR FORCE BASE CHARLESTON, SOUTH CAROLINA DINING FACILITY CONTROL DIAGRAMS - CPRC		APPROVED BY (Firm Representative) MJK 12/14/08		APPROVED BY (Firm Representative) MJK 12/14/08		APPROVED BY (Firm Representative) MJK 12/14/08	
Naval Facilities Engineering Command Southern Division Charleston, South Carolina		SOUTH CAROLINA EPIC ENGINEERING INC. NO. 000259 STATE OF SOUTH CAROLINA		SOUTH CAROLINA EPIC ENGINEERING INC. No. 2188 STATE OF SOUTH CAROLINA		RECORD DRAWING DATE 9/27/04 CODE: TEL: NCL: 80091 DRAWING SIZE: D SPEC. NO.: 06-08-0936 CONSTR. CONTR. NO.: INS-247-95-C-0939 NAVFAC DRAWING NO.: 535798B SHEET 193 OF 194 M-608	

Order Plans

WWW.LDIDLINE.COM