


- KEYNOTES**
1. INSTALL CEILING-MOUNTED, RECESSED EXHAUST FAN IN RESTROOM WITH 6" DISCHARGE UP THROUGH ATTIC SPACE TO ROOF DISCHARGE CAP - COORDINATE ROOF CAP INSTALLATION WITH BUILDING CONSTRUCTION DETAILS AND PROVIDE ROOF FLASHING AND SEALANT AS REQUIRED FOR A WEATHERPROOF INSTALLATION.
 2. INSTALL NEW ELECTRIC CEILING HEATER RECESSED INTO ATTIC AND FLUSH WITH CEILING. COORDINATE INSTALLATION LOCATION WITH TRUSS LOCATIONS AND CEILING INSTALLATION OR AS OTHERWISE DIRECTED BY ARCHITECT.

SMALL RESTROOM BLDG
MECHANICAL PLAN
M1.1 SCALE: 1/4" = 1'-0"

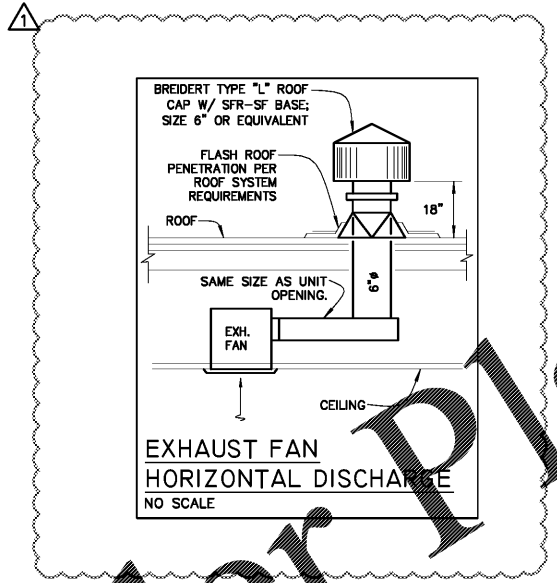

FAN SCHEDULE


ITEM	TYPE	SERVICE	CFM	ESP IN WC	DRIVE TYPE	SONES	RPM	HP	VOLT/#	MANUFACTURER AND MODEL NUMBER	NOTES
EF-1	CEILING EXHAUST	WOMEN'S TOILET ROOM	90	0.25	DIRECT	3.0	1100	98W	115/1	COOK GEMINI GC-144	1, 2, 3
EF-2	CEILING EXHAUST	MEN'S TOILET ROOM	90	0.25	DIRECT	3.0	1100	98W	115/1	COOK GEMINI GC-144	1, 2, 3

NOTES:
1. PROVIDE UNIT WITH BACKDRAFT DAMPER AND HANGING ISOLATOR KIT
2. PROVIDE UNIT WITH ROOF CAP OR OTHER APPROVED DISCHARGE HOOD
3. CONTROL FAN FROM WALL SWITCH

ELECTRIC HEATER SCHEDULE

ITEM	TYPE	KW	CFM	VOLT/#	MANUFACTURER AND MODEL NUMBER	NOTES
EH-1	CEILING-MOUNTED HTR	3	425	240/1	MARKEL H3483-TA1S	1
EH-2	CEILING-MOUNTED HTR	3	425	240/1	MARKEL H3483-TA1S	1

NOTES:
1. PROVIDE UNIT WITH THERMOSTAT, TRANSFORMER AND DISCONNECT SWITCH

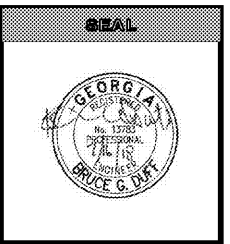

LOCATION

WINDWOOD HOLLOW PARK
RESTROOM ADDITION
4865 LAKESIDE DRIVE
DUNWOODY, GA 30360

SHEET TITLE

MECHANICAL PLAN, NOTES, SCHEDULES

DRAWN: WDG
CHECKED: BGD
SCALE: AS NOTED

DATE PRINTED
3/23/2018

REV.	DATE	REMARKS
1	07/17/18	BLDG PLAN REVIEW

SHEET NUMBER
M1.1

OF SHEETS

Order Plans

WWW.LDILine.com