



JOHNSON, LASCOBAR & ASSOCIATES, P.C.
 ARCHITECTS • ENGINEERS • INTERIORS ARCHITECTS
 135 N. LOUISVILLE ST., HARLEM, GA 30814
 TEL: (706) 724-5736 • TEL: (843) 619-4656
 FAX: (706) 724-3995
 WWW.THEJLAGROUP.COM

COLUMBIA COUNTY
 4325 EVANS TO LOOKS RD., EVANS, GA 30809
HARLEM THEATER RENOVATIONS PROJECT
 PROJECT LOCATION: 135 N LOUISVILLE ST., HARLEM, GA 30814

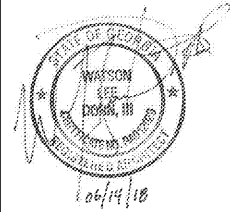


REV	DATE	BY	DESCRIPTION
2	08/20/18	WLD	COUNTY REVIEW COMMENTS
1	09/14/18	WLD	RE-ISSUE FOR CONSTRUCTION
0	05/09/18	WLD	ISSUE FOR CONSTRUCTION

PROJECT NO. 3045.1704
 DRAWN BY: CBW
 CHECKED BY: WLD
 DATE: 03/26/18
 SHEET TITLE:
DEMOLITION PLAN, PROPOSED PLAN, WALL TYPES & SECTION
 SCALE: AS NOTED
 DRAWING NO. **A-100** REV. **2**

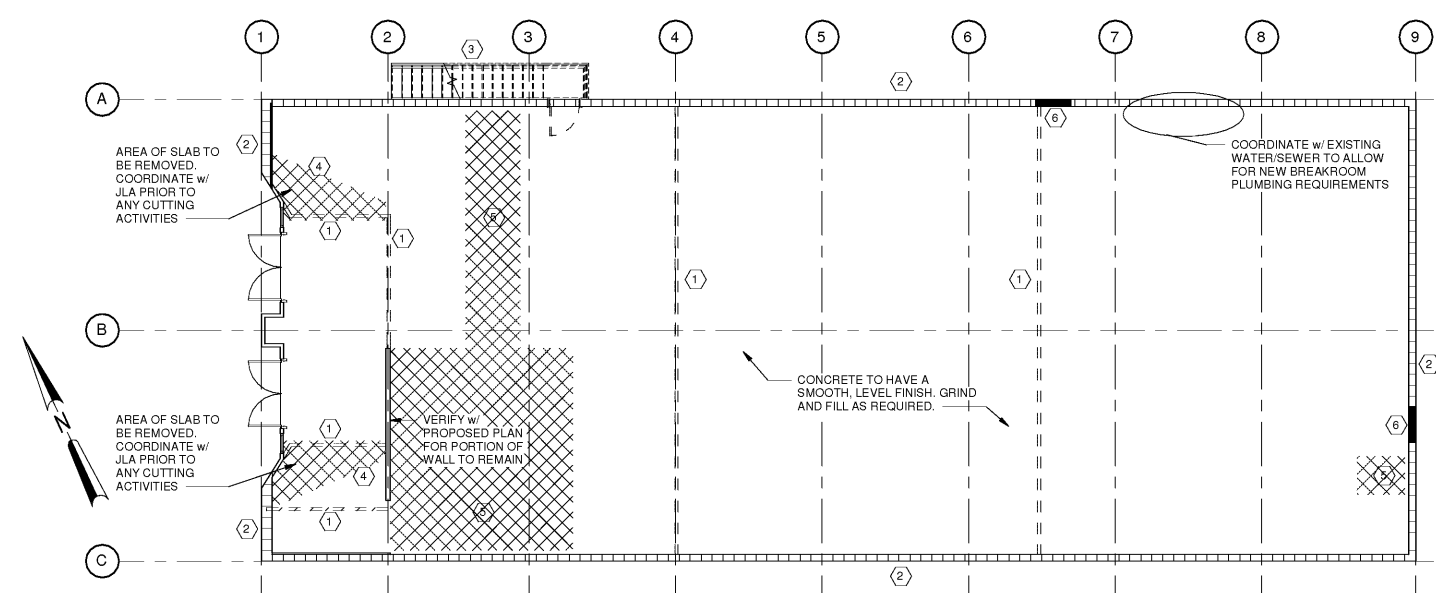



- DEMOLITION NOTES**
- REMOVE EXISTING WOOD FRAME IN IT'S ENTIRETY ONCE NEW STRUCTURAL WALL BRACING HAS BEEN INSTALLED. SEE STRUCTURAL DRAWING S101 FOR ADDITIONAL INFO.
 - REMOVE EXISTING TERRACOTTA WALL CAP AND REPLACE W/ PRESSURE TREATED 2x10 WOOD BLOCKING AND METAL WALL CAP.
 - REMOVED EXISTING STEEL STAIR, LANDING, SUPPORT STRUCTURE, DOOR AND FRAME. FILL EXISTING DOOR WITH CMU BLOCK TO MATCH EXISTING WALL THICKNESS. (APPROX. 3'-4" x 7'-4")
 - SAW CUT EXISTING CONCRETE AND REPLACE W/ SLOPED CONCRETE TO MEET ADA REQUIREMENTS. PROTECT EXISTING PAVERS DURING PROCESS TO ENSURE DAMAGE DOES NOT OCCUR. COORDINATE SAW CUTS W/ JLA PRIOR TO ANY CUTTING ACTIVITIES.
 - SAW CUT EXISTING CONCRETE FOR NEW PLUMBING AND CONDUIT. COORDINATE W/ P-101 AND E-101. REPLACE W/ NEW CONCRETE. ENSURE A LEVEL AND SMOOTH FINISH.
 - SAW CUT EXISTING CMU WALL FOR NEW HOLLOW METAL DOOR. COORDINATE W/ PROPOSED PLAN FOR LOCATION AND SIZE.

7 DEMOLITION PLAN
 A-100 SCALE: 1/8" = 1'-0"

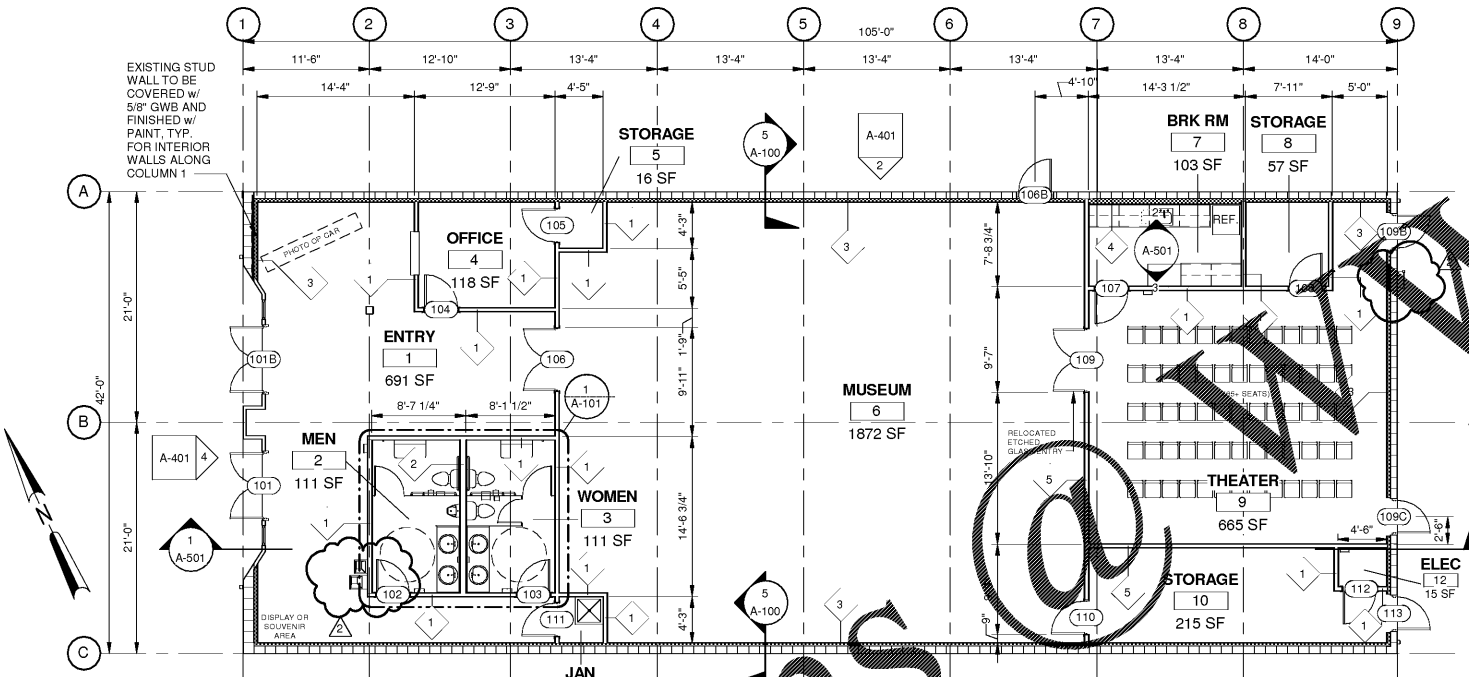


- DIMENSION NOTES**
- EXTERIOR DIMENSIONS ARE FROM FACE OF STUD/ EDGE OF SLAB TO FACE OF METAL STUD/ EDGE OF SLAB.
 - EXTERIOR DIMENSIONS ARE FROM FACE OF CMU WALL TO EDGE OF CMU WALL.
 - INTERIOR DIMENSIONS ARE FROM FACE OF STUD/ EDGE OF SLAB TO FACE OF CMU WALL.

1 PROPOSED PLAN
 A-100 SCALE: 1/8" = 1'-0"

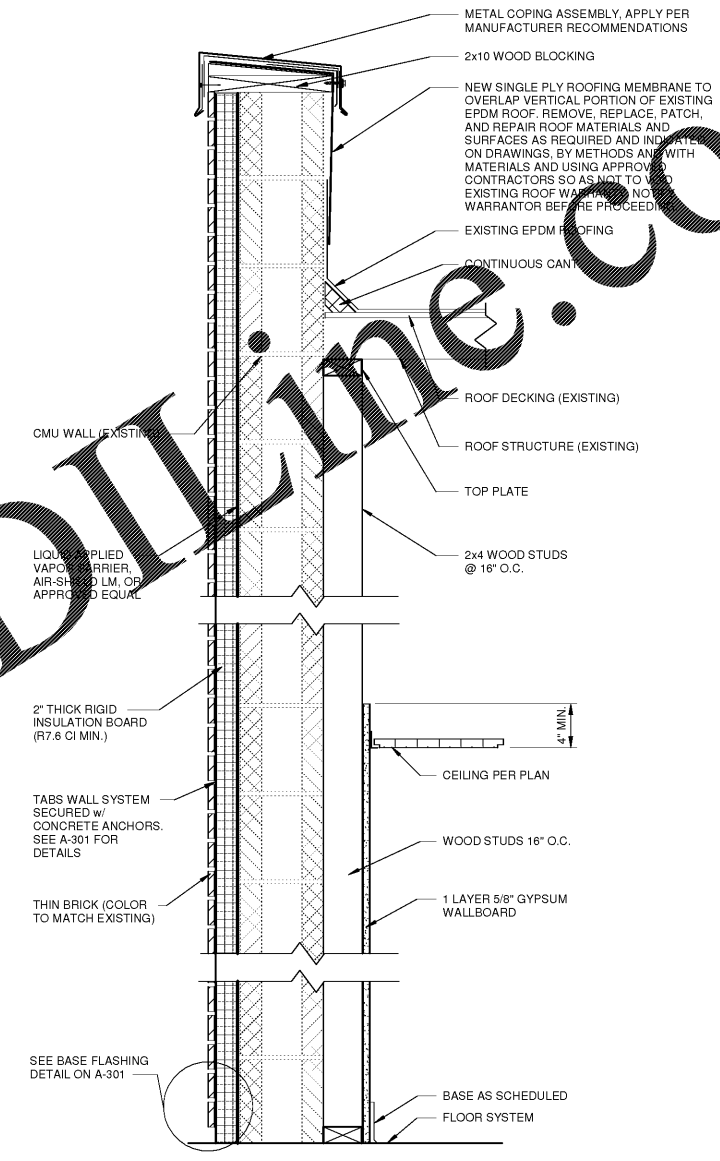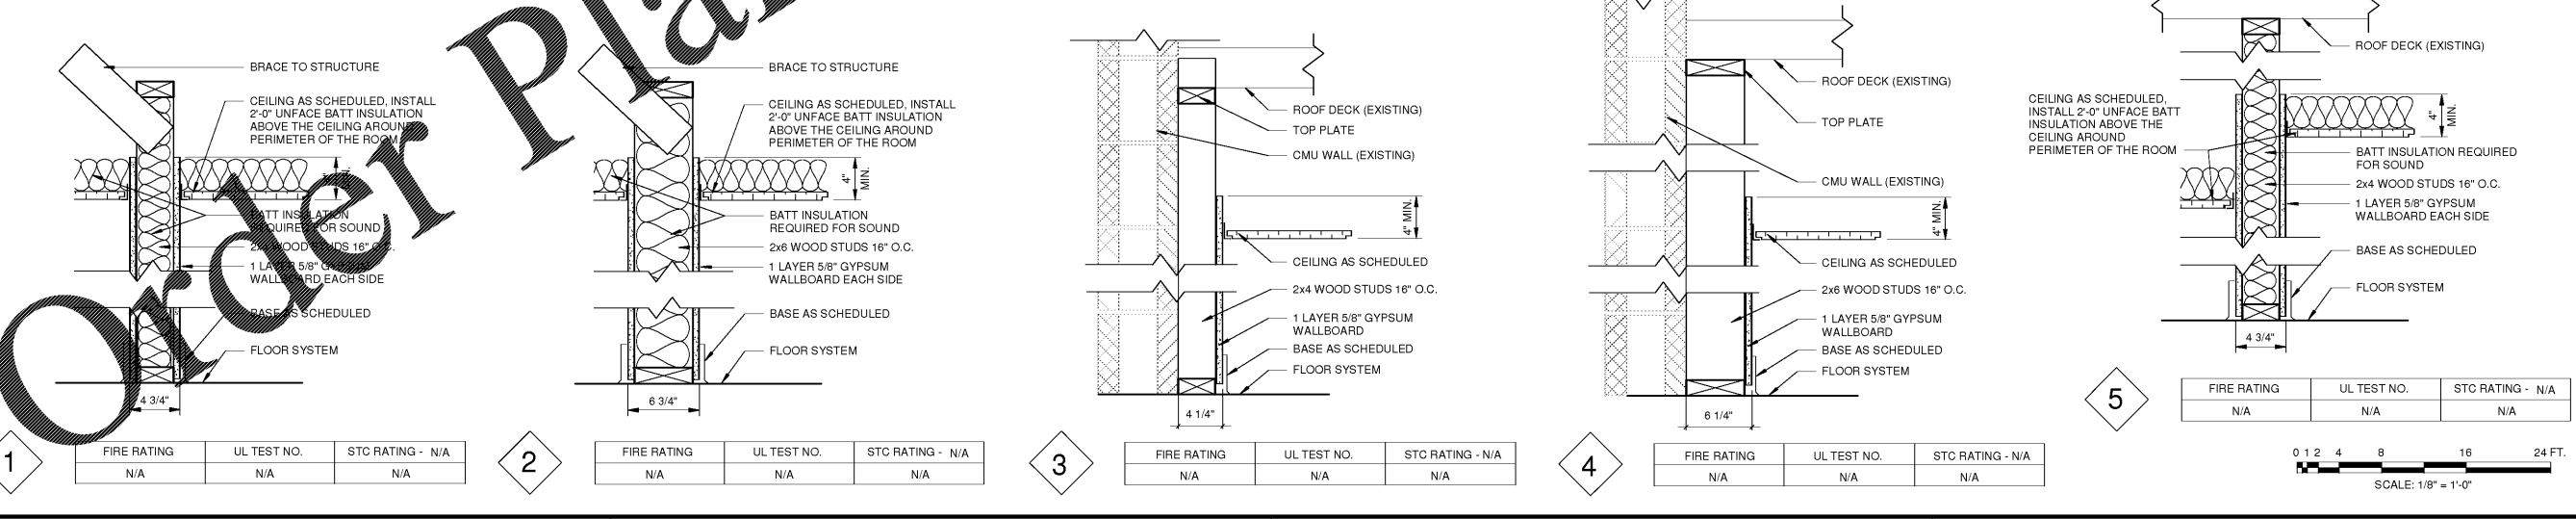

5 WALL SECTION
 A-100 SCALE: 1 1/2" = 1'-0"

1	2	3	4	5
FIRE RATING N/A	FIRE RATING N/A	FIRE RATING N/A	FIRE RATING N/A	FIRE RATING N/A
UL TEST NO. N/A	UL TEST NO. N/A	UL TEST NO. N/A	UL TEST NO. N/A	UL TEST NO. N/A
STC RATING - N/A N/A	STC RATING - N/A N/A	STC RATING - N/A N/A	STC RATING - N/A N/A	STC RATING - N/A N/A

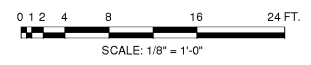

SOURCE: JLA ARCHITECTS, INC. REV. 03/26/18 DUB

This document is the property of Johnson, Lascobar & Associates, P.C. The unauthorized reproduction, copying or otherwise use of this document is strictly prohibited and any infringement thereupon may be subject to legal action.