


1 PROPOSED REFLECTED CEILING PLAN
SCALE: 1/8" = 1'-0"


NOTE:
SEE E101 FOR LIGHTING PLAN

CEILING LEGEND	
	ACOUSTICAL CEILING TILE ARMSTRONG OPTIMA SQUARE 2x2 LAY-IN CEILING PANELS w/ 15/16" PRELUDE SUSPENSION SYSTEM GRID
	HARD CEILING - PAINTED (GYP) GYPSUM BOARD PAINTED (MOISTURE RESISTIVE GYP. IN TOILET ROOMS)
	EXPOSED STRUCTURE

NOTES:
1. SEE ALL ELECTRICAL AND MECHANICAL DRAWINGS FOR ALL RELATED ITEMS.
2. SEE ELECTRICAL DRAWINGS FOR FIXTURE SCHEDULE.

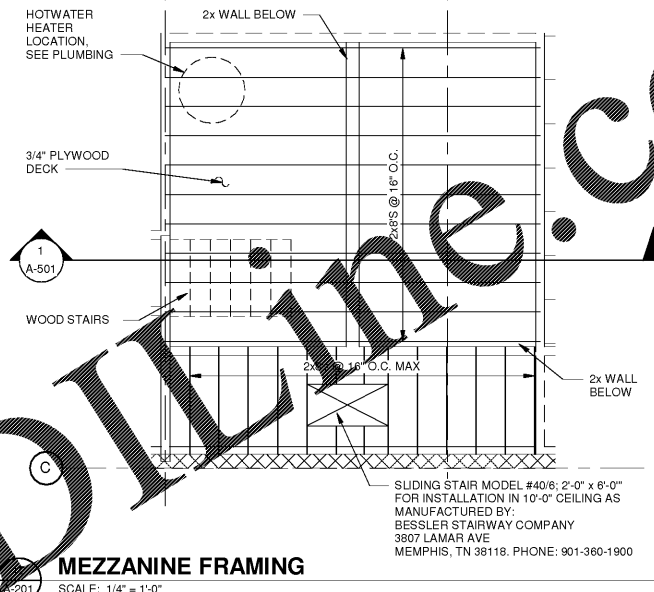


MEZZANINE FRAMING
SCALE: 1/4" = 1'-0"

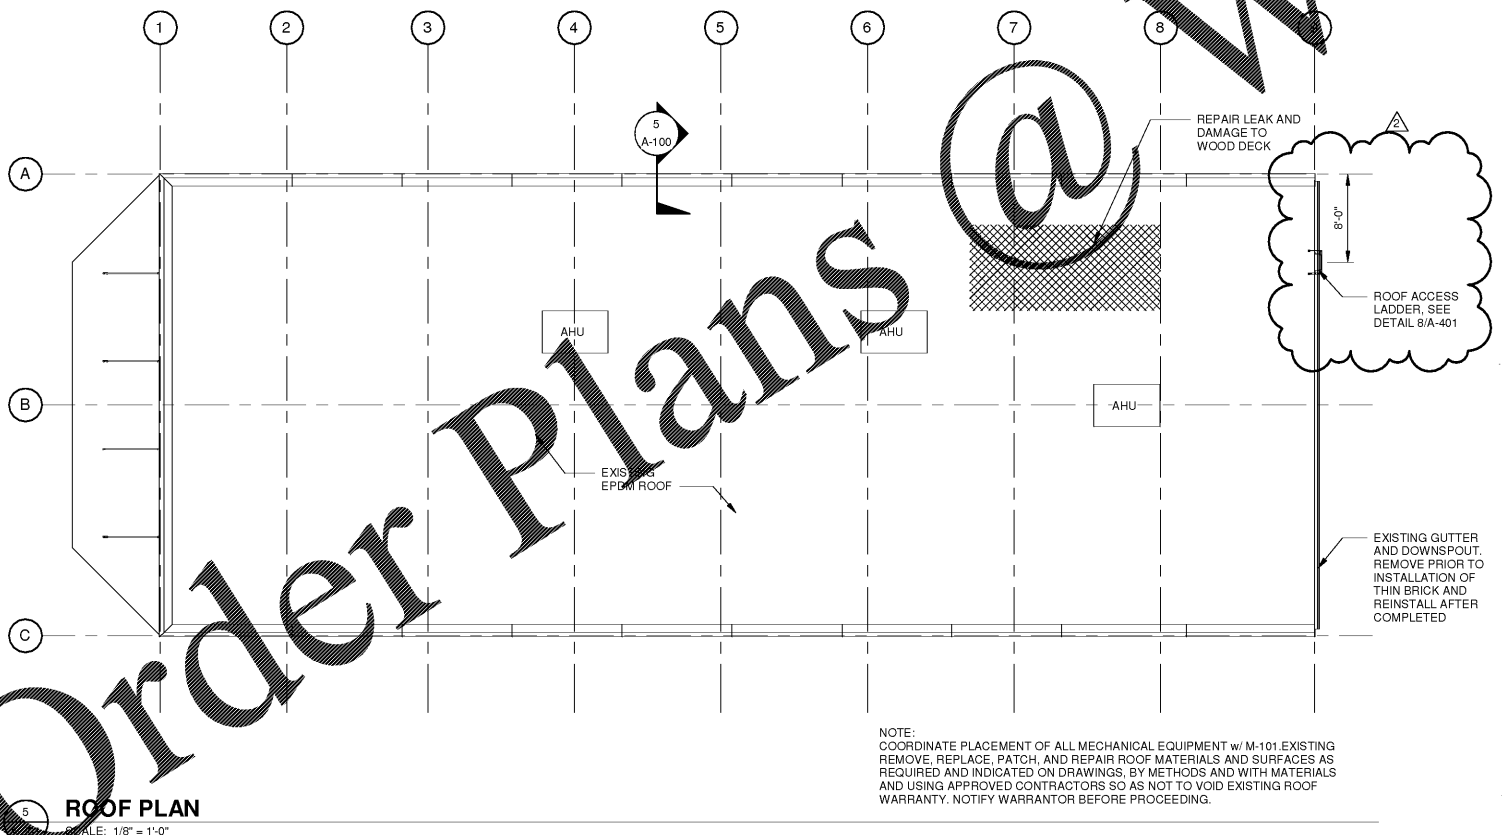


5 ROOF PLAN
SCALE: 1/8" = 1'-0"


NOTE:
COORDINATE PLACEMENT OF ALL MECHANICAL EQUIPMENT w/ M-101. EXISTING REMOVE, REPLACE, PATCH, AND REPAIR ROOF MATERIALS AND SURFACES AS REQUIRED AND INDICATED ON DRAWINGS. BY METHODS AND WITH MATERIALS AND USING APPROVED CONTRACTORS SO AS NOT TO VOID EXISTING ROOF WARRANTY. NOTIFY WARRANTOR BEFORE PROCEEDING.

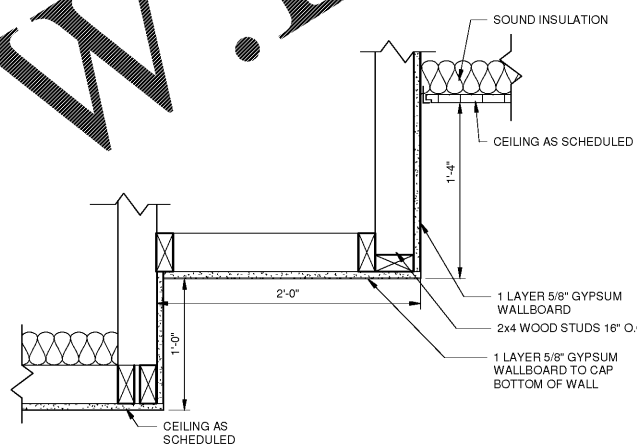

2 BULKHEAD DETAIL
SCALE: 1 1/2" = 1'-0"

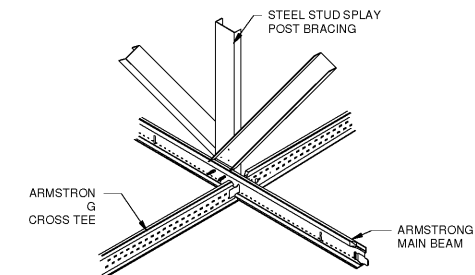


3 CEILING BRACE
SCALE: 3" = 1'-0"

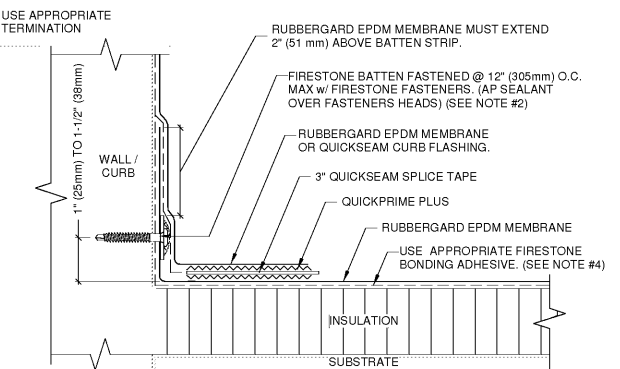

6 FIRESTONE EPDM Curb Detail
SCALE: 6" = 1'-0"


NOTES:
1. REFER TO FIRESTONE WEBSITE FOR THE MOST CURRENT INFORMATION.
2. POLYMER OR METAL BATTEN STRIP ACCEPTABLE FOR WOOD OR METAL SUBSTRATE. METAL BATTEN MUST BE USED WITH MASONRY SUBSTRATE.
3. REFER TO BT-16 & BT-17 FOR MEMBRANE SECUREMENT AT CORNERS.
4. BONDING ADHESIVE REQUIRED BETWEEN MEMBRANE AND INSULATIONS FOR FULLY ADHERED SYSTEMS.

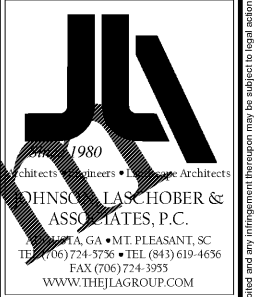

CLIENT: COLUMBIA COUNTY
4525 EVANS TO LOOKS RD., EVANS, GA 30809

PROJECT NAME: **HARLEM THEATER RENOVATIONS PROJECT**

PROJECT LOCATION: 135 N LOUISVILLE ST., HARLEM, GA 30814

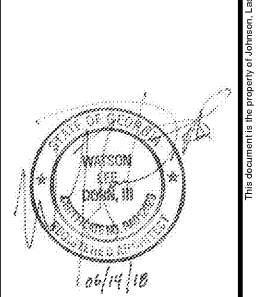

REV	DATE	BY	DESCRIPTION
2	08/20/18	WLD	COUNTY REVIEW COMMENTS
1	05/14/18	WLD	RE-ISSUE FOR CONSTRUCTION
0	05/09/18	WLD	ISSUE FOR CONSTRUCTION

PROJECT NO. 3045.1704
DRAWN BY: CBW
CHECKED BY: WLD
DATE: 03/26/18

SHEET TITLE:
**REFLECTED CEILING PLAN/
ROOF PLAN**

SCALE AS NOTED
DRAWING NO. **A-201** REV. **2**

Order Plans @ WWW.LDILLINE.COM

WWW.LDILLINE.COM