


WASTE PIPING NOTES:

- ① - 4" GCO
- ② - 4" FCO
- ③ - 2" FCO
- ④ - 2" FLOOR DRAIN IN MEZZANINE FLOOR w/ PROSET TRAP GUARD
- ⑤ - 2" W DOWN / 2" V UP
- ⑥ - 2" GCO

NOTES:
 1. SEE PLUMBING FIXTURE SCHEDULE FOR INDIVIDUAL FIXTURE RUN-OUT SIZES.
 2. PLUMBING CONTRACTOR SHALL COORDINATE UNDERGROUND PIPING WITH STRUCTURAL COLUMN AND FOOTING LOCATIONS. REROUTE PIPING AS NECESSARY TO AVOID INTERFERENCES.

1 WASTE PIPING PLAN
 P-101 SCALE: 1/8" = 1'-0"

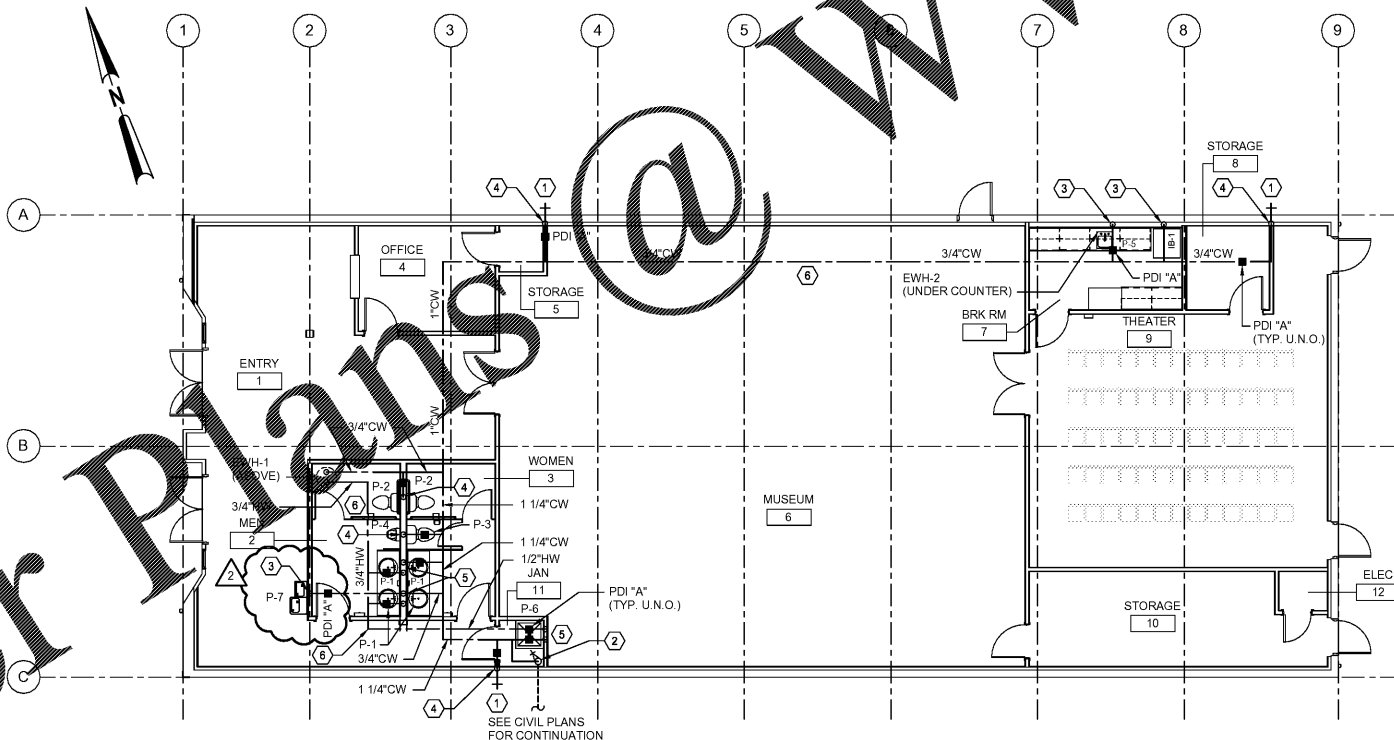

POTABLE WATER PIPING NOTES:

- ① - 3/4" WH
- ② - 1 1/4" WATER UP THRU SLAB w/ SLEEVE. (COORDINATE w/ GENERAL CONTRACTOR) PROVIDE SHUT-OFF VALVE (PROVIDE P.R.V. IF WATER PRESSURE > 80 psi. PLUMBING CONTRACTOR TO VERIFY WATER PRESSURE IN THE FIELD.)
- ③ - 1/2" CW DOWN
- ④ - 3/4" CW DOWN
- ⑤ - 1/2" CW & HW DOWN
- ⑥ - POTABLE WATER PIPING IS LOCATED IN THE CEILING SPACE. (TYP. U.N.O.)

NOTE:
 SEE PLUMBING FIXTURE SCHEDULE FOR INDIVIDUAL FIXTURE RUN-OUT SIZES.

2 POTABLE WATER PIPING PLAN
 P-101 SCALE: 1/8" = 1'-0"



CLIENT: COLUMBIA COUNTY
 4325 EVANS TO LOCKS RD., EVANS, GA 30809
 PROJECT NAME: HARLEM THEATER RENOVATIONS PROJECT
 PROJECT LOCATION: 135 N. LOUISVILLE ST., HARLEM, GA 30814




REV	DATE	BY	DESCRIPTION
2	08/20/18	CW	COUNTY REVIEW COMMENTS
1	08/14/18	CW	REISSUE FOR CONSTRUCTION
0	05/09/18	CW	ISSUED FOR CONSTRUCTION

PROJECT NO. 3045.1704
 DRAWN BY: WBR
 CHECKED BY: CVW
 DATE: 03/26/18

PLUMBING PLANS

SCALE: 1/8" = 1'-0"
 DRAWING NO. **P-101** REV. **2**

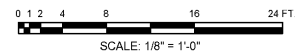

Order Plans @ www.LDILine.com

www.LDILine.com

This document is the property of Johnson, Laschober & Associates, P.C. The unauthorized reproduction, copying or otherwise use of this document is strictly prohibited and any infringement thereupon may be subject to legal action.