


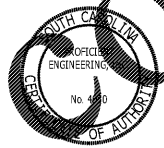
E
D
C
B
A

- KEYNOTES
- 1 PROVIDE FULL SIZE 4" WALL CLEANOUT OFF OF WATER CLOSET WASTE BRANCH TO FACILITATE SNAKING OUT OF SANITARY SEWER FROM WATER CLOSET TO SANITARY MAIN. CONTRACTOR TO ENSURE CLEAR ACCESS FOR SERVICING.
 - 2 3" V UP TO 3" VTR
 - 3 CONNECT NEW 4" SANITARY LINE TO EXISTING SANITARY STUB NEAR SPACE. FIELD VERIFY EXACT SIZE, LOCATION AND INVERT ELEVATION WITH CIVIL SITE UTILITY DRAWINGS PRIOR TO BIDDING. REFER TO RISER DIAGRAM AND PLUMBING SPECIFICATIONS FOR ADDITIONAL INFORMATION.
 - 4 1" DOMESTIC WATER SERVICE UP FROM BELOW GRADE. SEE CIVIL SITE UTILITY DRAWINGS FOR ADDITIONAL INFORMATION. VERIFY EXACT SIZE AND LOCATION. SEE P-4 FOR CONTINUATION.
 - 5 PROVIDE TRENCH DRAIN AND COLLECTION BOX ALONG FRONT OF SERVICE BAYS. SEE PLUMBING FIXTURE SCHEDULE FOR ADDITIONAL INFORMATION. EXTEND DRAIN TO OIL SEPARATOR, MAINTAINING A MINIMUM SLOPE OF 1/8"/FT. COORDINATE EXACT LOCATION, ROUTING AND INVERT ELEVATION WITH CIVIL SITE UTILITY DRAWINGS.
 - 6 4" O/W B/G TO 1500 GALLON PRECAST CONCRETE GREASE INTERCEPTOR (SEE CIVIL SITE UTILITY DRAWINGS FOR CONT).
 - 7 3" V B/G TO 1500 GALLON PRECAST CONCRETE GREASE INTERCEPTOR (SEE CIVIL SITE UTILITY DRAWINGS FOR CONT).
 - 8 PROVIDE 3" VENT SERVING OIL SEPARATOR. EXTEND UP IN WALL TO BELOW ROOF. OFFSET TO NEW 3" VTR. COORDINATE EXACT LOCATION TO MAINTAIN A MINIMUM OF 10' SEPARATION FROM AIR INTAKES. COORDINATE ALL ROOF PENETRATIONS WITH LANDLORD APPROVED ROOFING CONTRACTOR.
 - 9 PROVIDE NEW VENT THRU ROOF IN LOCATION INDICATED. SEE PLAN FOR SIZE. COORDINATE EXACT LOCATION TO MAINTAIN A MINIMUM OF 10' SEPARATION FROM AIR INTAKES. COORDINATE ALL ROOF PENETRATIONS WITH LANDLORD APPROVED ROOFING CONTRACTOR.
 - 10 PIPE CONDENSATE FROM AIR COMPRESSOR TO FLOOR DRAIN, TERMINATE WITH AIR GAP PER LOCAL CODE. FIELD VERIFY CONNECTION TO EQUIPMENT. TYPICAL

CONSULTANT:



PROFICIENT ENGINEERING
6991 Peachtree Industrial Blvd Building 700
Peachtree Corners, Georgia 30092
404.330.9798
PROJECT #118468




ROBERT C. NATSHIN, AIA
ARCHITECT
2265 ROSWELL ROAD
SUITE 100
MARIETTA, GEORGIA 30062
770-509-4894 TELEPHONE
770-509-2207 FACSIMILE

CLIENT:




TBC CORPORATION
430 TBC WAY
PALM BEACH GARDENS
FLORIDA 33410

PROJECT INFORMATION:



NTRB
TIRE & SERVICE CENTERS
GREER, SOUTH CAROLINA

SEAL:




KEVIN P. KEVING
No. 27477

PROJECT NO.:	20150211
DRAWN BY:	DB
CHECKED BY:	FK
ISSUE:	DATE:
ISSUED FOR PERMIT:	10/14/2015

REVISION	DATE
1 PLAN REVIEW CORRECTIONS	11/2/15
2 DRAWING UPDATE	11/16/15

SHEET TITLE:
FLOOR PLAN - WASTE & VENT

SHEET NUMBER:
P-3

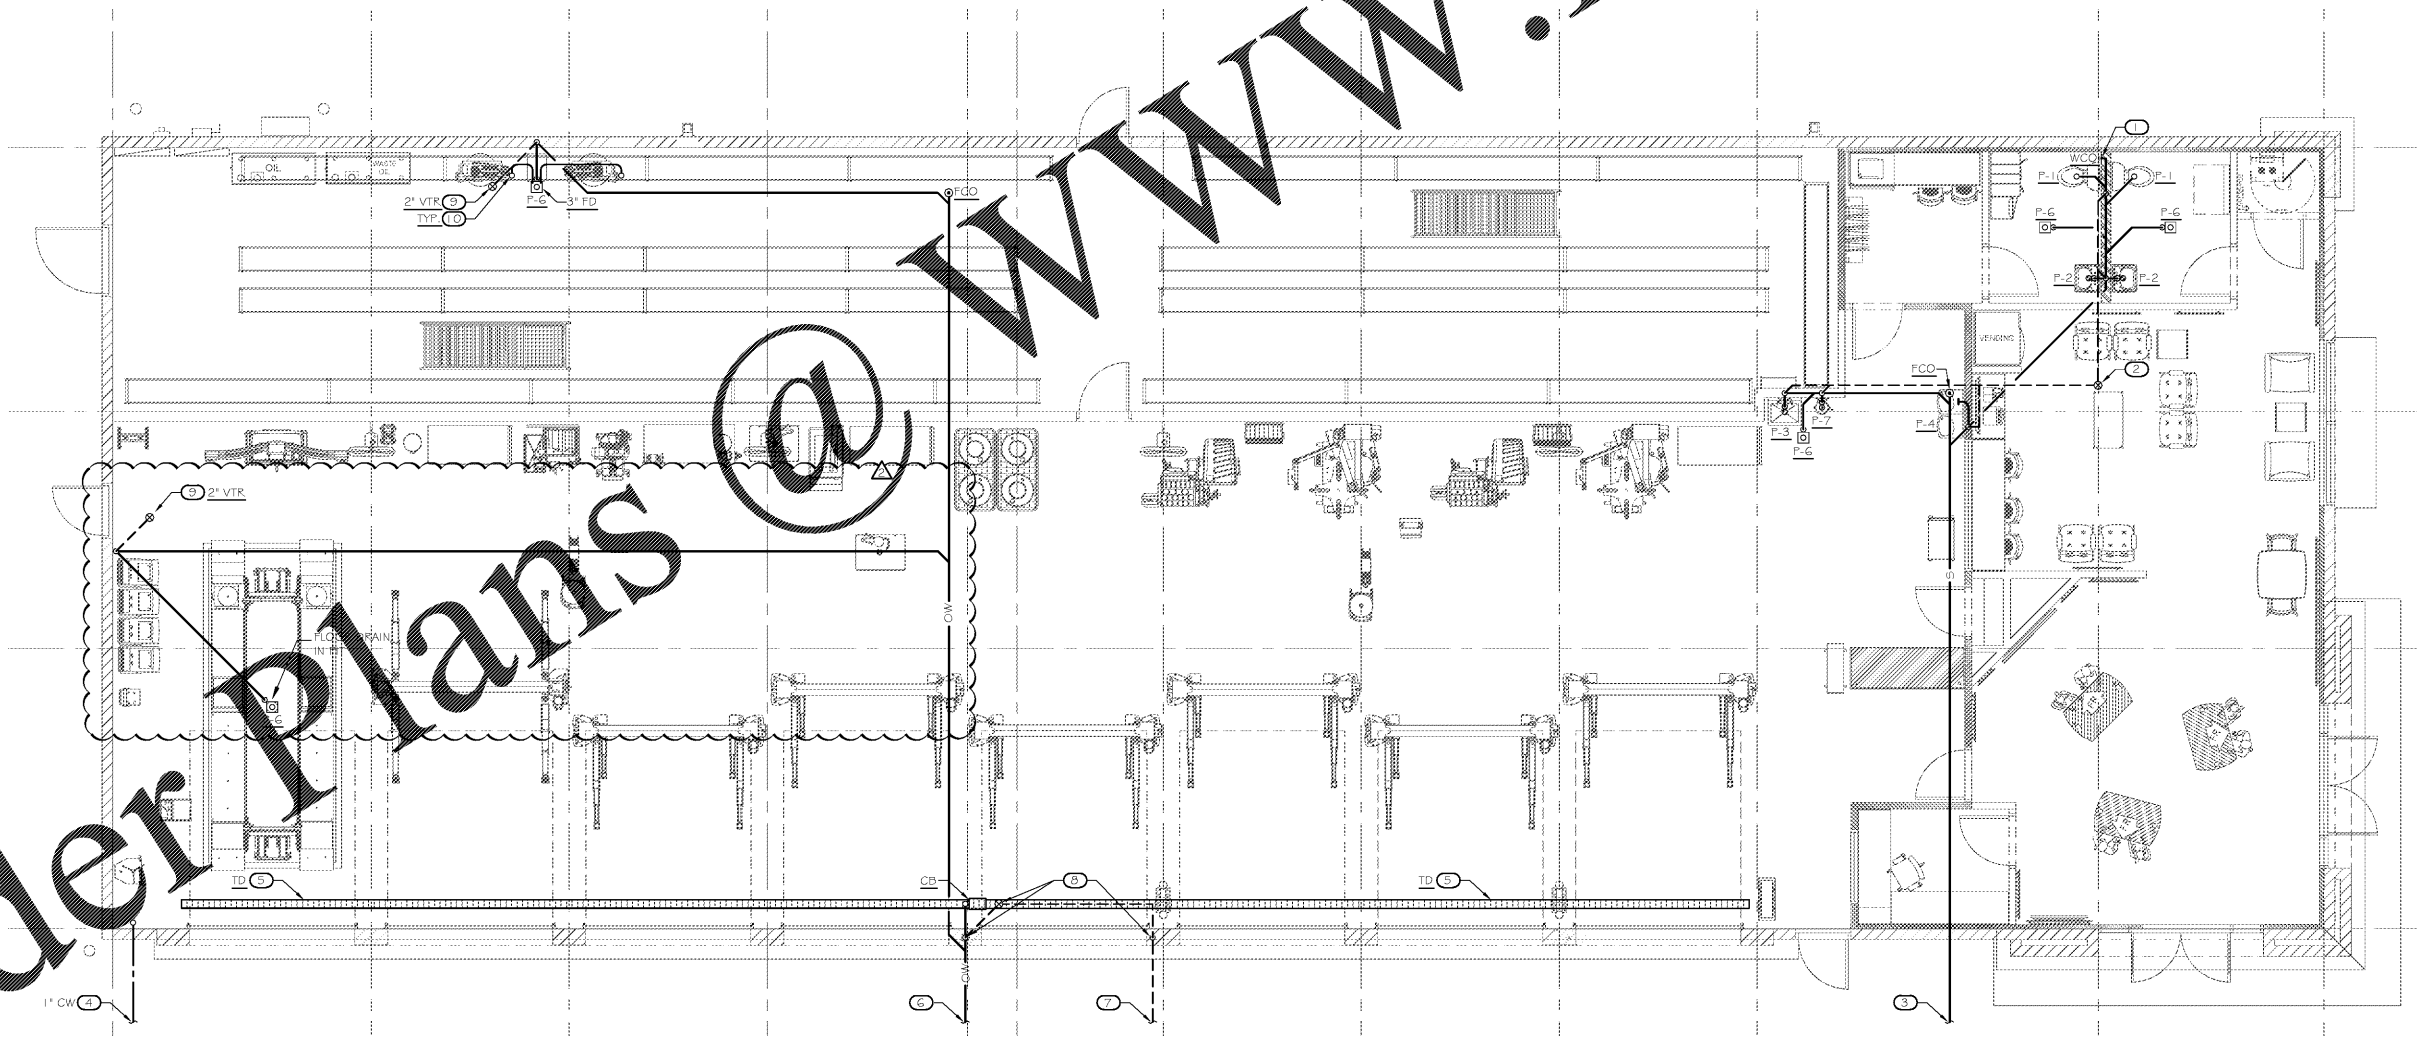

1 FLOOR PLAN - WASTE & VENT
3/16" = 1'-0"

Order Plans @ www.LDILine.com