

E
D
C
B
A

PROFICIENT
ENGINEERING
6991 Peachtree Industrial Blvd Building 700
Peachtree Corners, Georgia 30092
404.330.9798
PROJECT # 118468



CONSULTANT:
ROBERT C. NAYSHIN, AIA
ARCHITECT
2265 ROSWELL ROAD
SUITE 100
MARIETTA, GEORGIA 30062
770-509-4894 TELEPHONE
770-509-2207 FACSIMILE



430 TBC WAY
PALM BEACH GARDENS
FLORIDA 33410

PROJECT INFORMATION:

NTTB
TIRE SERVICE CENTERS
GREER, SOUTH CAROLINA

SEAL:



PROJECT NO.: 20150211
DRAWN BY: DB
CHECKED BY: FK

ISSUE: DATE:
ISSUED FOR PERMIT 10/10/2015


REVISION: DATE:
1 PLAN REVIEW COMPLETE 11/2/15
2 DRAWING UPDATE 11/16/15

SHEET TITLE:


RISER DIAGRAMS

SHEET NUMBER:

P-5

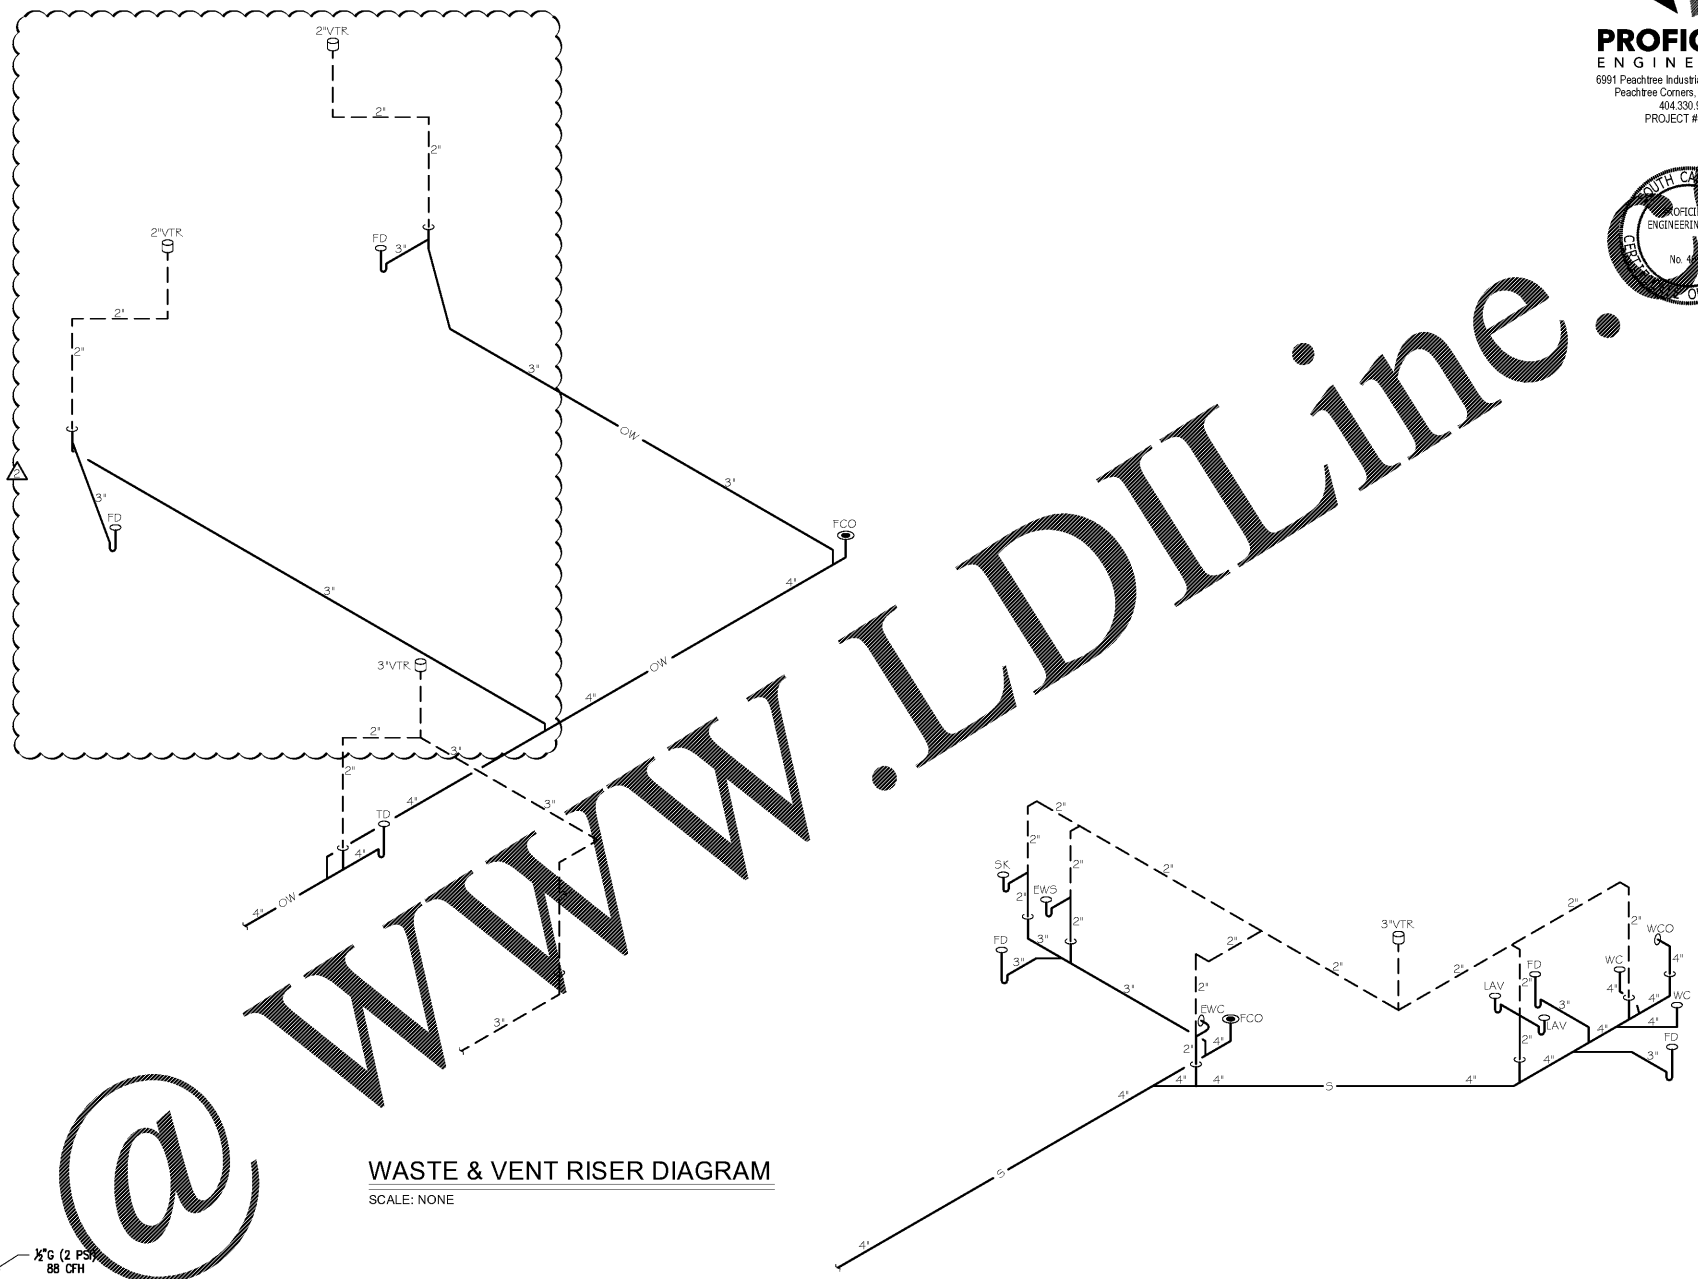

WASTE & VENT RISER DIAGRAM
SCALE: NONE

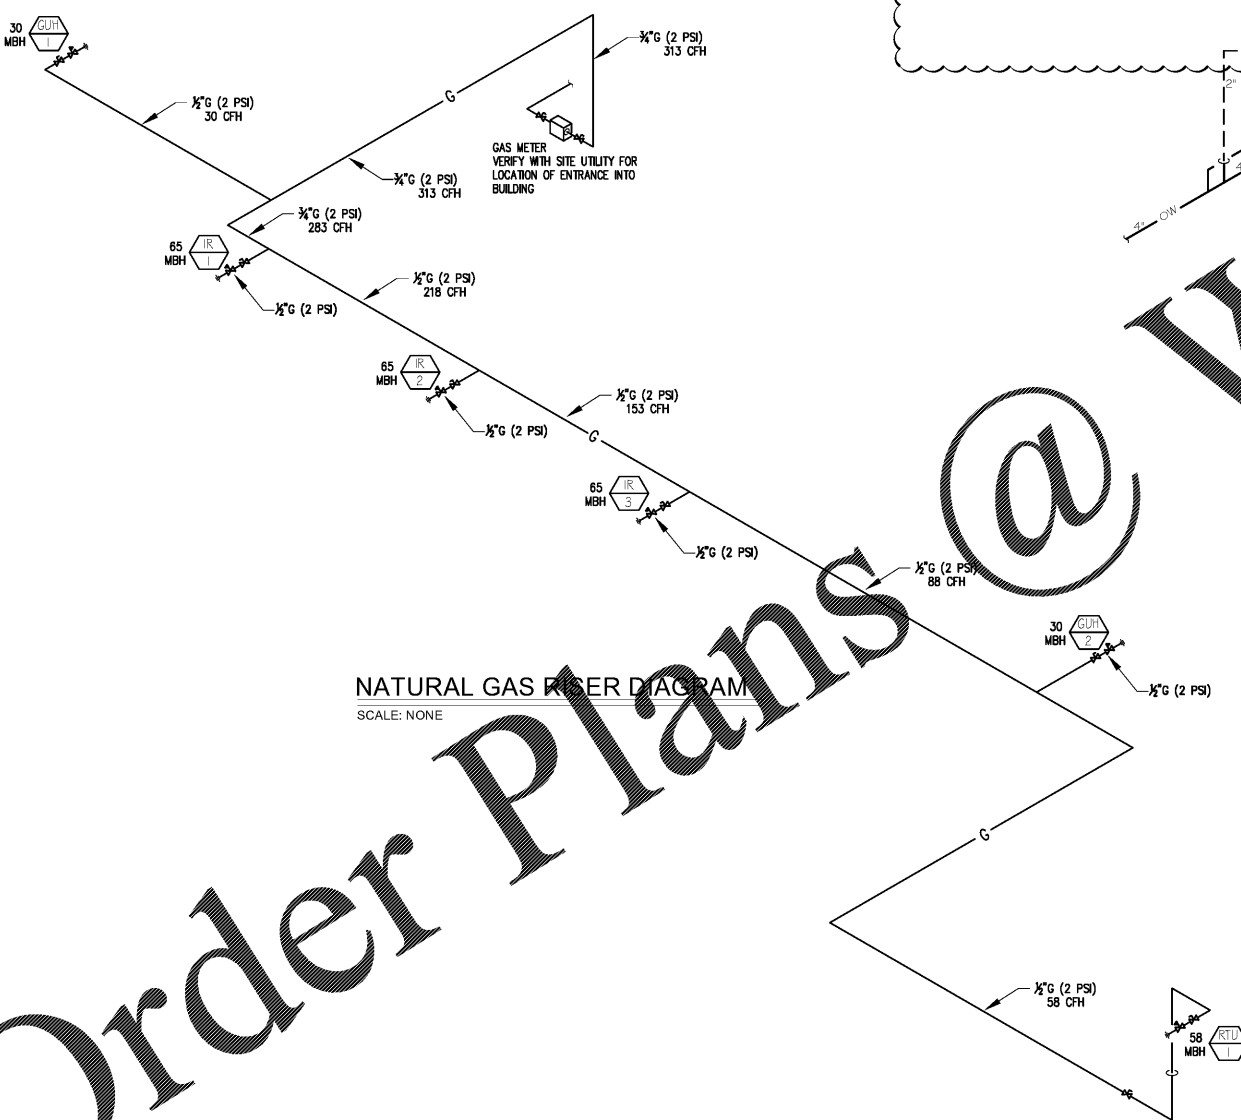

NATURAL GAS RISER DIAGRAM
SCALE: NONE

Order Plans @ WWW.LDILine.com

6 5 4 3 2 1

© COPYRIGHT MICHAEL J. WILKUS, ARCHITECT