


INTERIOR FINISH LEGEND

WALL FINISHES						
ABBREVIATIONS	DESCRIPTION	MANUFACTURER	MODEL NUMBER	COLOR	STYLE	REMARKS
P1	PAINT	SHERWIN WILLIAMS	SW 7014	EIDER WHITE	PRO INDUSTRIAL ACRYLIC	(SEE INTERIOR FINISH PLAN) - EGG SHELL FINISH
P2	PAINT	SHERWIN WILLIAMS	SW 6227	MEDITATIVE	PRO INDUSTRIAL ACRYLIC	ACCENT WALLS (SEE INTERIOR FINISH PLAN) - EGG SHELL FINISH
WC1	WALL COVERING	WOLF GORDON	Y46846CP	CANOPY WINTERWORLD		54" WIDE WITH OSNABURG BACKING; REVERSE HANG WITH RANDOM MATCH; ACCENT WALL BEHIND RECEPTION COUNTER. REPRESENTATIVE - CATHY DY (310)770-1165
CT3	WALL CERAMIC TILE	EMSER	P20SPECAC1224	ACAMAR	12" x 24"	MAPEI MAPELASTIC HPG WATERPROOFING AND CRACK-ISOLATION MEMBRANE, RESTROOMS AND POD ROOMS; INSTALLED WITH RUNNING BOND; GROUT TO BE CBP PRISM GROUT #11 POLYBLEND NON-SAND SNOW WHITE FOR PINWHEEL (44s.L.) WITH 1/8" THICK GROUT JOINT (ALIGN WITH FLOOR GROUT)
CT4	WALL CERAMIC TILE	EMSER TILE	MARBLE SERIES PINWHEEL	BIANCA GIOIA & SILVER MARBLE PINWHEEL	12" x 12" MESH MOUNT	MAPEI MAPELASTIC HPG WATERPROOFING AND CRACK-ISOLATION MEMBRANE, POD ROOMS AT SHOWER LOCATIONS; MESH MOUNT; GROUT TO BE CBP PRISM GROUT #11 SHOW WHITE WITH 1/8" GROUT LINES. REPRESENTATIVE - KYLEE MIDURA (858)740-7681
CT5	WALL CERAMIC TILE ACCENT	EMSER	RAINDROP CLASSIC MOSAIC RAINDR0612	GRIS ET BLANC RAIN	6" x 12"	MAPEI MAPELASTIC HPG WATERPROOFING AND CRACK-ISOLATION MEMBRANE, POD ROOM ACCENT WALLS; MESH MOUNT; GROUT TO BE CBP PRISM GROUT #11 SHOW WHITE WITH 1/8" GROUT LINES. REPRESENTATIVE - WILLOW DECKER (858)780-6635
FRP	FIBER REINFORCED PLASTIC					SEE WALL ELEVATIONS IN BACK OF HOUSE AREA
SCH1	TRIM STRIP	SCHULTER				SEE WALL ELEVATIONS IN POD ROOMS

CEILING FINISHES						
ABBREVIATIONS	DESCRIPTION	MANUFACTURER	MODEL NUMBER	COLOR	STYLE	REMARKS
C1	ACCOUSTICAL CEILING TILE	ARMSTRONG	DUNE	WHITE	SECOND LOOK II	ALL AREAS EXCEPT POD ROOMS - INSTALL CHICAGO METALLIC SNAP GRID 200 (2'-0" x 2'-0") CEILING GRID WITH 12 GA. SUSPENSION WIRES
C2	ACCOUSTICAL CEILING TILE	USG	CLIMA PLUS	WHITE	VINYL WRAPPED GYPSUM BOARD	POD ROOM AREAS ONLY - INSTALL CHICAGO METALLIC SNAP GRID 200 (2'-0" x 2'-0") CEILING GRID WITH 12 GA. SUSPENSION WIRES (WASHABLE VINYL FACE CEILING PANELS)

FLOOR FINISHES						
ABBREVIATIONS	DESCRIPTION	MANUFACTURER	MODEL NUMBER	COLOR	STYLE	REMARKS
LVT	LUXURY VINYL TILE	PHILADELPHIA COMMERCIAL	CONNECTION 6" 5424V	PARTNERSHIP 02150	6" x 36" PLANK	LOBBY & VIDEO ROOM. RUN LONG DIM. OF PATTERN EAST/WEST.
CT1	CERAMIC TILE	EMSER	P20SPECAC1224	ACAMAR	12" x 24"	POD ROOMS; INSTALLED WITH RUNNING BOND; GROUT TO BE w/ CEG COLORANT #165 DELOREAN GRAY (2 PER 2 Gal.) WITH 1/8" THICK GROUT JOINT.
CT2	CERAMIC TILE	EMSER TILE	RIVER PEBBLE ZUNI	TRUE REST	12" x 12" MESH MOUNT	POD ROOMS AT SHOWER LOCATIONS; INSTALLED AS MOSAIC; GROUT TO BE CBP PRISM #165 DELOREAN GRAY WITH 3/16" THICK GROUT JOINT. REPRESENTATIVE - KYLEE MIDURA: (858)740-7681
CT6	CERAMIC TILE	EMSER TILE	MOKUZAI GURE	TRUE REST	8" x 39"	CORRIDOR, INSTALLED WITH RUNNING BOND; RUN LONG DIM. OF PATTERN EAST/WEST.
VB	VINYL BASE	JOHNSONITE	TRADITIONAL WALL BASE	TOAST 283	COVE BASE WITH TOE	4" TALL COVE BASE
CT8	CERAMIC TILE BASE					4" TALL CERAMIC TILE BASE

ROOM FINISH SCHEDULE													
NO.	ROOM NAME	BASE	FLOOR	NORTH WALL	EAST WALL	SOUTH WALL	WEST WALL	CEILING	CEILING HEIGHT	REMARKS	NO.		
		MATERIAL	MATERIAL	MATERIAL	COLOR	MATERIAL	COLOR	MATERIAL				COLOR	MATERIAL
101	LOBBY	4" VINYL COVE	WALL TILE - WAINSCOT	CERAMIC TILE	LUXURY VINYL TILE	STAINED CONCRETE	GYPSUM BOARD PAINTED	CT-3, CT-4, CT-5, SCH1, P1	10'-0"		101		
102	VIDEO ROOM							CT-3, CT-4, CT-5, SCH1, P1	9'-0"		102		
103	CORRIDOR							CT-3, CT-4, CT-5, SCH1, P1	9'-0"		103		
104	POD ROOM 1							CT-3, CT-4, CT-5, SCH1, P1	9'-0"	See Interior Wall Elevations	104		
105	POD ROOM 2							CT-3, CT-4, CT-5, SCH1, P1	9'-0"	See Interior Wall Elevations	105		
106	POD ROOM 3 / ADA							CT-3, CT-4, CT-5, SCH1, P1	9'-0"	See Interior Wall Elevations	106		
107	JANITOR'S CLOSET							CT-3, CT-4, CT-5, SCH1, P1	9'-0"		107		

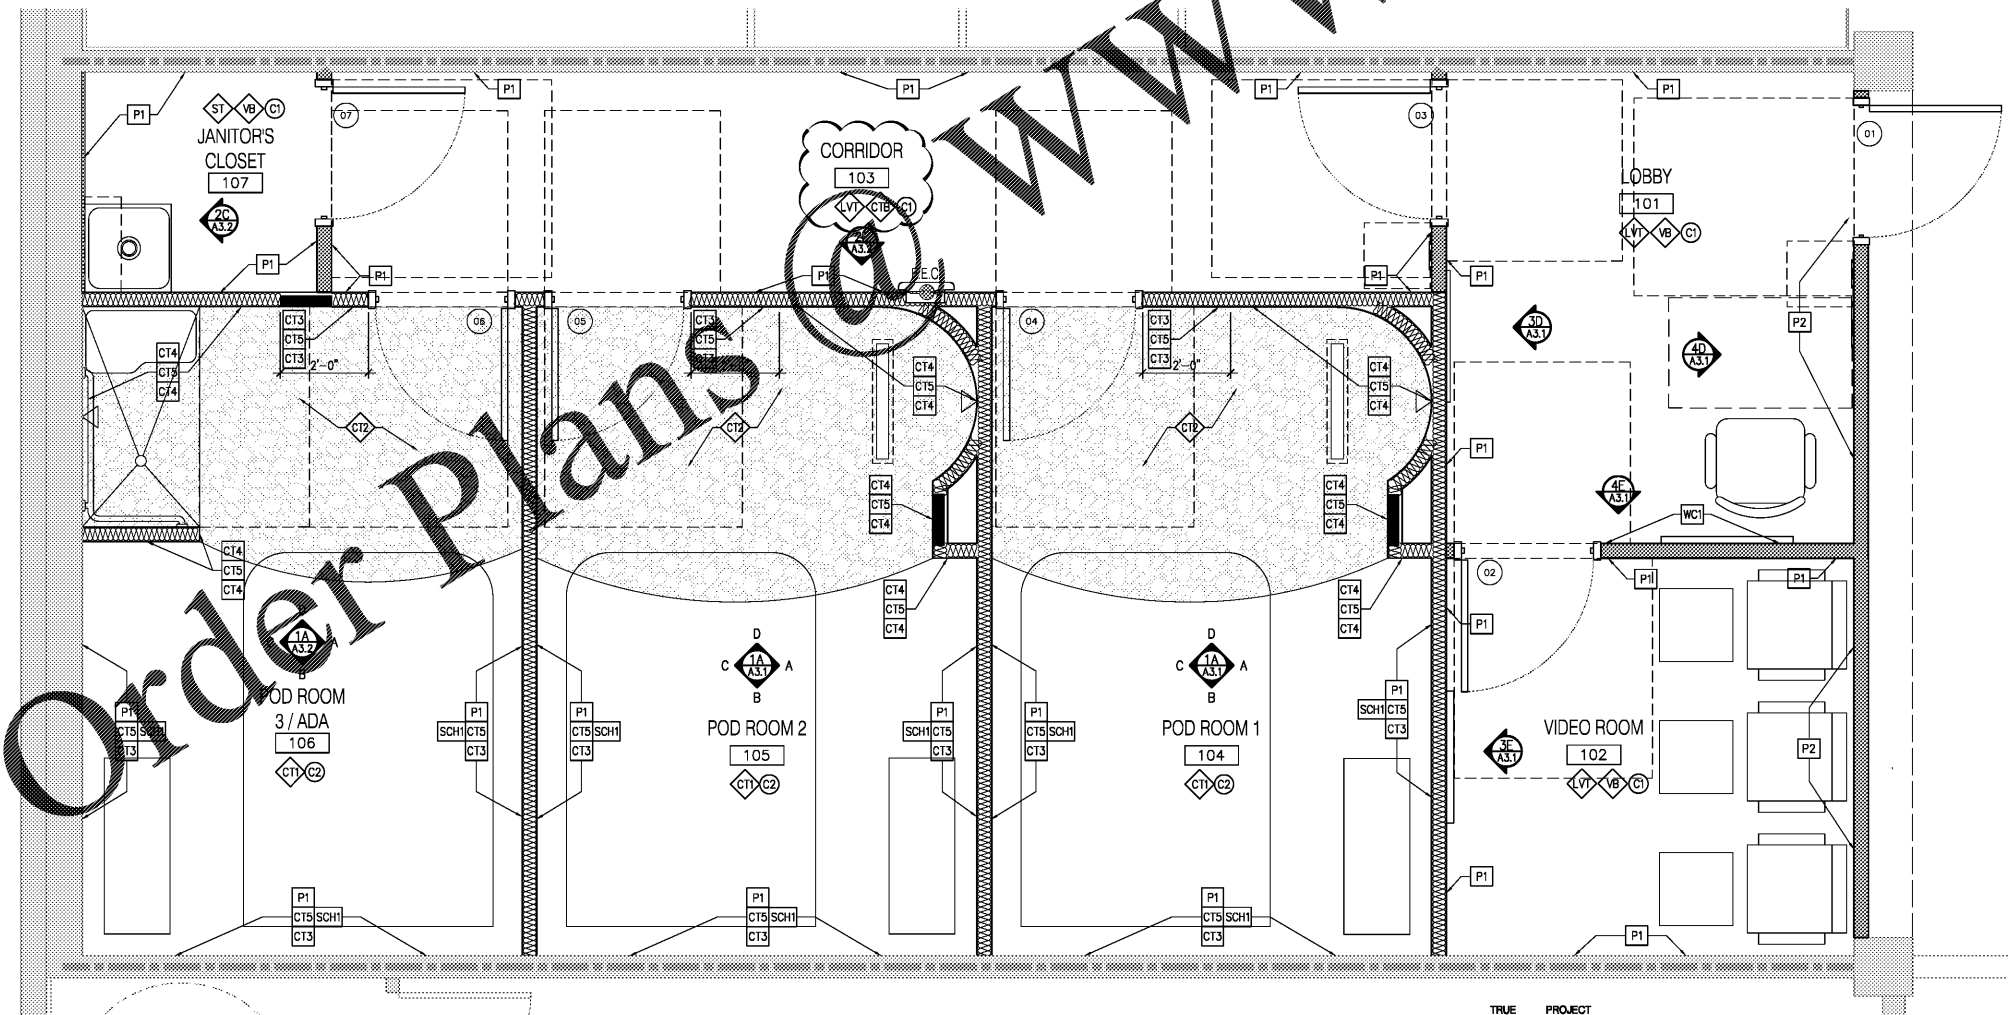

INTERIOR FINISH PLAN
Scale: 1/2" = 1'-0"

- ROOM FINISH NOTES**
- P1. PAINT ALL SIDES OF DOOR FRAMES.
 - ALL GYPSUM BOARD SHALL BE 5/8" TYPE X, UNLESS OTHERWISE NOTED.
 - GYPSUM BOARD IN ALL WET AREAS (PREP AREAS AND RESTROOMS) SHALL BE MOISTURE RESISTANT.
 - ALL WOOD DOORS SHALL RECEIVE MINIMUM (2) COATS POLYURETHANE FINISH.
 - PROVIDE AND INSTALL PICTORIAL SYMBOL RESTROOM SIGNAGE AT ALL RESTROOMS INCLUDING HANDICAPPED SYMBOL.
 - PROVIDE AND INSTALL TRANSITION STRIP(S) AS REQUIRED OR AS INDICATED ON PLAN.
 - ALL INTERIOR FINISHES SHALL BE CLASS C OR BETTER (FLAME SPREAD 76-200). FINISHES IN EXIT CORRIDORS AND ENTRY SHALL BE CLASS B OR BETTER (FLAME SPREAD 26-75). ALL INTERIOR FINISH MATERIAL SHALL HAVE A SMOKE DEVELOPMENT RATING OF 450 OR LESS.
 - THE GENERAL CONTRACTOR SHALL COORDINATE ALL INTERIOR FINISH COLORS WITH FINISH SCHEDULE AND OWNER.
 - PAINT SHALL BE EQUAL TO - (1) PRIMER COAT, (2) COATS LATEX SATIN.
 - PAINT IN WET AREAS (PREP AREA AND RESTROOMS) SHALL BE EPOXY.
 - ALL CEILINGS TO BE 9'-0" A.F.F. UNLESS NOTED OTHERWISE (10'-0" IN LOBBY).
 - FIRE EXTINGUISHERS SHALL BE A MINIMUM OF 5 LB. 2A-10BC UL APPROVED PORTABLE FIRE EXTINGUISHER. INSTALL SO THAT ITS TOP IS NOT MORE THAN 5'-0" A.F.F.

GODWIN + ASSOCIATES
 architects & engineers
 1200 Lake Woodhurst, D-100 • Springfield • Missouri 65804 • (417) 887-9687 • Fax (417) 887-9215



Revisions

1. 05.07.19	OWNER REVIEW COMMENTS
2. 05.30.19	OWNER REVIEW COMMENTS

SPECIAL NOTICE: In the event the client consents to, allows, authorizes or approves of changes to any plans, specifications or other construction documents, and these changes are not approved in writing by the design professional, the client recognizes that such changes and the results thereof are not the responsibility of the design professional. Therefore, the client agrees to release the design professional from any liability arising from the construction, use or result of such changes. In addition, the client agrees to the fullest extent permitted by law, to indemnify and hold the design professional harmless from any damage, liability or cost (including reasonable attorney's fees and costs of defense) arising from such changes.

Copyright © 2019 by GODWIN + ASSOCIATES. All rights reserved. No part of this drawing may be reproduced by photocopy or by any other means, or stored, processed, or transmitted in or by any computer or other systems without the prior written permission of GODWIN + ASSOCIATES.

Project Number: 49034
 Drawn By: PMM
 Reviewed By: JAG
 Date: 04.10.19

True Rest Float Spa
 2995 Cobb Parkway Southeast
 Cobb County, GA 30339

Interior Finish Plan, Interior Finish Legend & Finish Schedule

CONSTRUCTION DOCUMENTS
 Sheet Number
A2.1